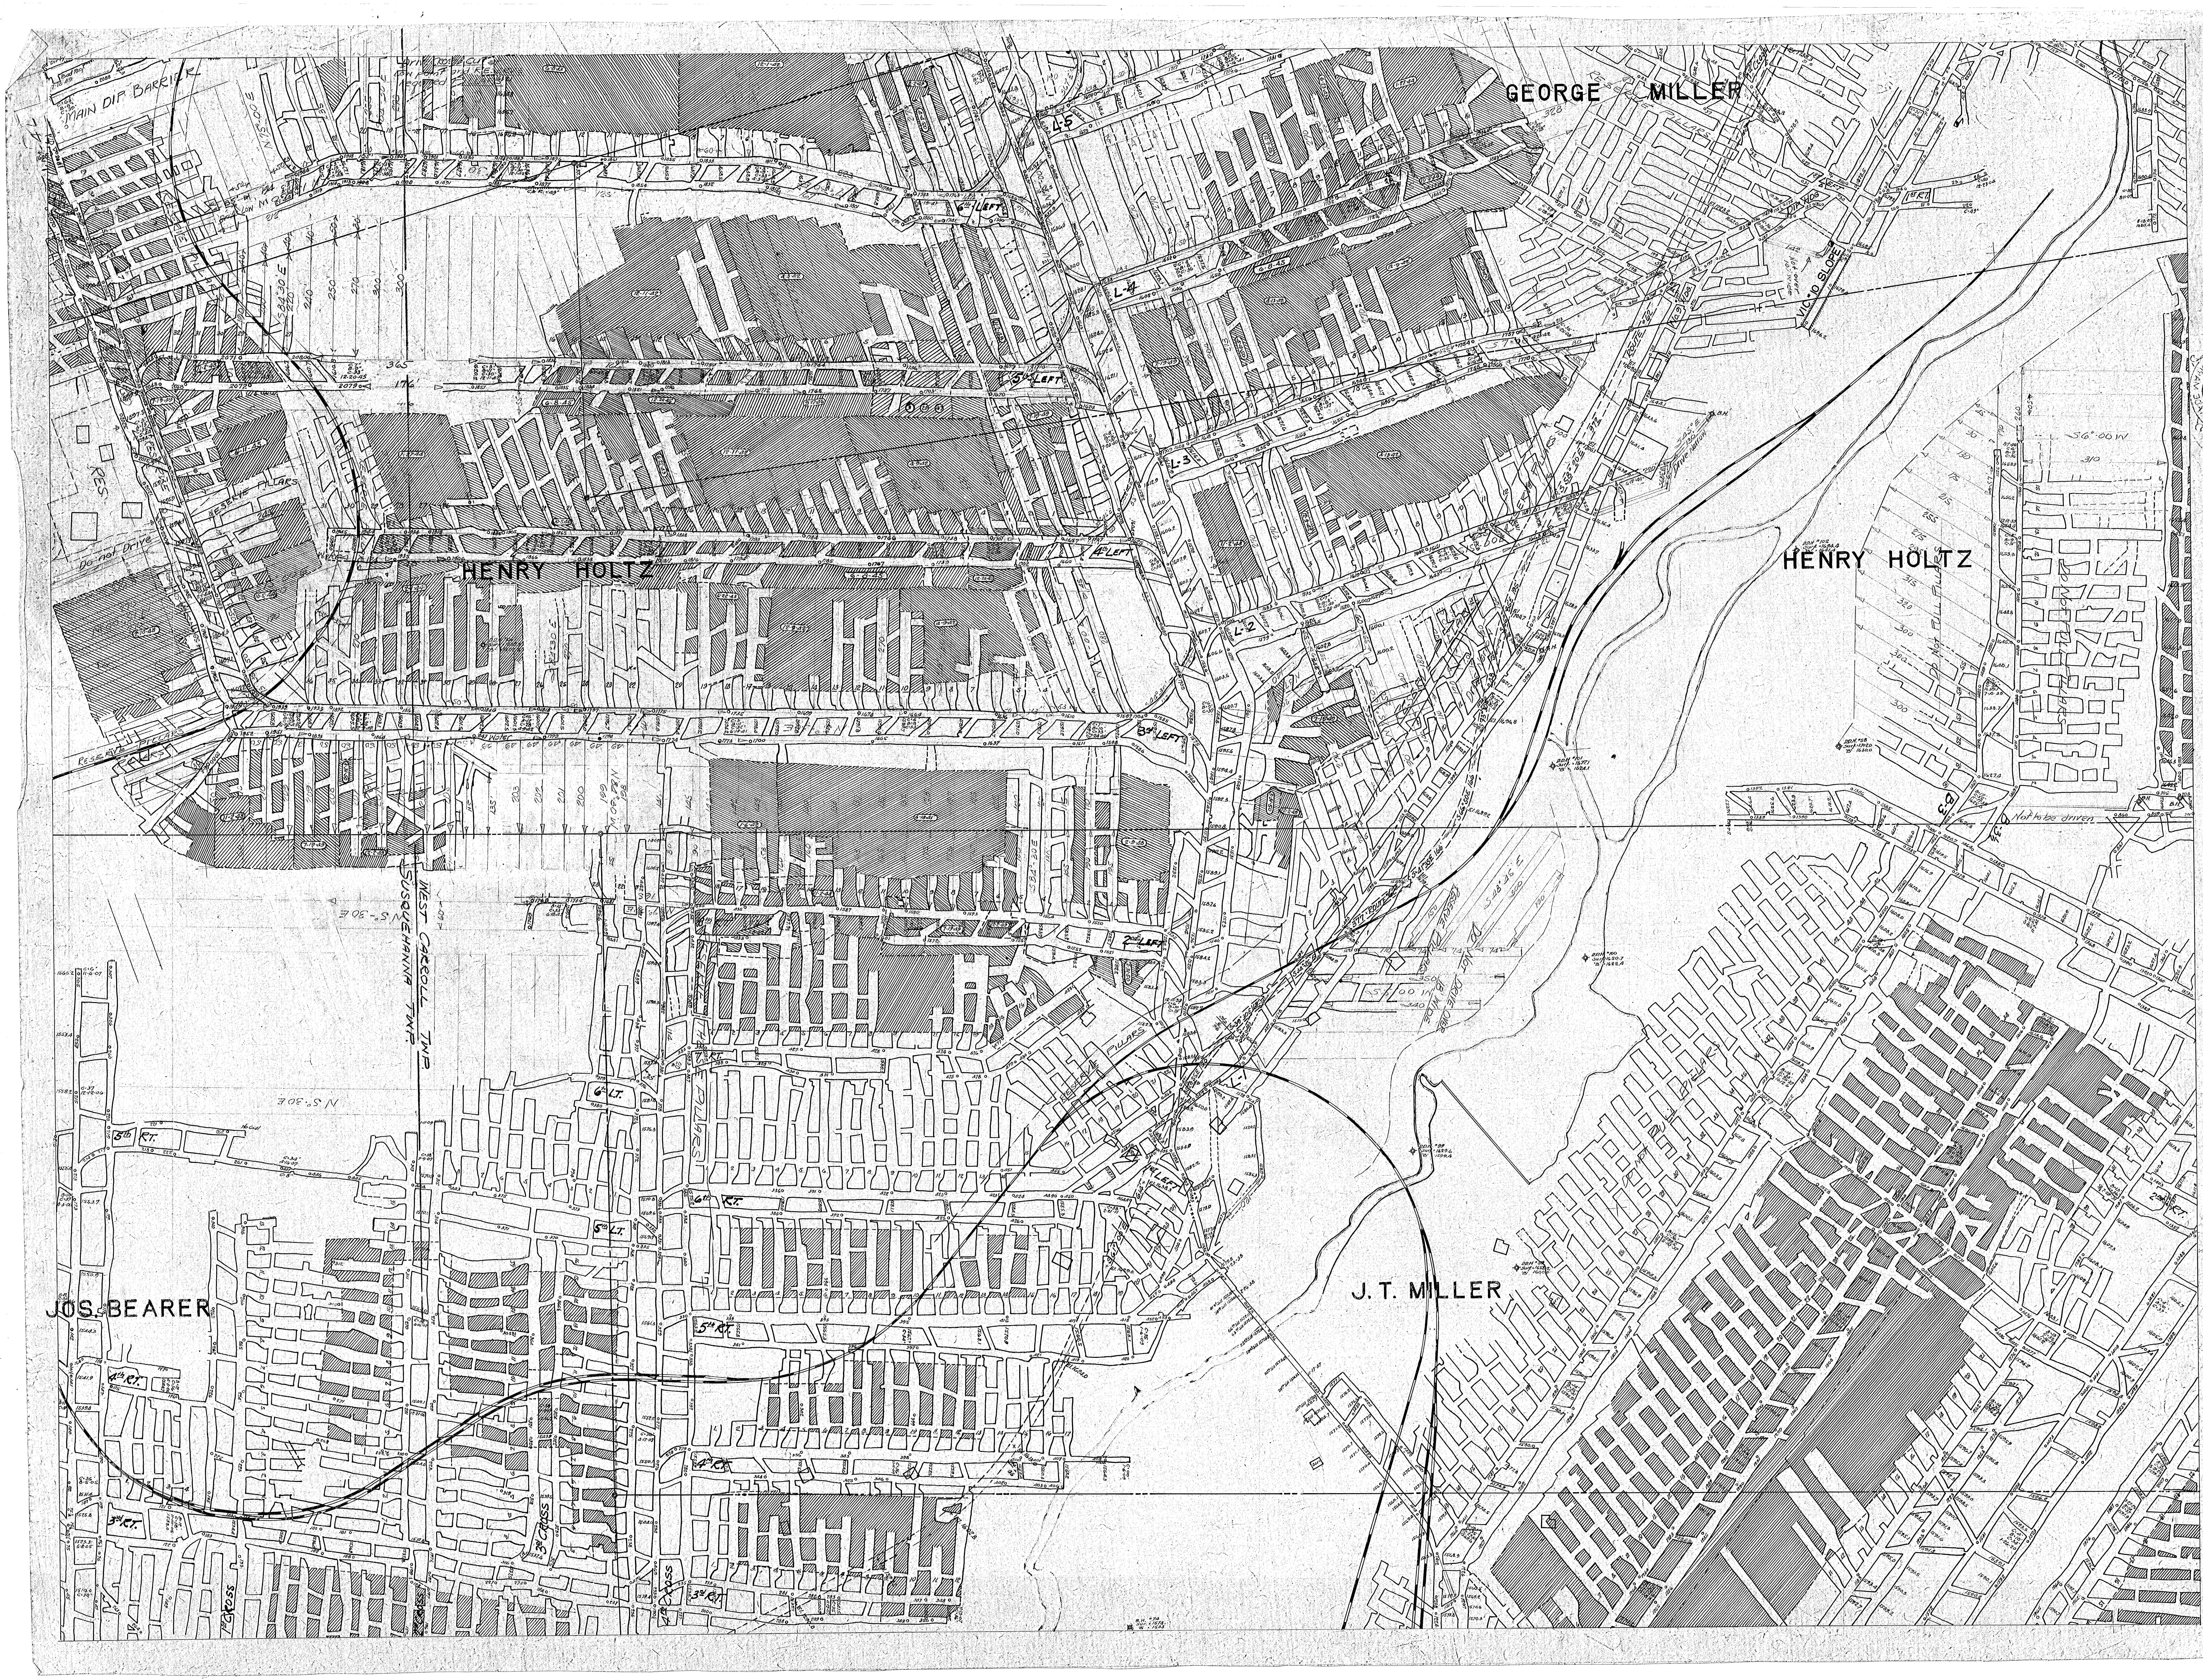
GEORGE MILLER
HENRY HOLTZ
HENRY HOLTZ
J.T. MILLER
JOS. BEARER
MAIN DIP BARRIER
WEST CARROLL TWP.
SUSQUEHANNA TWP.
RESERVE PILLARS
RES.
Do not Drive
L-5
L-4
L-3
L-2
L-1
6th LEFT
5th LEFT
4th LEFT
3rd LEFT
2nd LEFT
1st LEFT
1st LEFT
1st RT.
DIP HOG
VIC. #10 SLOPE
Not over 10' wide
ROUTE #62
No. 9 HDG.
S.45°E
Drive Narrow
S.6°00'W
310
DO NOT PULL PILLARS
B-3
B-32
Not to be driven
S.48°15'E
DO NOT DRIVE OVER 18' WIDE
S.5°00'W
S.84°30'E
N.75°00'E
N.5°30'E
No Coal
6th LT.
5th LT.
7th RT.
6th RT.
5th RT.
4th RT.
3rd RT.
2nd RT.
1st CROSS
3rd CROSS
4th CROSS
D.D.H. #101 Surf. 1677.1 'B' 1624.1
D.D.H. #102 Surf. 1694.4 'B' 1631.4
D.D.H. #58 Surf. 1702.0 'B' 1630.0
D.D.H. #99 Surf. 1629.6 'B' 1599.4
D.D.H. #100 Surf. 1650.7 'B' 1622.4
B.H. #74