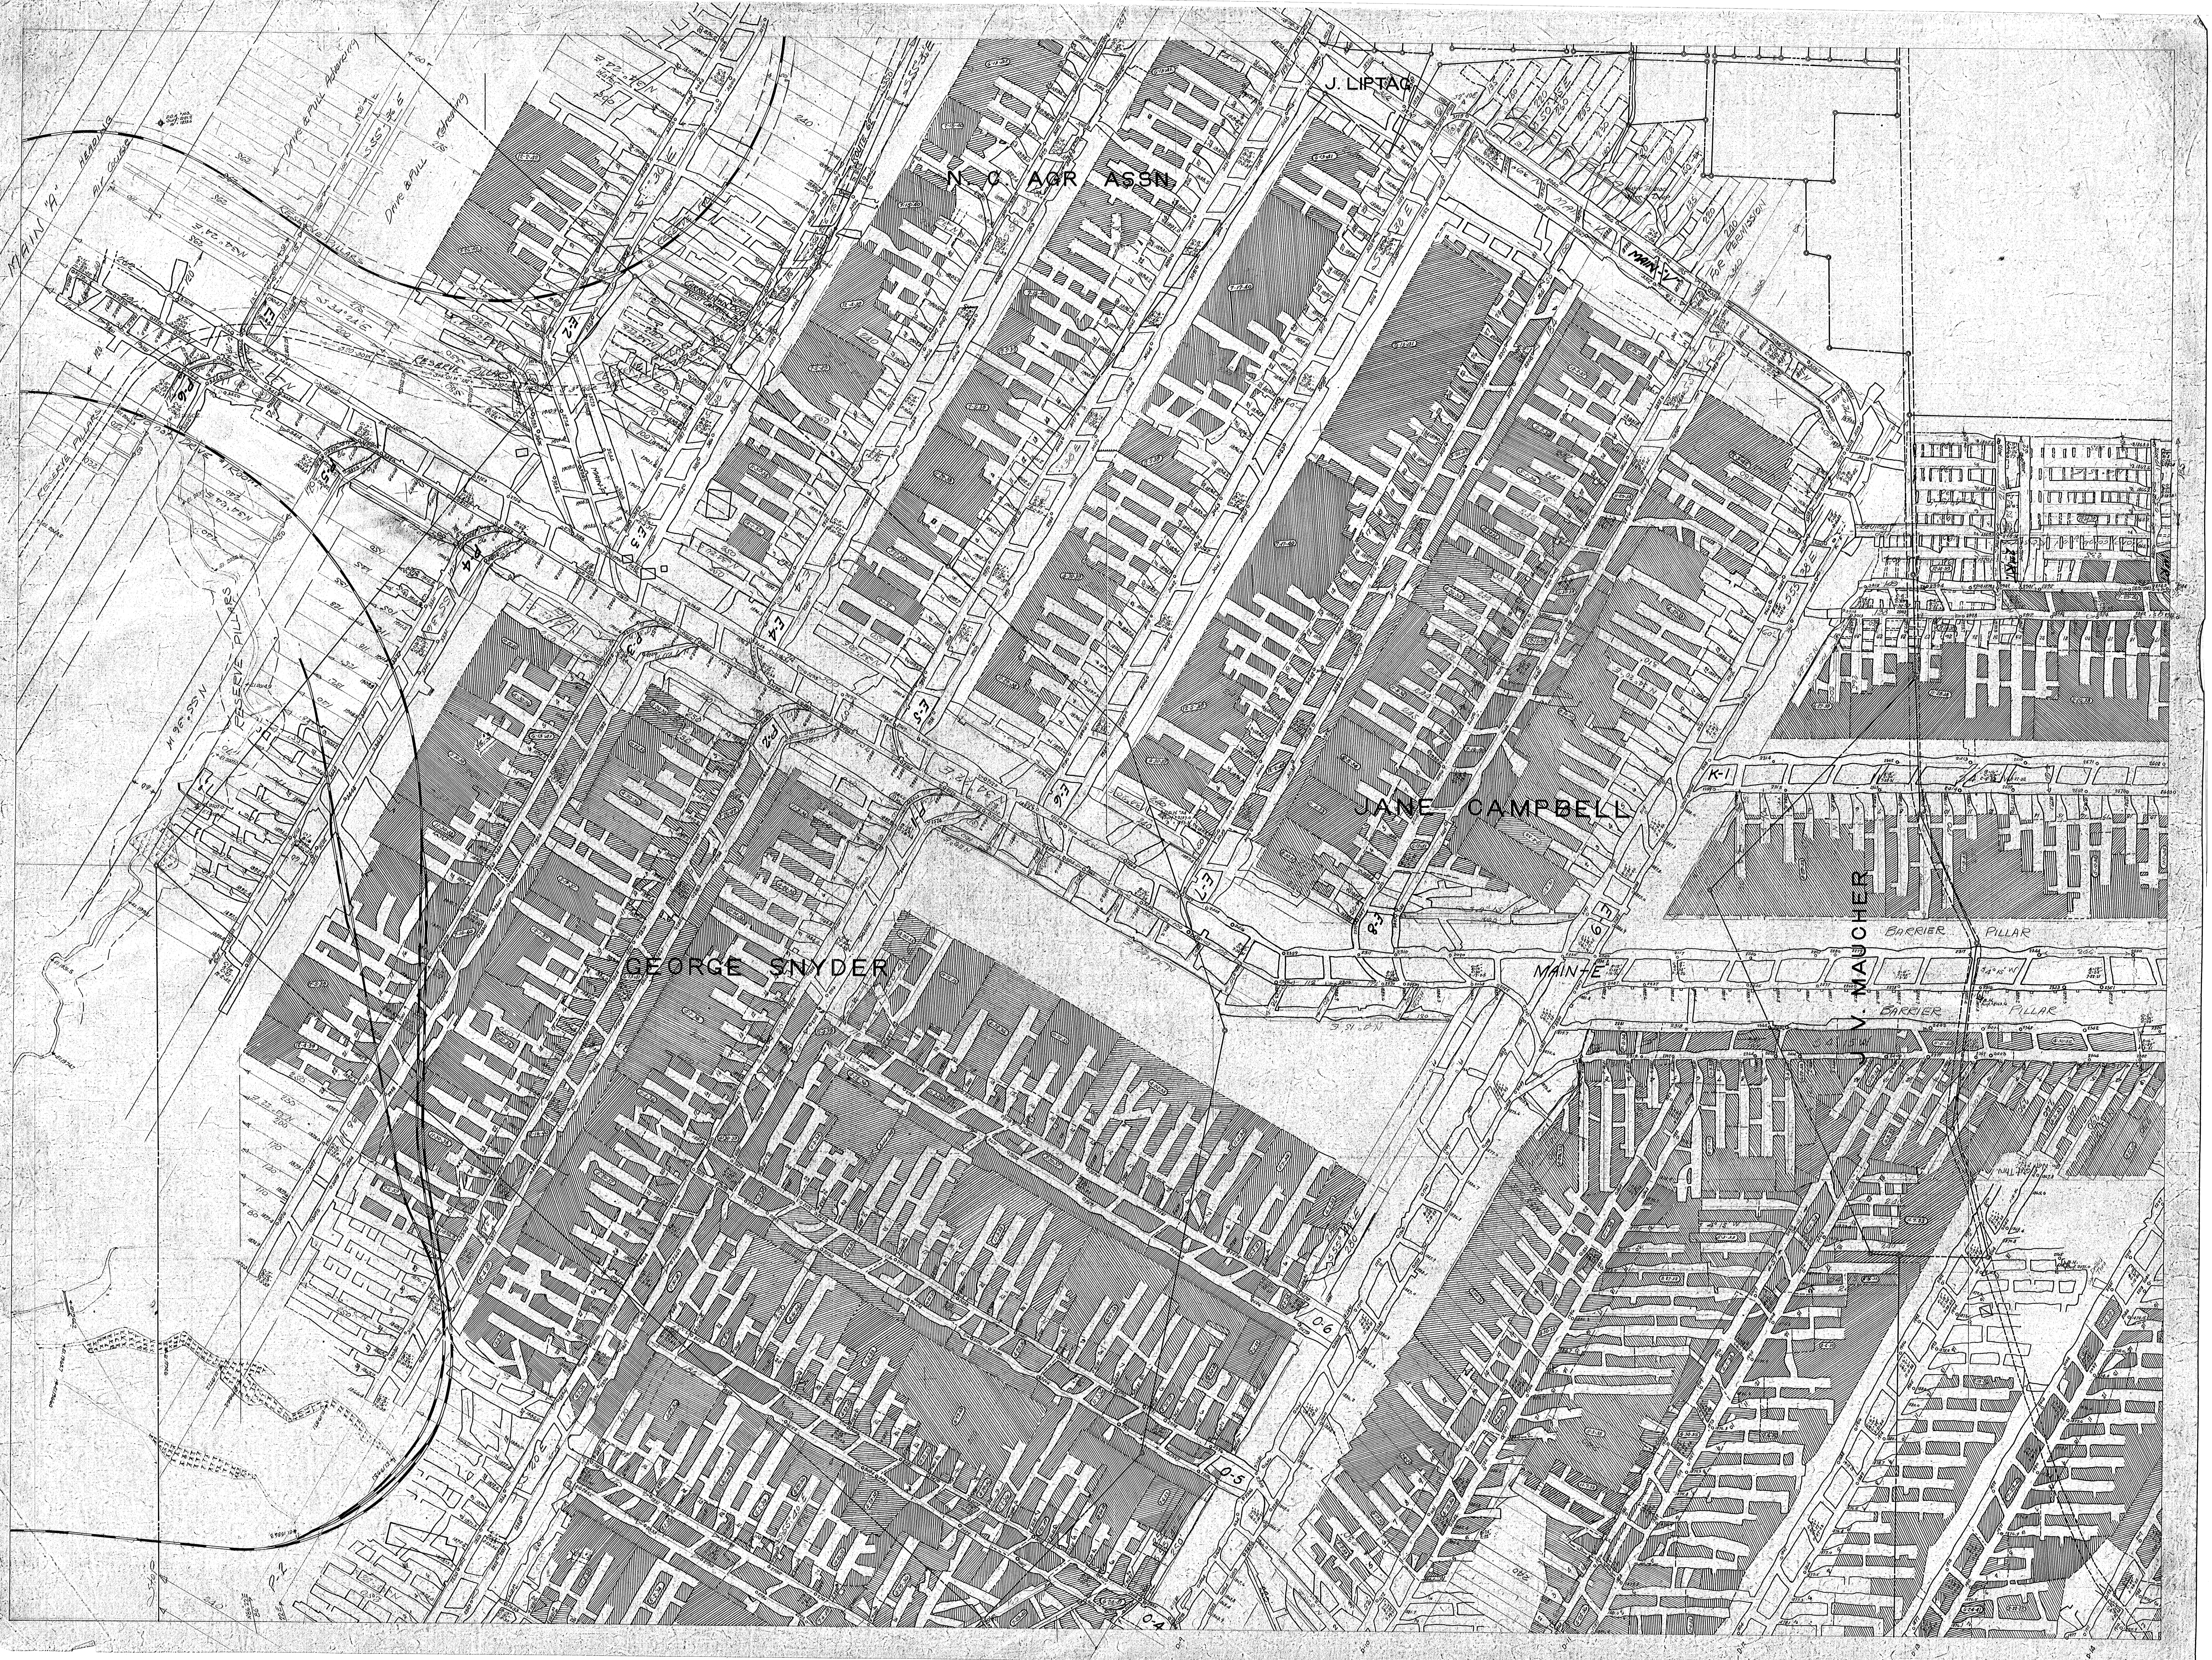
MAIN "A" HEADING
Air Course
Drive & Pull Advancing
Drive & Pull Retreating
S55°36'E
N34°24'E
RESERVE PILLARS
DRIVE ROOM
N. C. AGR ASSN
J. LIPTAG
MAIN-"V"
FOR PERMISSION
JANE CAMPBELL
GEORGE SNYDER
J. V. MAUCHER
BARRIER PILLAR
MAIN-E
BARRIER PILLAR
K-1
E-1
E-2
E-3
E-4
E-5
E-6
E-7
E-8
P-2
P-3
P-4
P-5
P-6
O-4
O-5
O-6
