


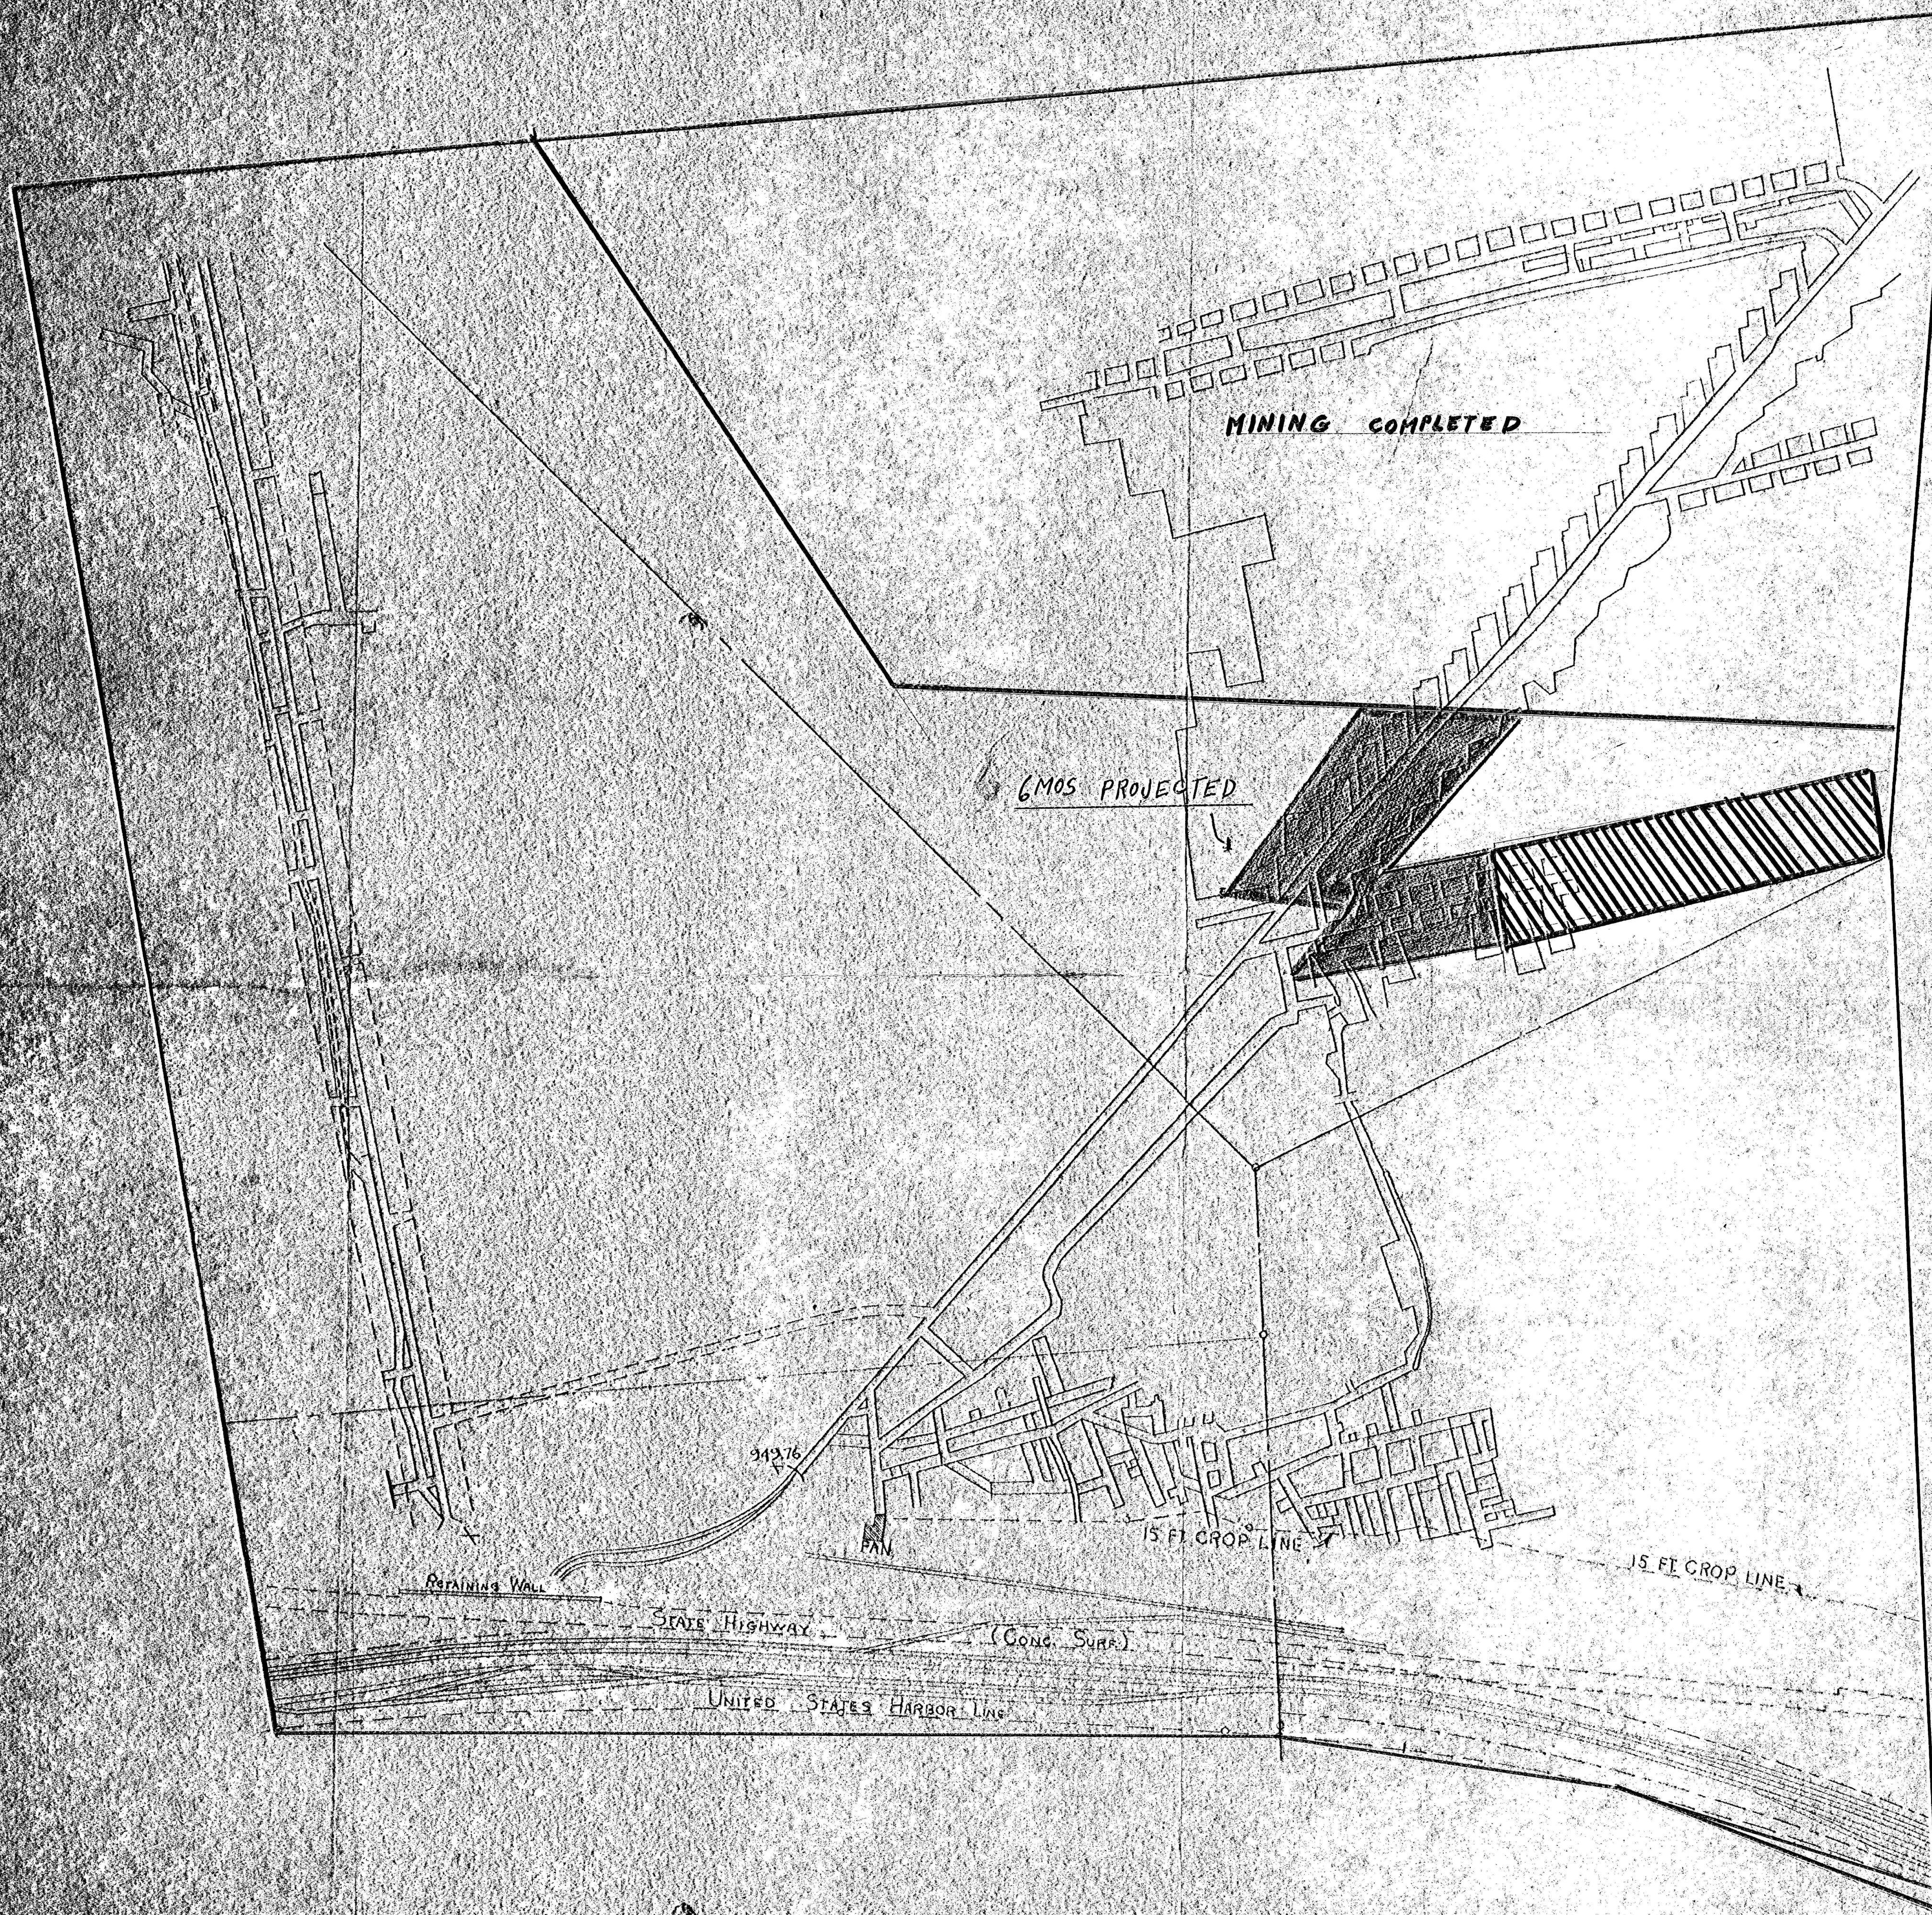

LEASE LINE
 MINING COMPLETED
 6 MOS. PROJECTED
 12/2/67 to 6-2-68

RECD.
 DEC 8 1967
 DEPT. OF REVENUE
 PENNA. DEPT. OF REVENUE

DRAWN	R. B. M.	12/2/67
CHECKED		
APPROVED		
REVISIONS		

A & W COAL COMPANY

MCDONALD ASSOCIATES ENGINEERING
 CHARLOTTE, PA.

SCALE 1" = 100'
 JOB 1532
 SHEET No. 6