


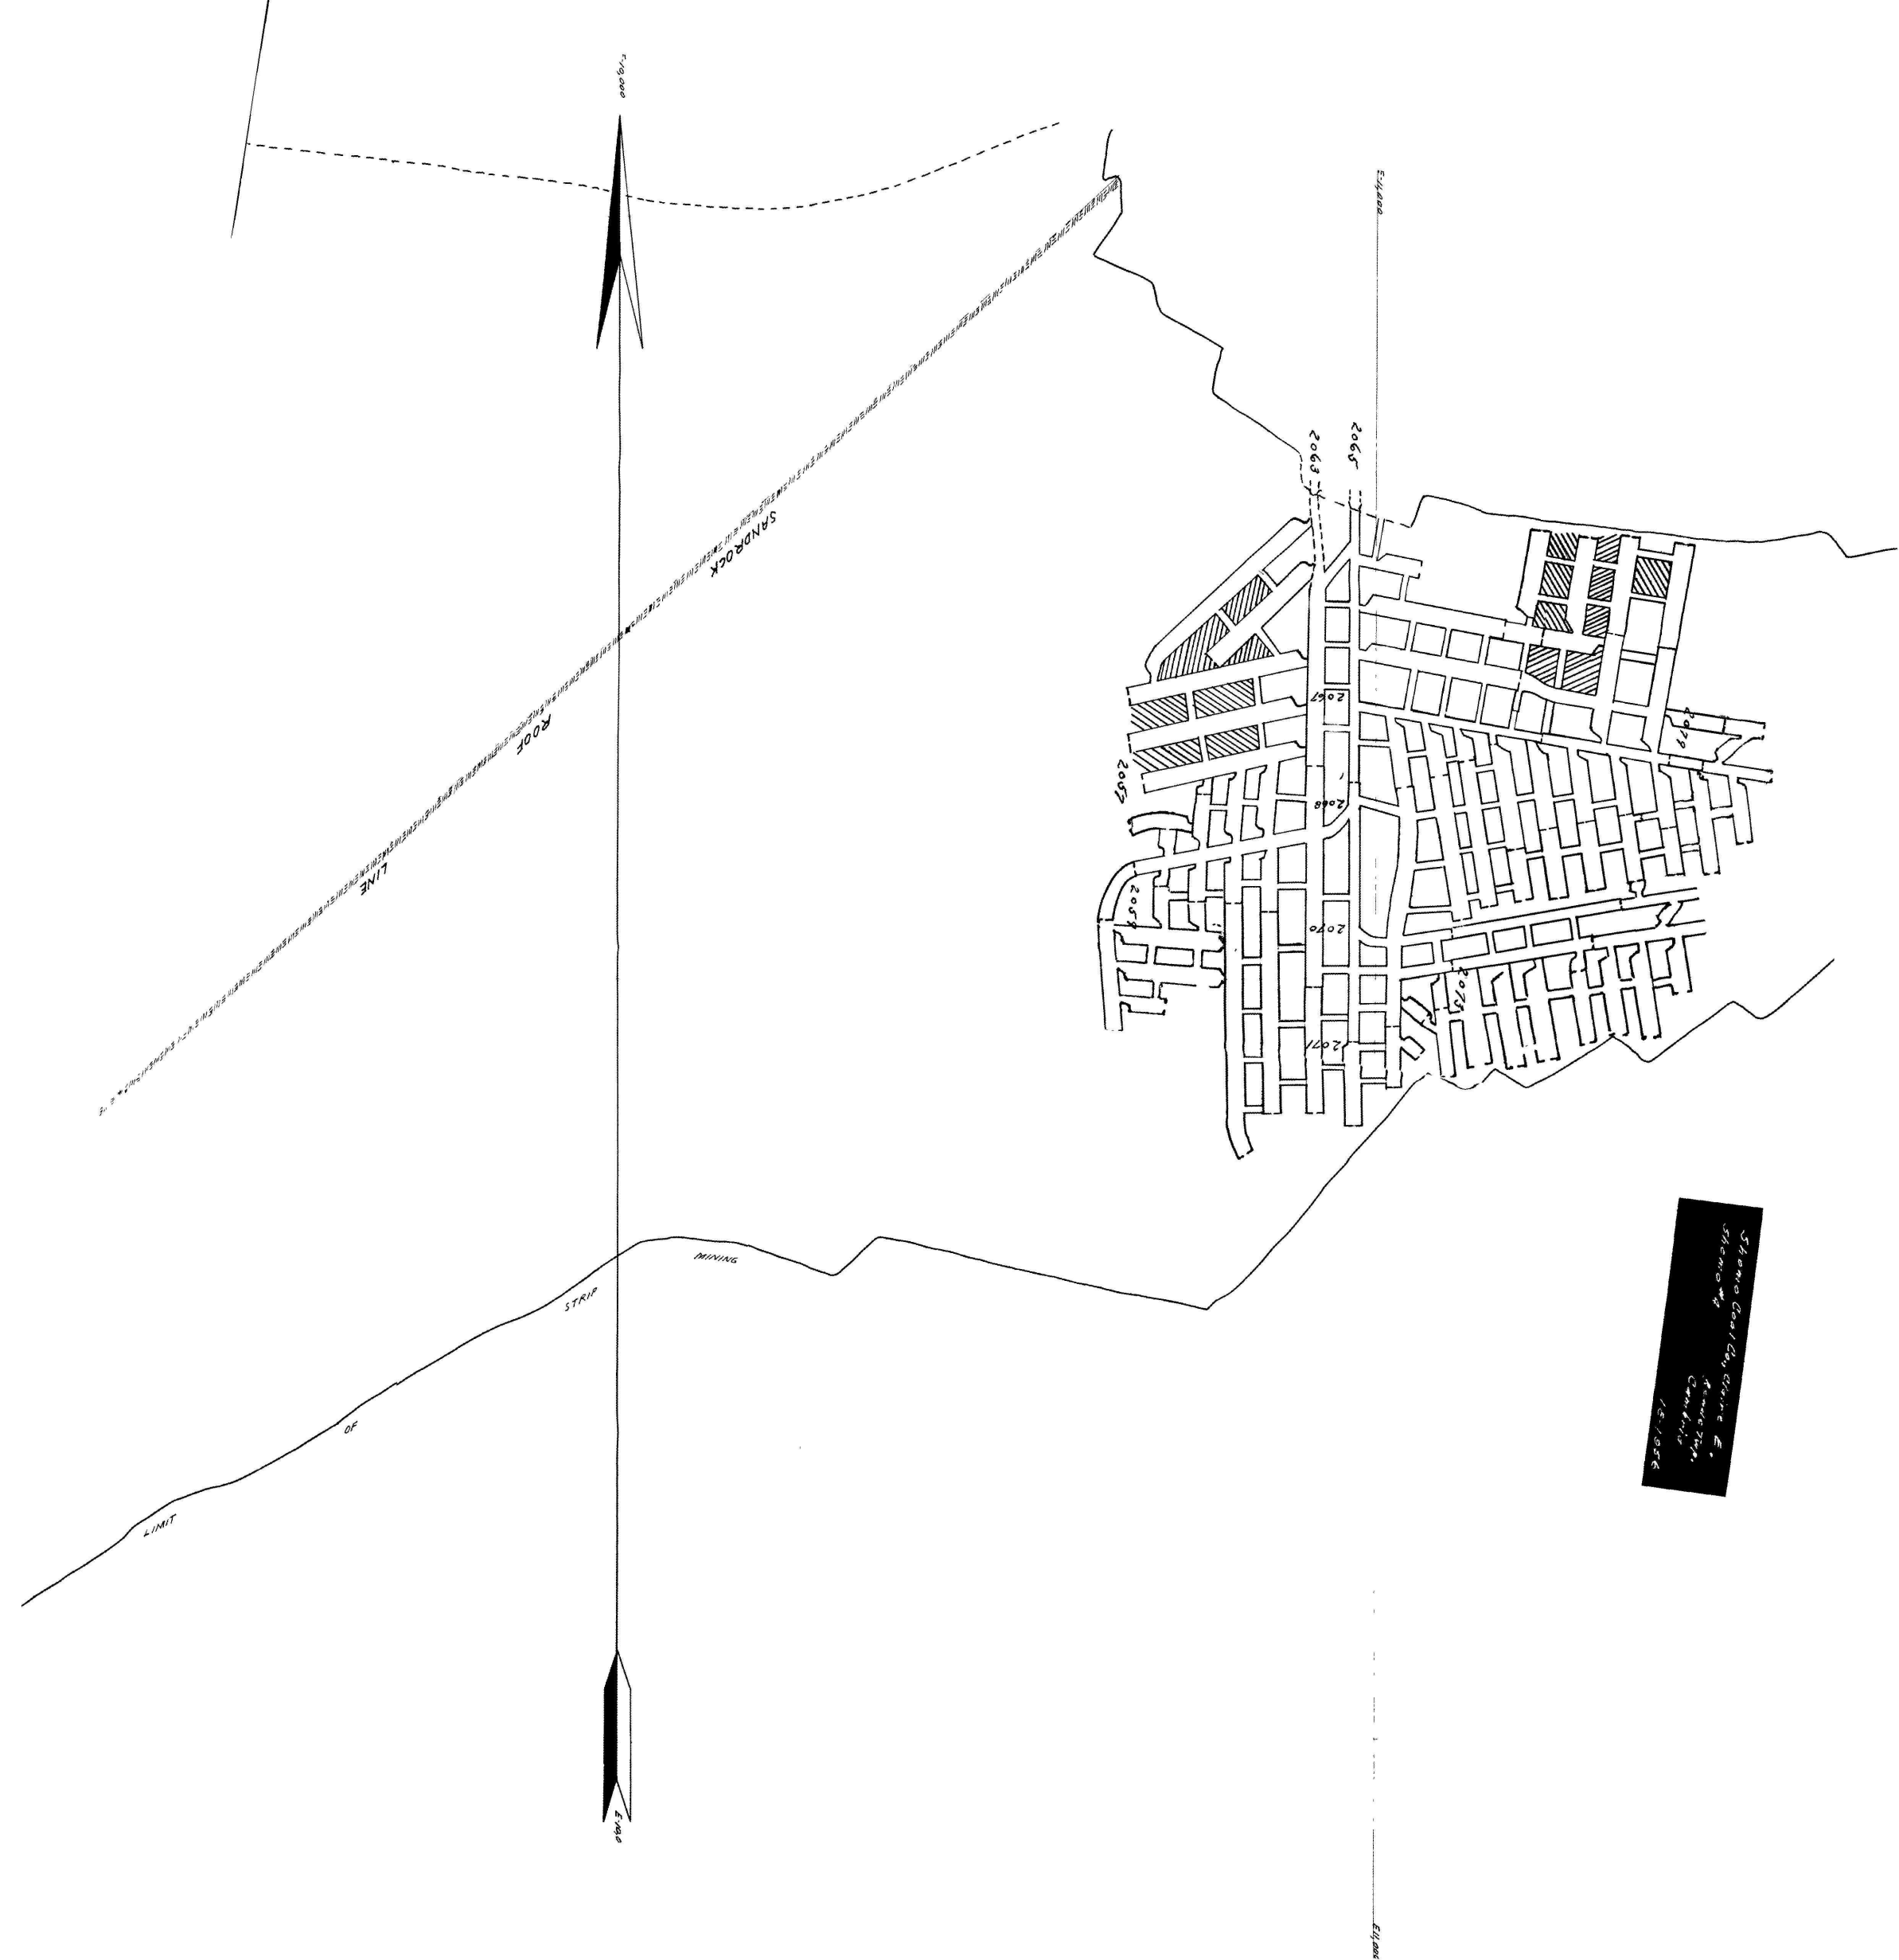

Shono Coal Co. Mine E.
Shono W.
15/1956