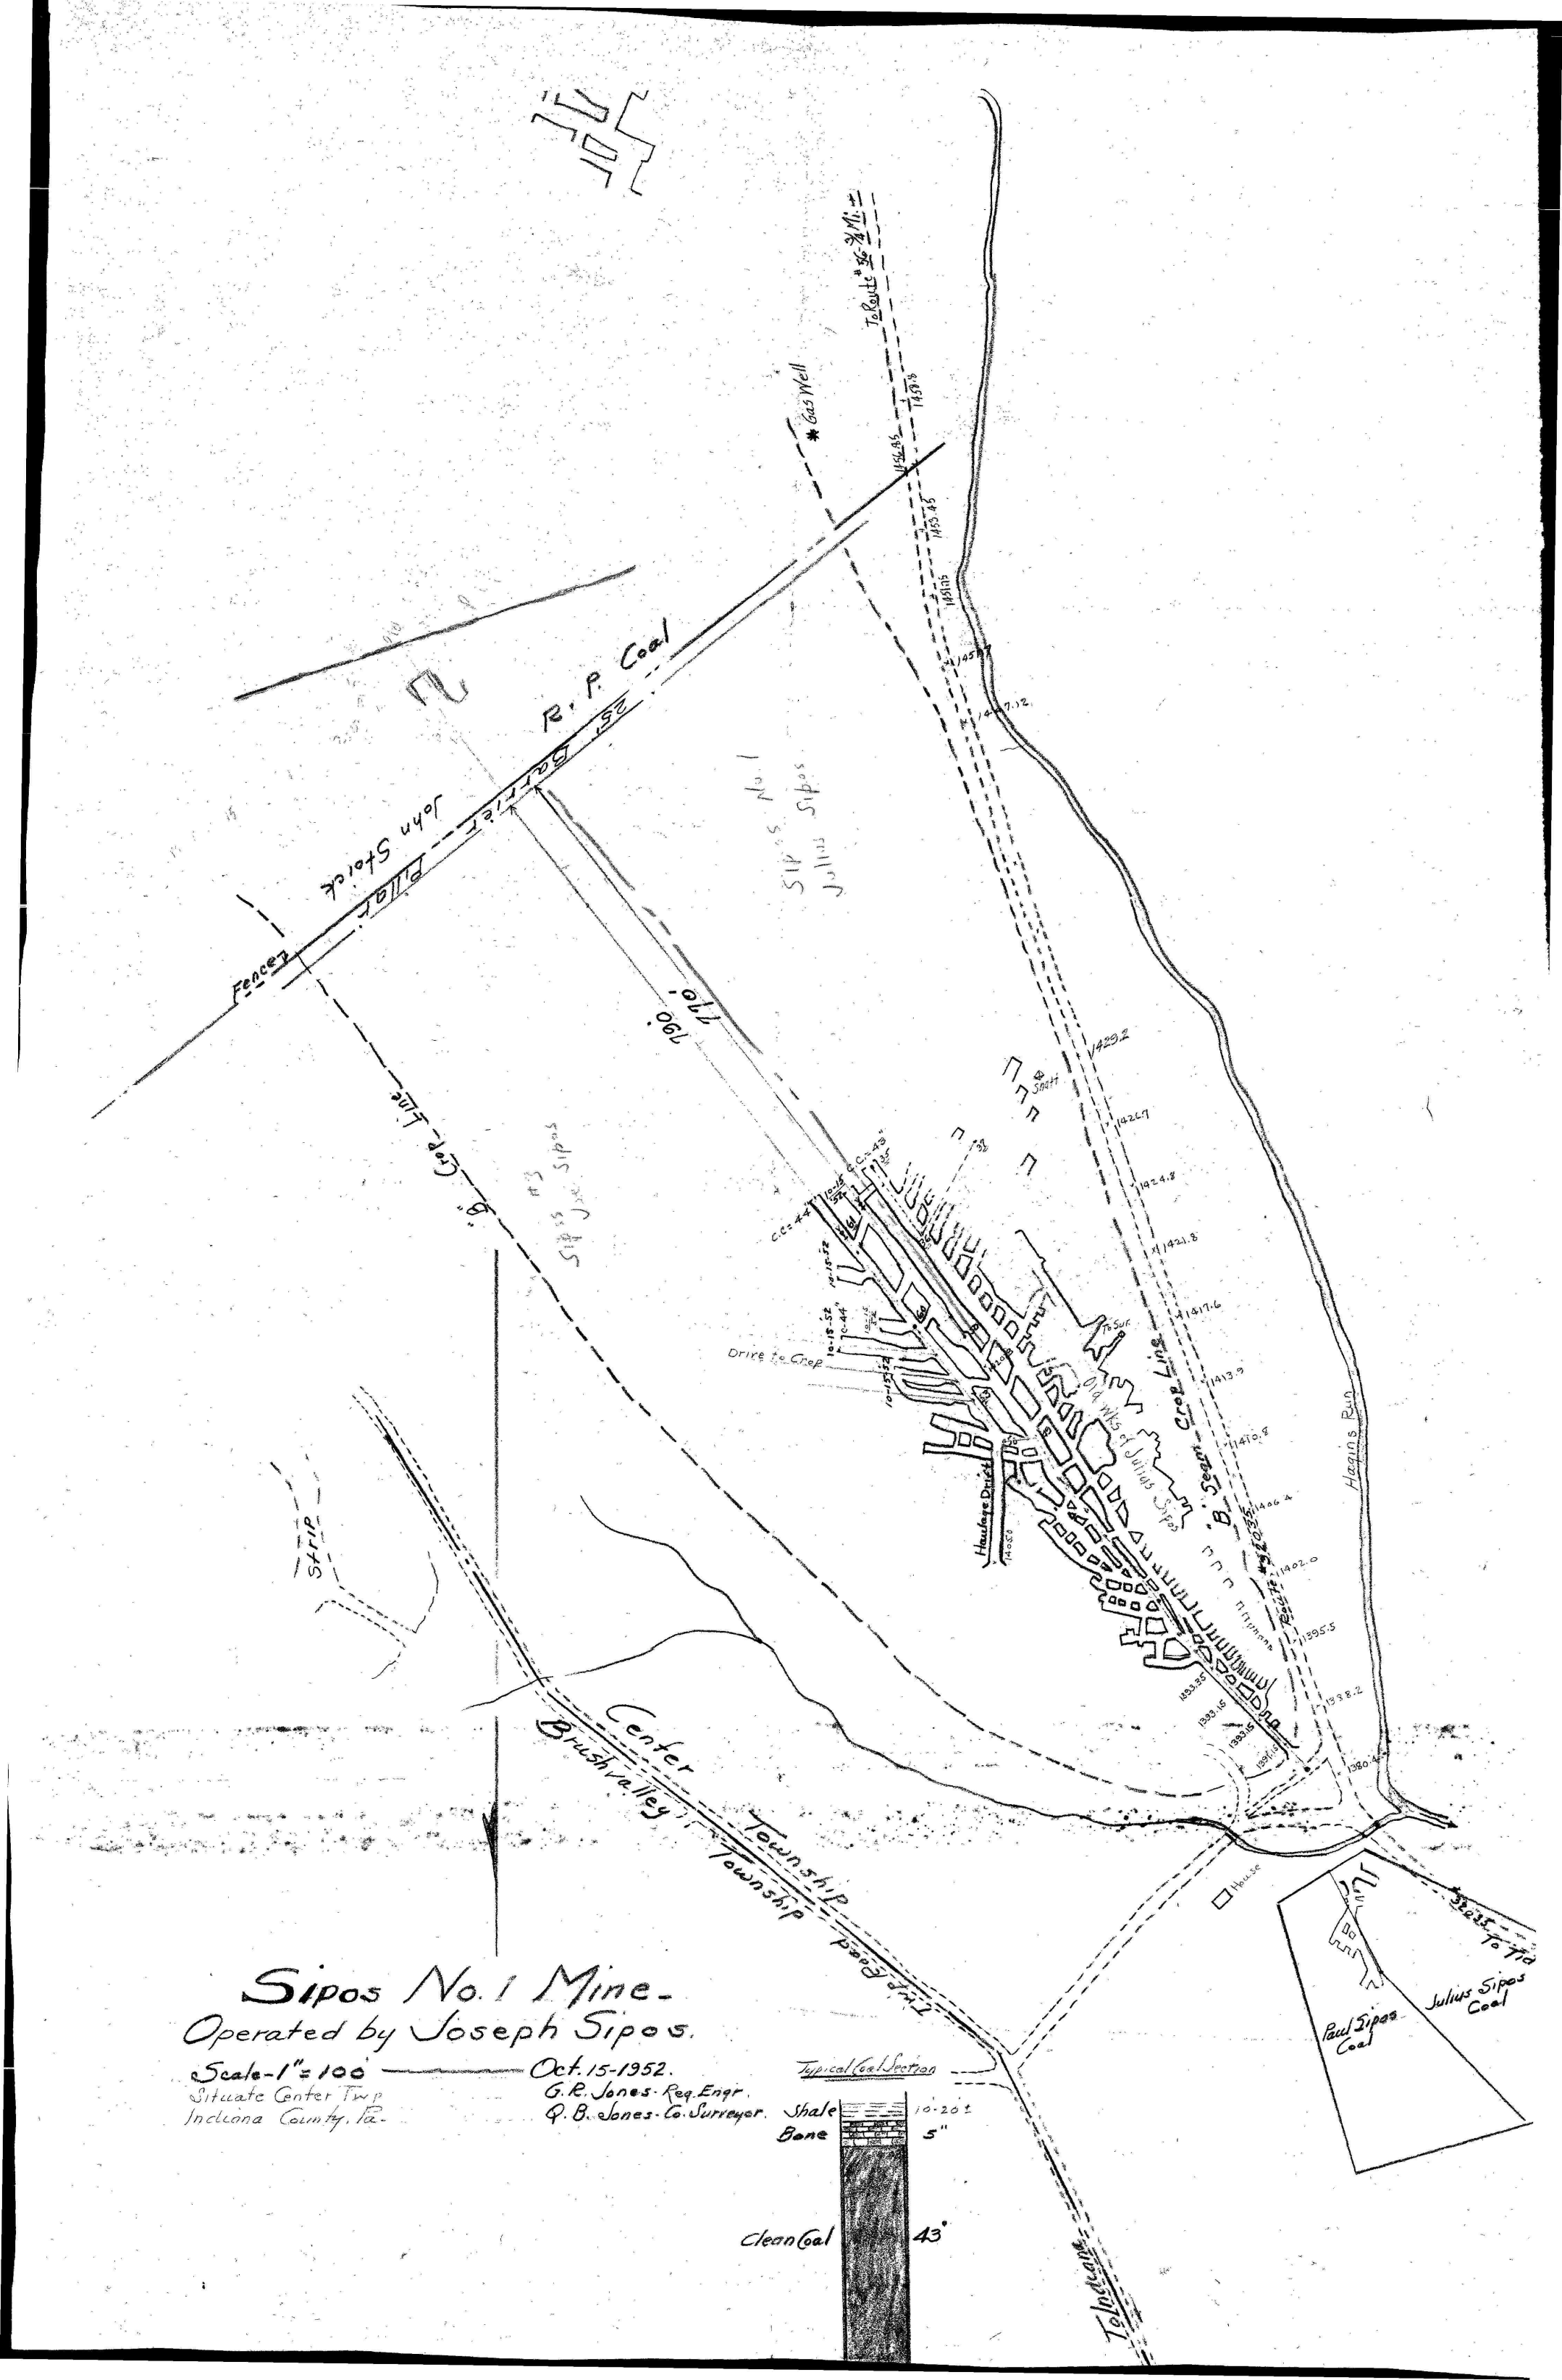
Sipos No. 1 Mine-
Operated by Joseph Sipos.
Scale-1" = 100'
Situate Center Twp
Indiana County, Pa.
Oct. 15-1952.
G. R. Jones - Reg. Engr.
Q. B. Jones - Co. Surveyor.
Typical Coal Section
Shale 10'-20'±
Bone 5"
Clean Coal 43"
To Indiana
Center Township
Brushvalley Township
Fire Road
Hagins Run
Julius Sipos Coal
Paul Sipos Coal
House
To Tip
"B" Seam Crop Line
Haulage Drift
Old Wks of Julius Sipos
Drive to Crop
Gas Well
To Route #56 - 3/4 Mi.
R. P. Coal
John Stolck
Pillar
Fence
190'
110'
Slip of Sipos No. 1
Slip of Sipos #3
Strip
Shaft
To Sur.