

B.M.- ON CONC AT RT. SIDE OF DOOR
AT ENTRANCE TO FAN HOUSE.
ELEV- 1000.0 ASSUMED.

FORMERLY CAMBRIA IRON CO.

334.5'

N. 84°15' W.

N. 5°45' E.

4308.0'

MAGNETIC MERIDIAN
1959


CAVED WORKINGS
(OLD WORKINGS)

ELEV TOP ENT- 1005.8'
ELEV BOT ENT- 1001.0'

FAN HOUSE

CAVED WORKINGS
(OLD WORKINGS)

ELEV EDGE STREAM
982.3'

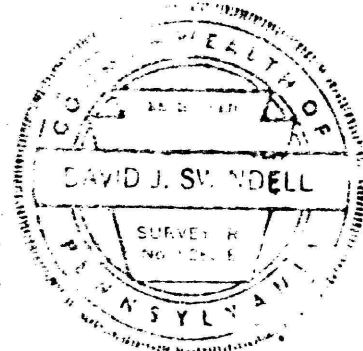

MAP

OF COAL MINE LEASED BY
JAMES I. & NETTIE V. SMITH
SITUATE IN
CLEARFIELD TOWNSHIP, CAMBRIA COUNTY
PENNSYLVANIA
SURVEYED SEPTEMBER 5, 1959
SCALE- 1"=100' *David J. Sundell*
REG. SURVEYOR

1055.8
S. 15°15' W.
CLEARFIELD CREEK