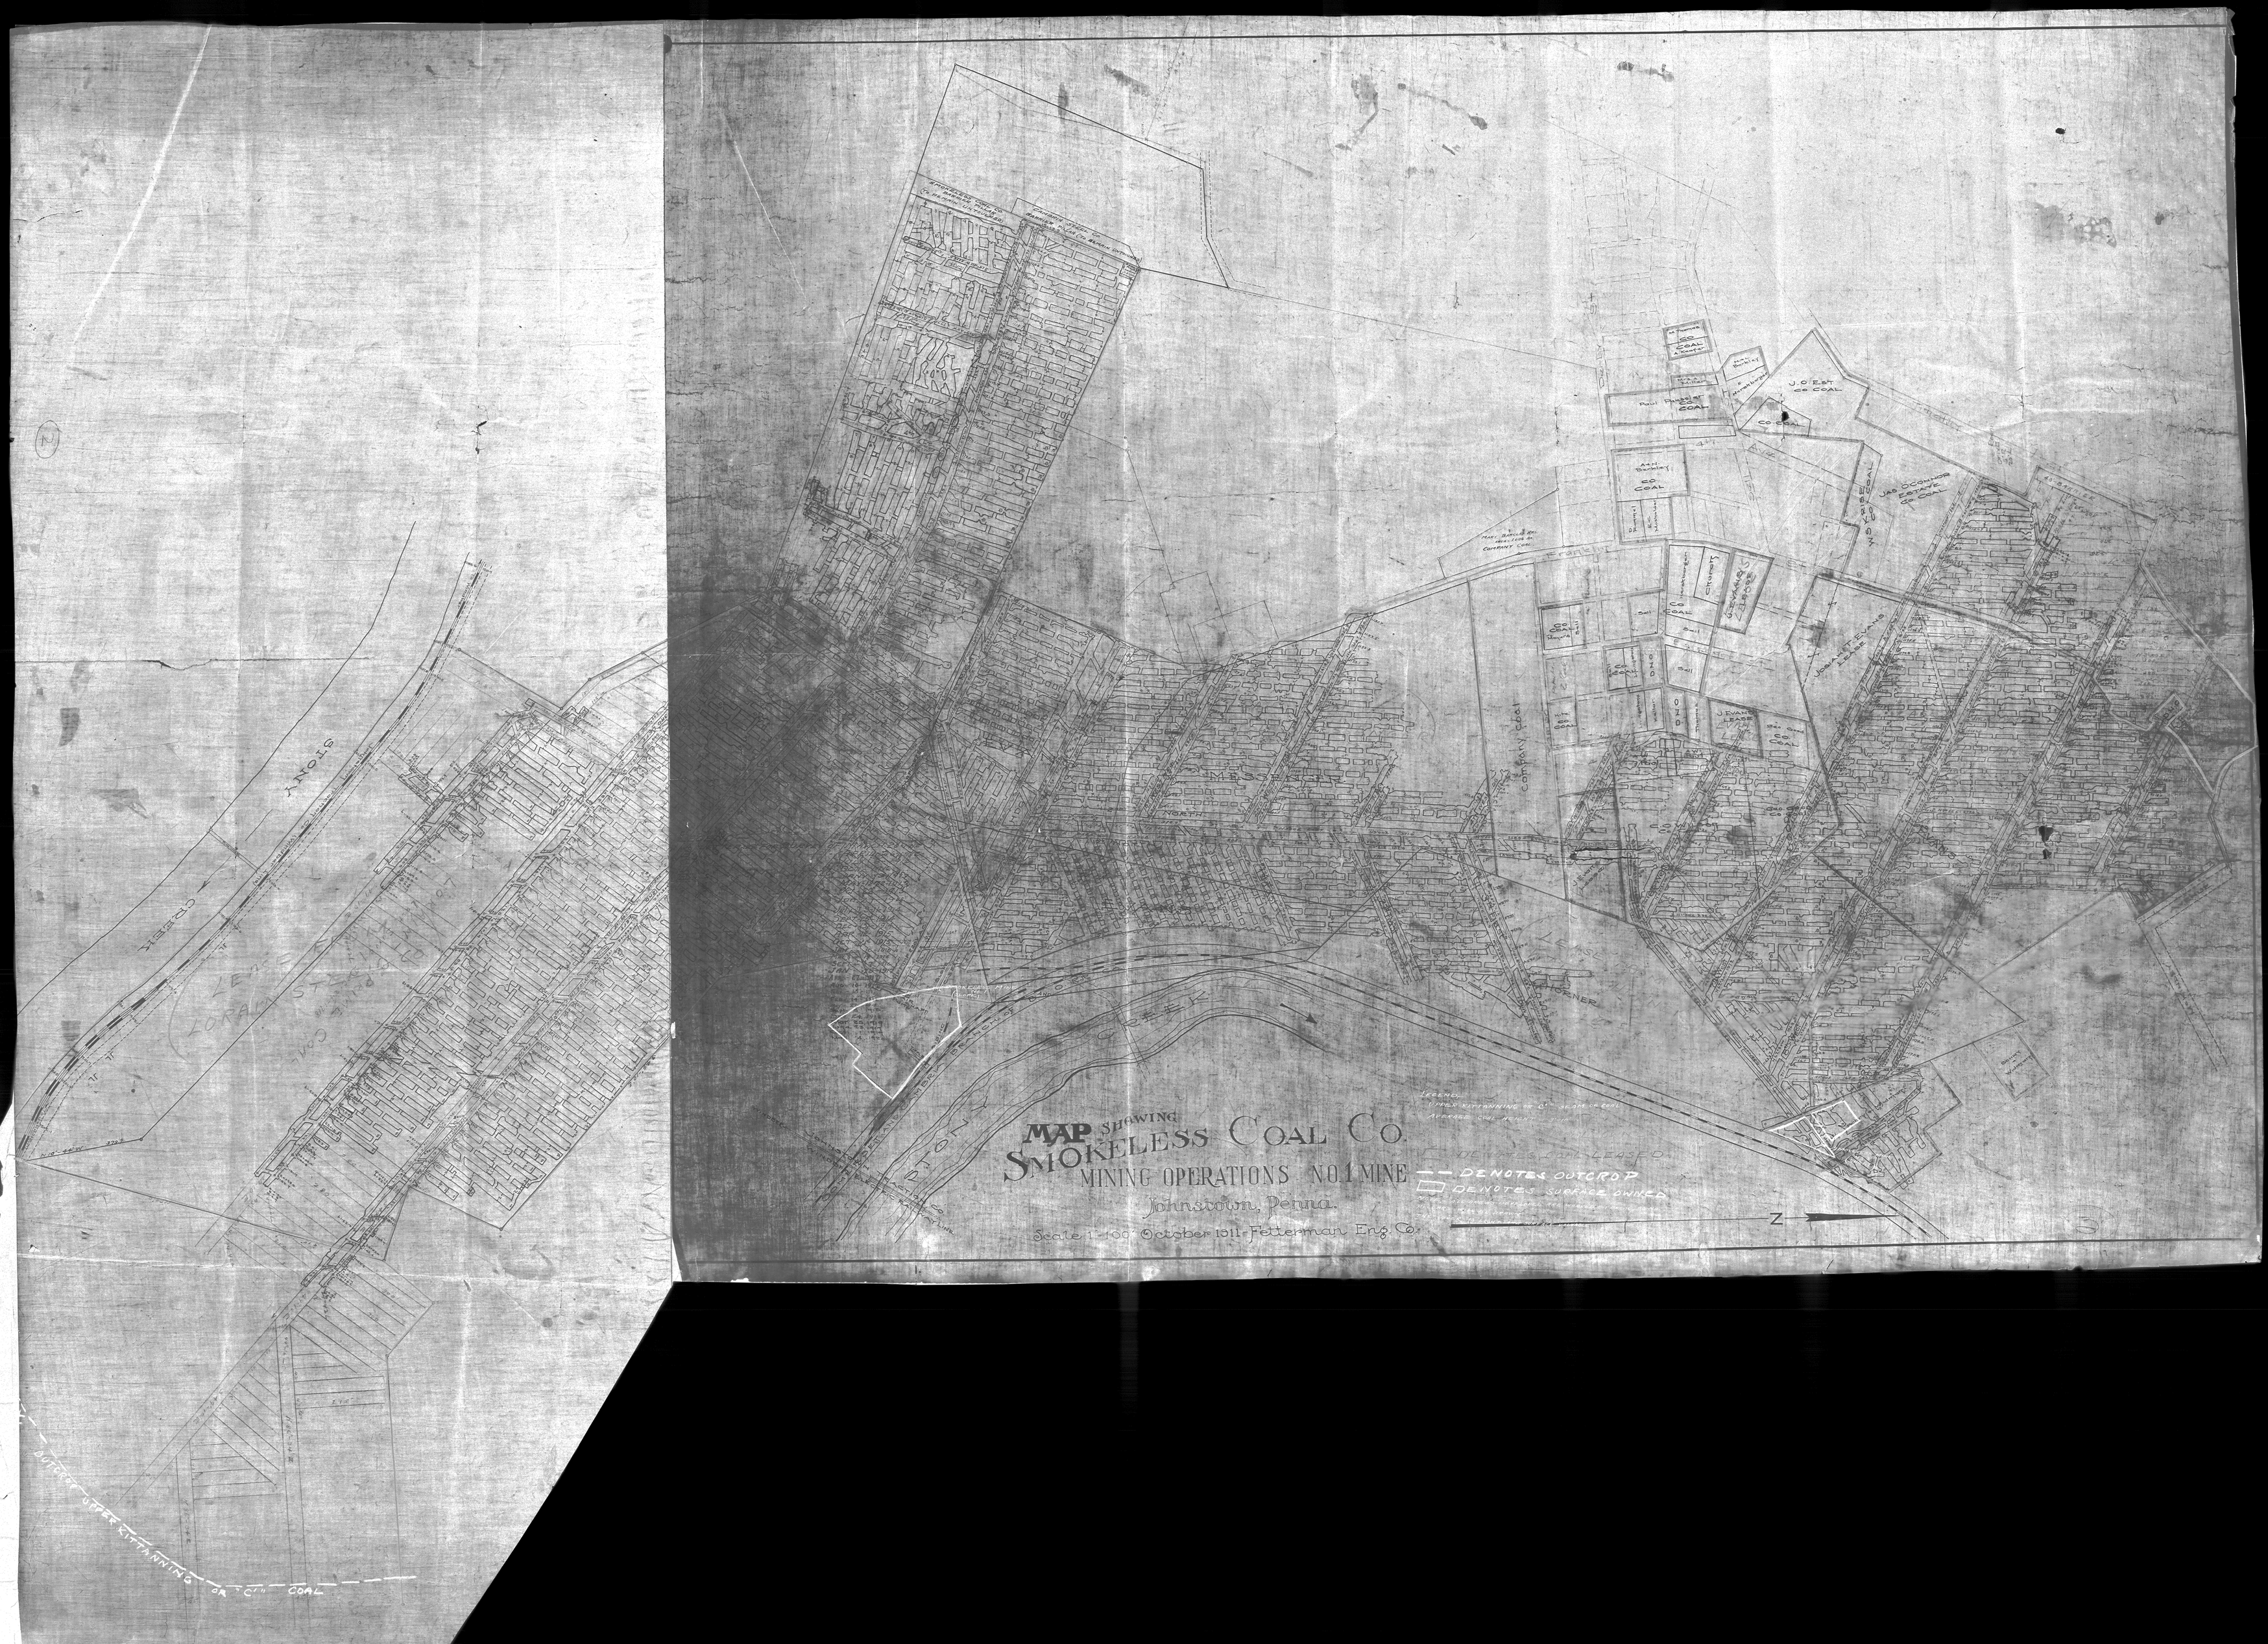
MAP SHOWING
SMOKELESS COAL CO.
MINING OPERATIONS NO.1 MINE
Johnstown, Penna.
Scale 1"=100' October 1911 - Fetterman Eng. Co.
DENOTES COAL LEASED
DENOTES OUTCROP
DENOTES SURFACE OWNED
LEGEND
UPPER KITTANNING OR "C" SEAM OF COAL
AVERAGE COAL HEIGHT
Company Coal
J. O'EST CO COAL
CO COAL
J. EVANS LEASE
JOSIANET EVANS LEASE
CREEK
STONY
OUTCROP UPPER KITTANNING OR "C" COAL