

TRACT NO. 1067
WILMORE COAL CO. SURF
WILMORE COAL CO. SURF
WILMORE COAL CO. SURF

TRACT NO. 1068

WILMORE COAL CO. - MIN
THERESA M. WALKER - SURF

THERESA M. WALKER
RESERVATION

RUSSEL M. PILE ETAL. MIN
THERESA M. WALKER SURF

RUSSEL M. PILE ETAL. MINERAL
DENISE COAL CO. SURFACE

LEGEND

- #865 PROPERTY LINE
- #846 MINING COMPLETED
- #864 6 MONTHS ADVANCE 8-1-64 to 2-1-70



EVERETT SNYDER

MINE NO. 18

LOWER FREEPORT SEAM

STONYCREEK TWP SOMERSET CO.




SCALE 1"=100'

SEPT. 13, 1967

V.E. ERICKSON RPE #7074

APRIL 18, 1972

B-4-2

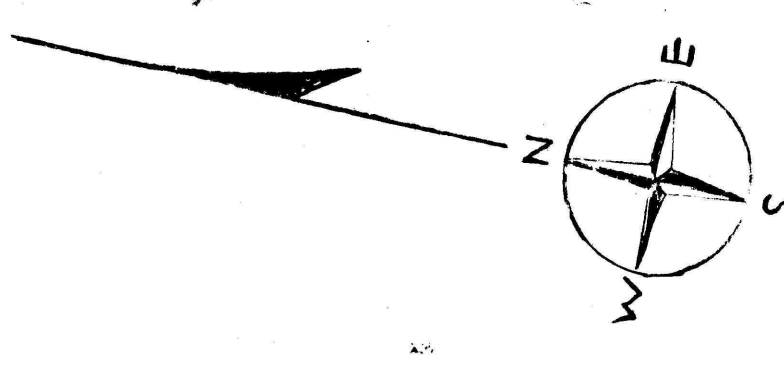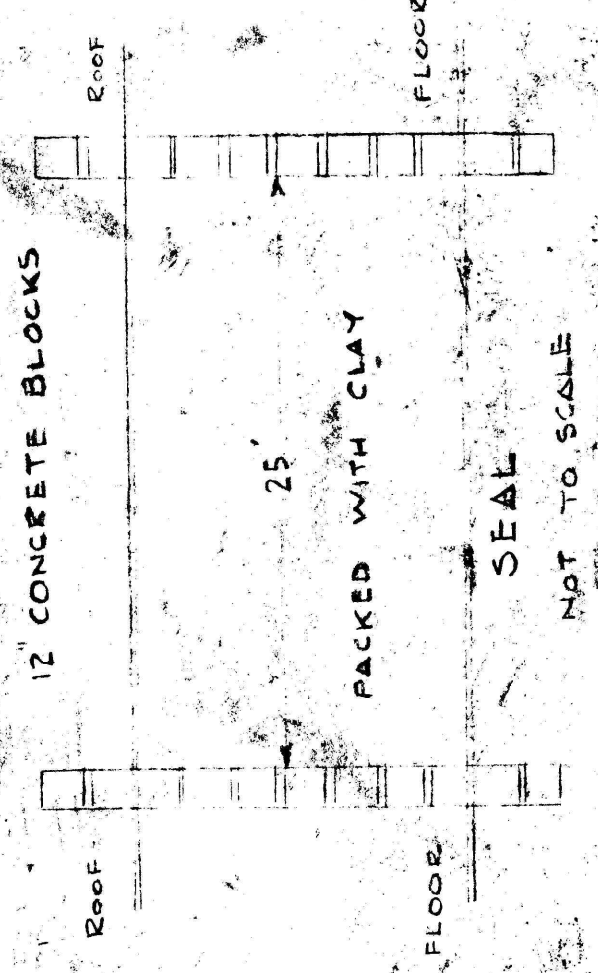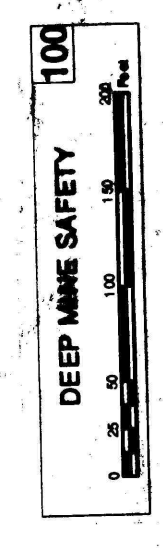

OLD WORKINGS

STRIKE N 65° E
MAX DIP 14%

UNMINED STRATA TO GLADES RUN

STATE HIGHWAY ROUTE 101

1 MI.

HIGH WALK CUT

DIVERSION DITCH

PORTAL

MINING