


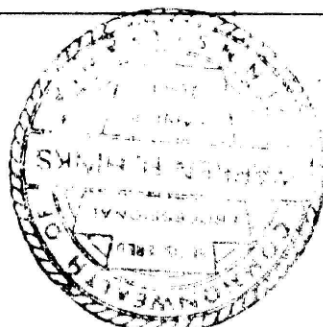

WELLS
BUREAU OF MINES
JUL 27 1967
JOHNSTOWN, PA.

DEEP MINE SAFETY
100

SCALE: 1" = 100' DATE: AUG. 6, 1965

SHADE TOWNSHIP SOMERSET CO.

SITUATE IN

UPPER KITTANNING (C') SEAM

MAP OF SOLAR NO. 3 MINE

HOOVERVILLE, PENNSYLVANIA

SOLAR FUEL COMPANY

POSTED TO

12-31-65
7-1-66
7-1-67

JACOB HORNER
51.70 Ac.
918

S.A. HARTMAN
142.49 Ac.
919

PAUL GALLO LEASE
4 AS. COAL

Solar No. 3
Solar Fuel Co.
7/67

LEASE LINE