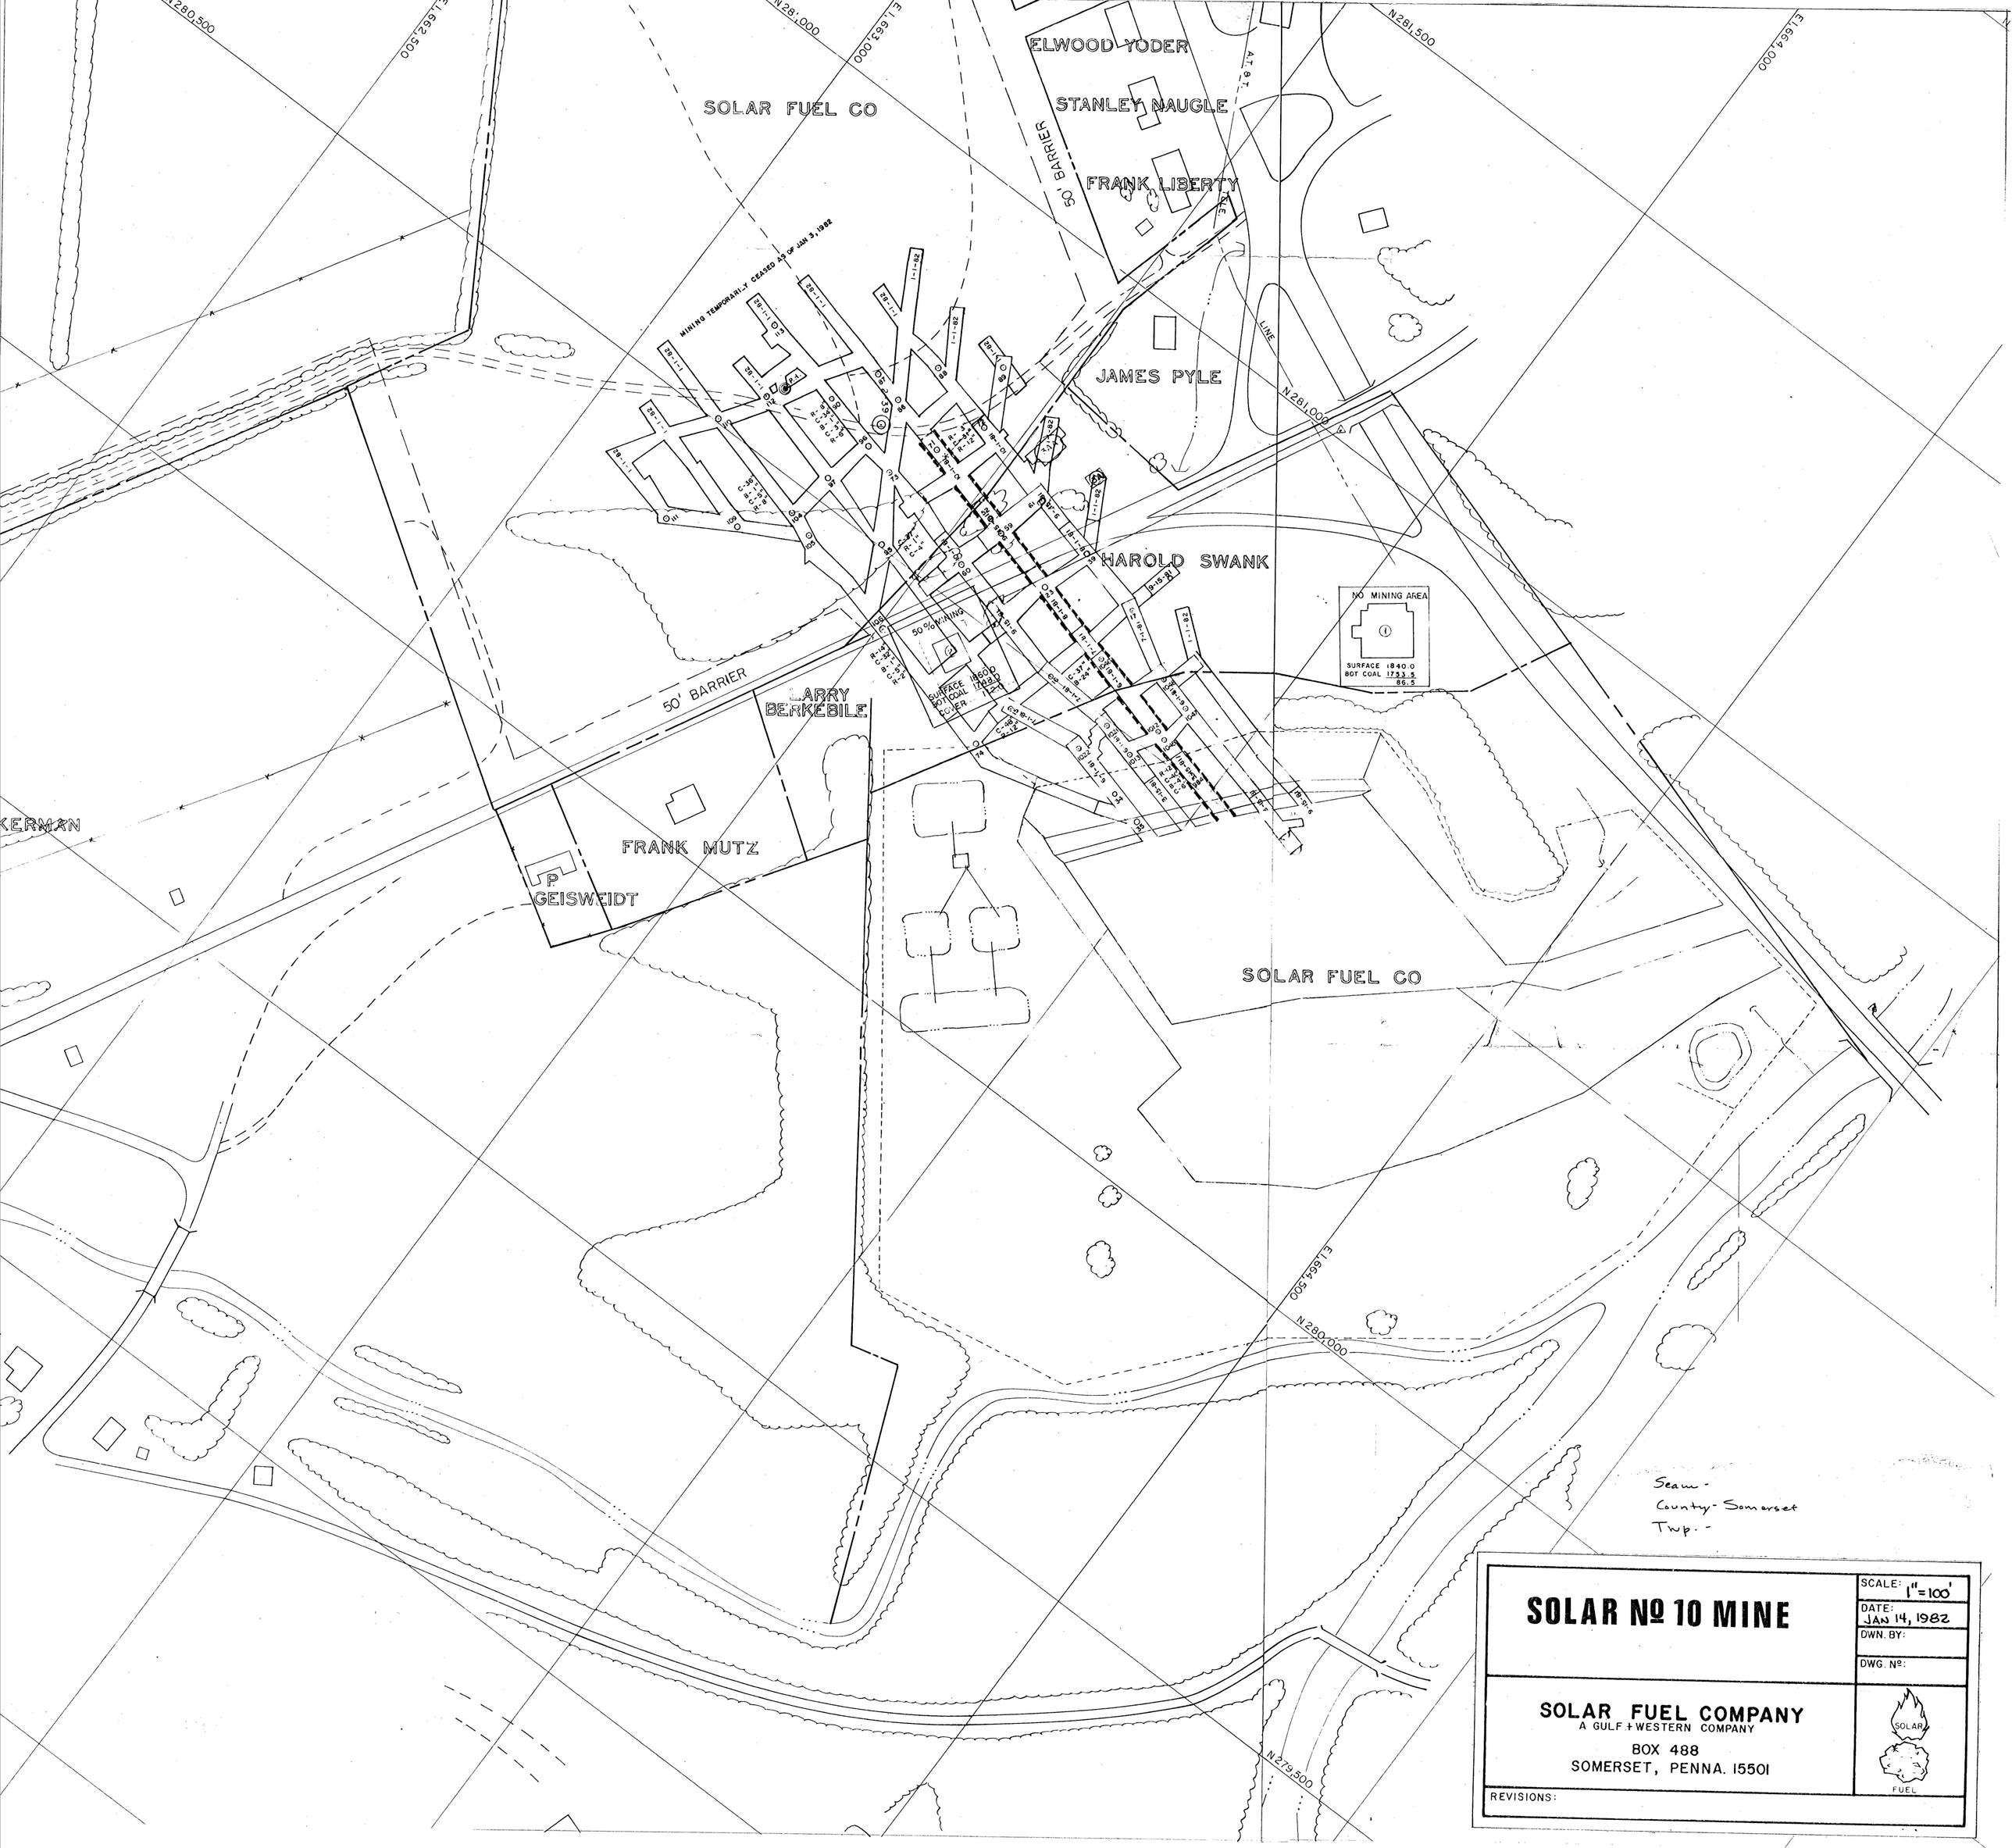
N280,500
E1,662,500
N281,000
E1,663,000
N281,500
E1,664,000
SOLAR FUEL CO
ELWOOD YODER
STANLEY NAUGLE
FRANK LIBERTY
50' BARRIER
MINING TEMPORARILY CEASED AS OF JAN 3, 1982
JAMES PYLE
N281,000
HAROLD SWANK
NO MINING AREA
SURFACE 1840.0
BOT COAL 1753.5
86.5
50% MINING
SURFACE 1860.0
BOT COAL 1773.5
COVER
50' BARRIER
LARRY BERKEBILE
KERMAN
FRANK MUTZ
P
GEISWEIDT
SOLAR FUEL CO
E1,664,500
N280,000
N279,500
Seam -
County - Somerset
Twp. -
SOLAR № 10 MINE
SCALE: 1" = 100'
DATE: JAN 14, 1982
DWN. BY:
DWG. №:
SOLAR FUEL COMPANY
A GULF + WESTERN COMPANY
BOX 488
SOMERSET, PENNA. 15501
SOLAR
FUEL
REVISIONS: