



PETER MONS

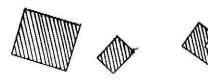

W. 11th St.

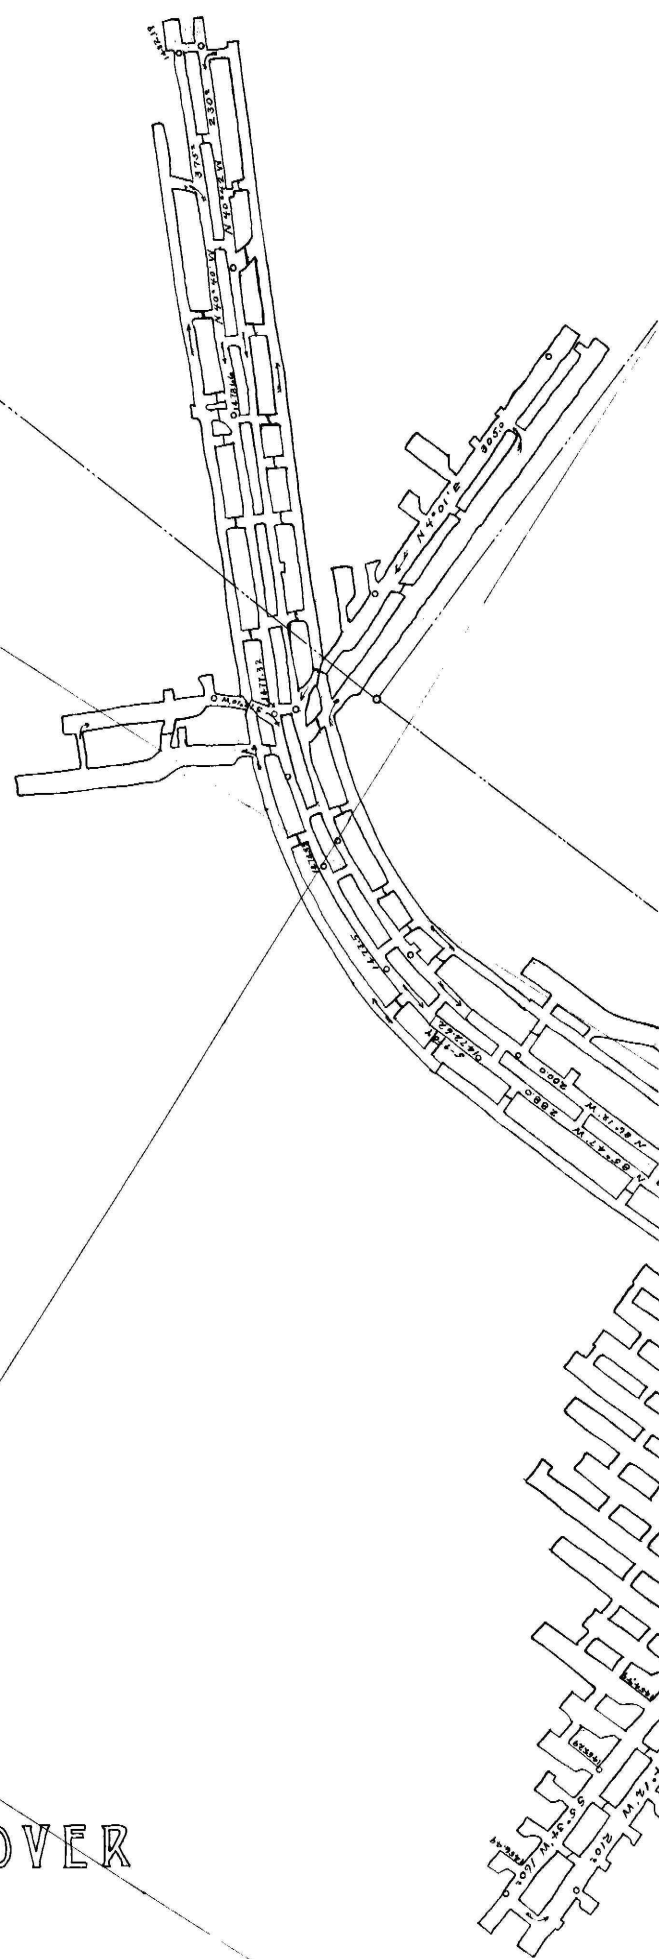

ORIN L. SCHOONOVER

SOMMERVILLE COLLIERY No. 9

of the

BEECH CREEK COAL & COKE CO

WINBURNE PA

5th DISTRICT

scale 1"=100'

(Pittsburgh Quad.)