


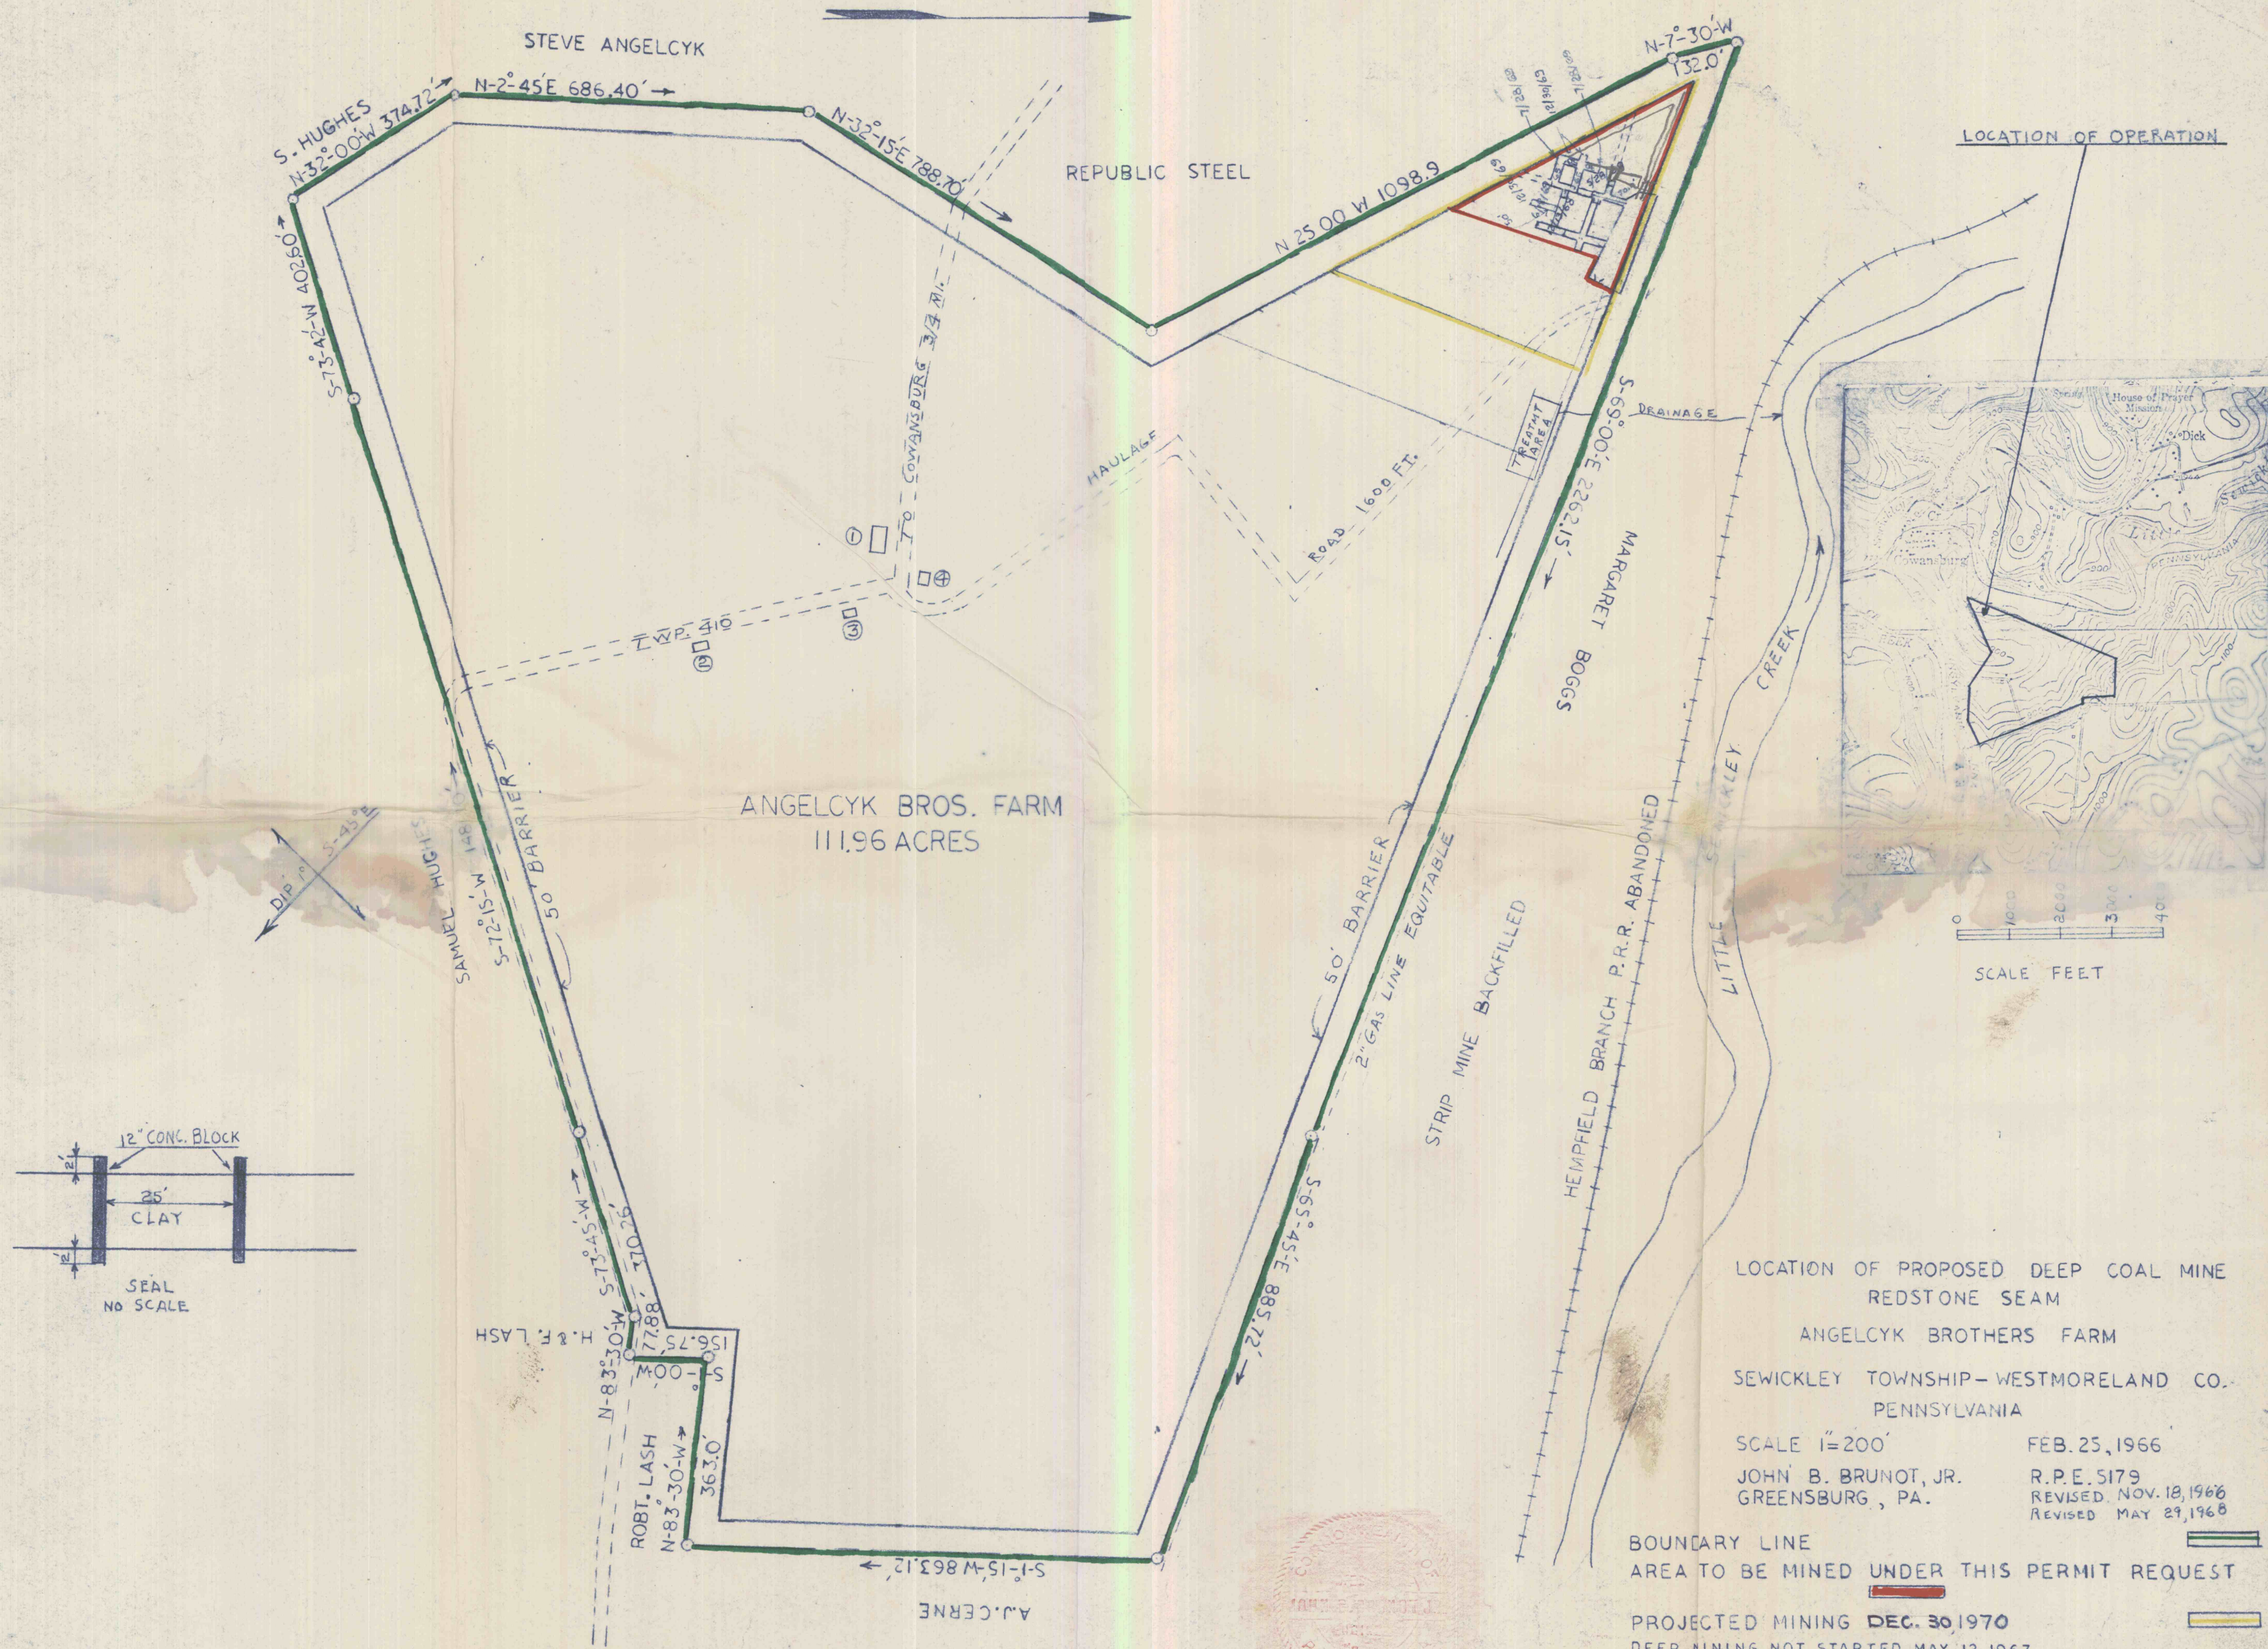

NOTE: MAP PREPARED FROM DEED RECORDS

LOCATION OF PROPOSED DEEP COAL MINE
REDSTONE SEAM
ANGELCYK BROTHERS FARM
SEWICKLEY TOWNSHIP - WESTMORELAND CO.
PENNSYLVANIA

SCALE 1"=200' FEB. 25, 1966
JOHN B. BRUNOT, JR. R.P.E. 5179
GREENSBURG, PA. REVISED NOV. 18, 1966
REVISED MAY 29, 1968

BOUNDARY LINE
AREA TO BE MINED UNDER THIS PERMIT REQUEST

PROJECTED MINING DEC. 30, 1970
DEEP MINING NOT STARTED MAY 12, 1967
DEEP MINING BEGINNING NOV. 13, 1967
REVISED DEC. 13, 1968 REVISED DEC. 30, 1969
REVISED JUNE 18, 1969 REVISED TO DEC. 30, 1970