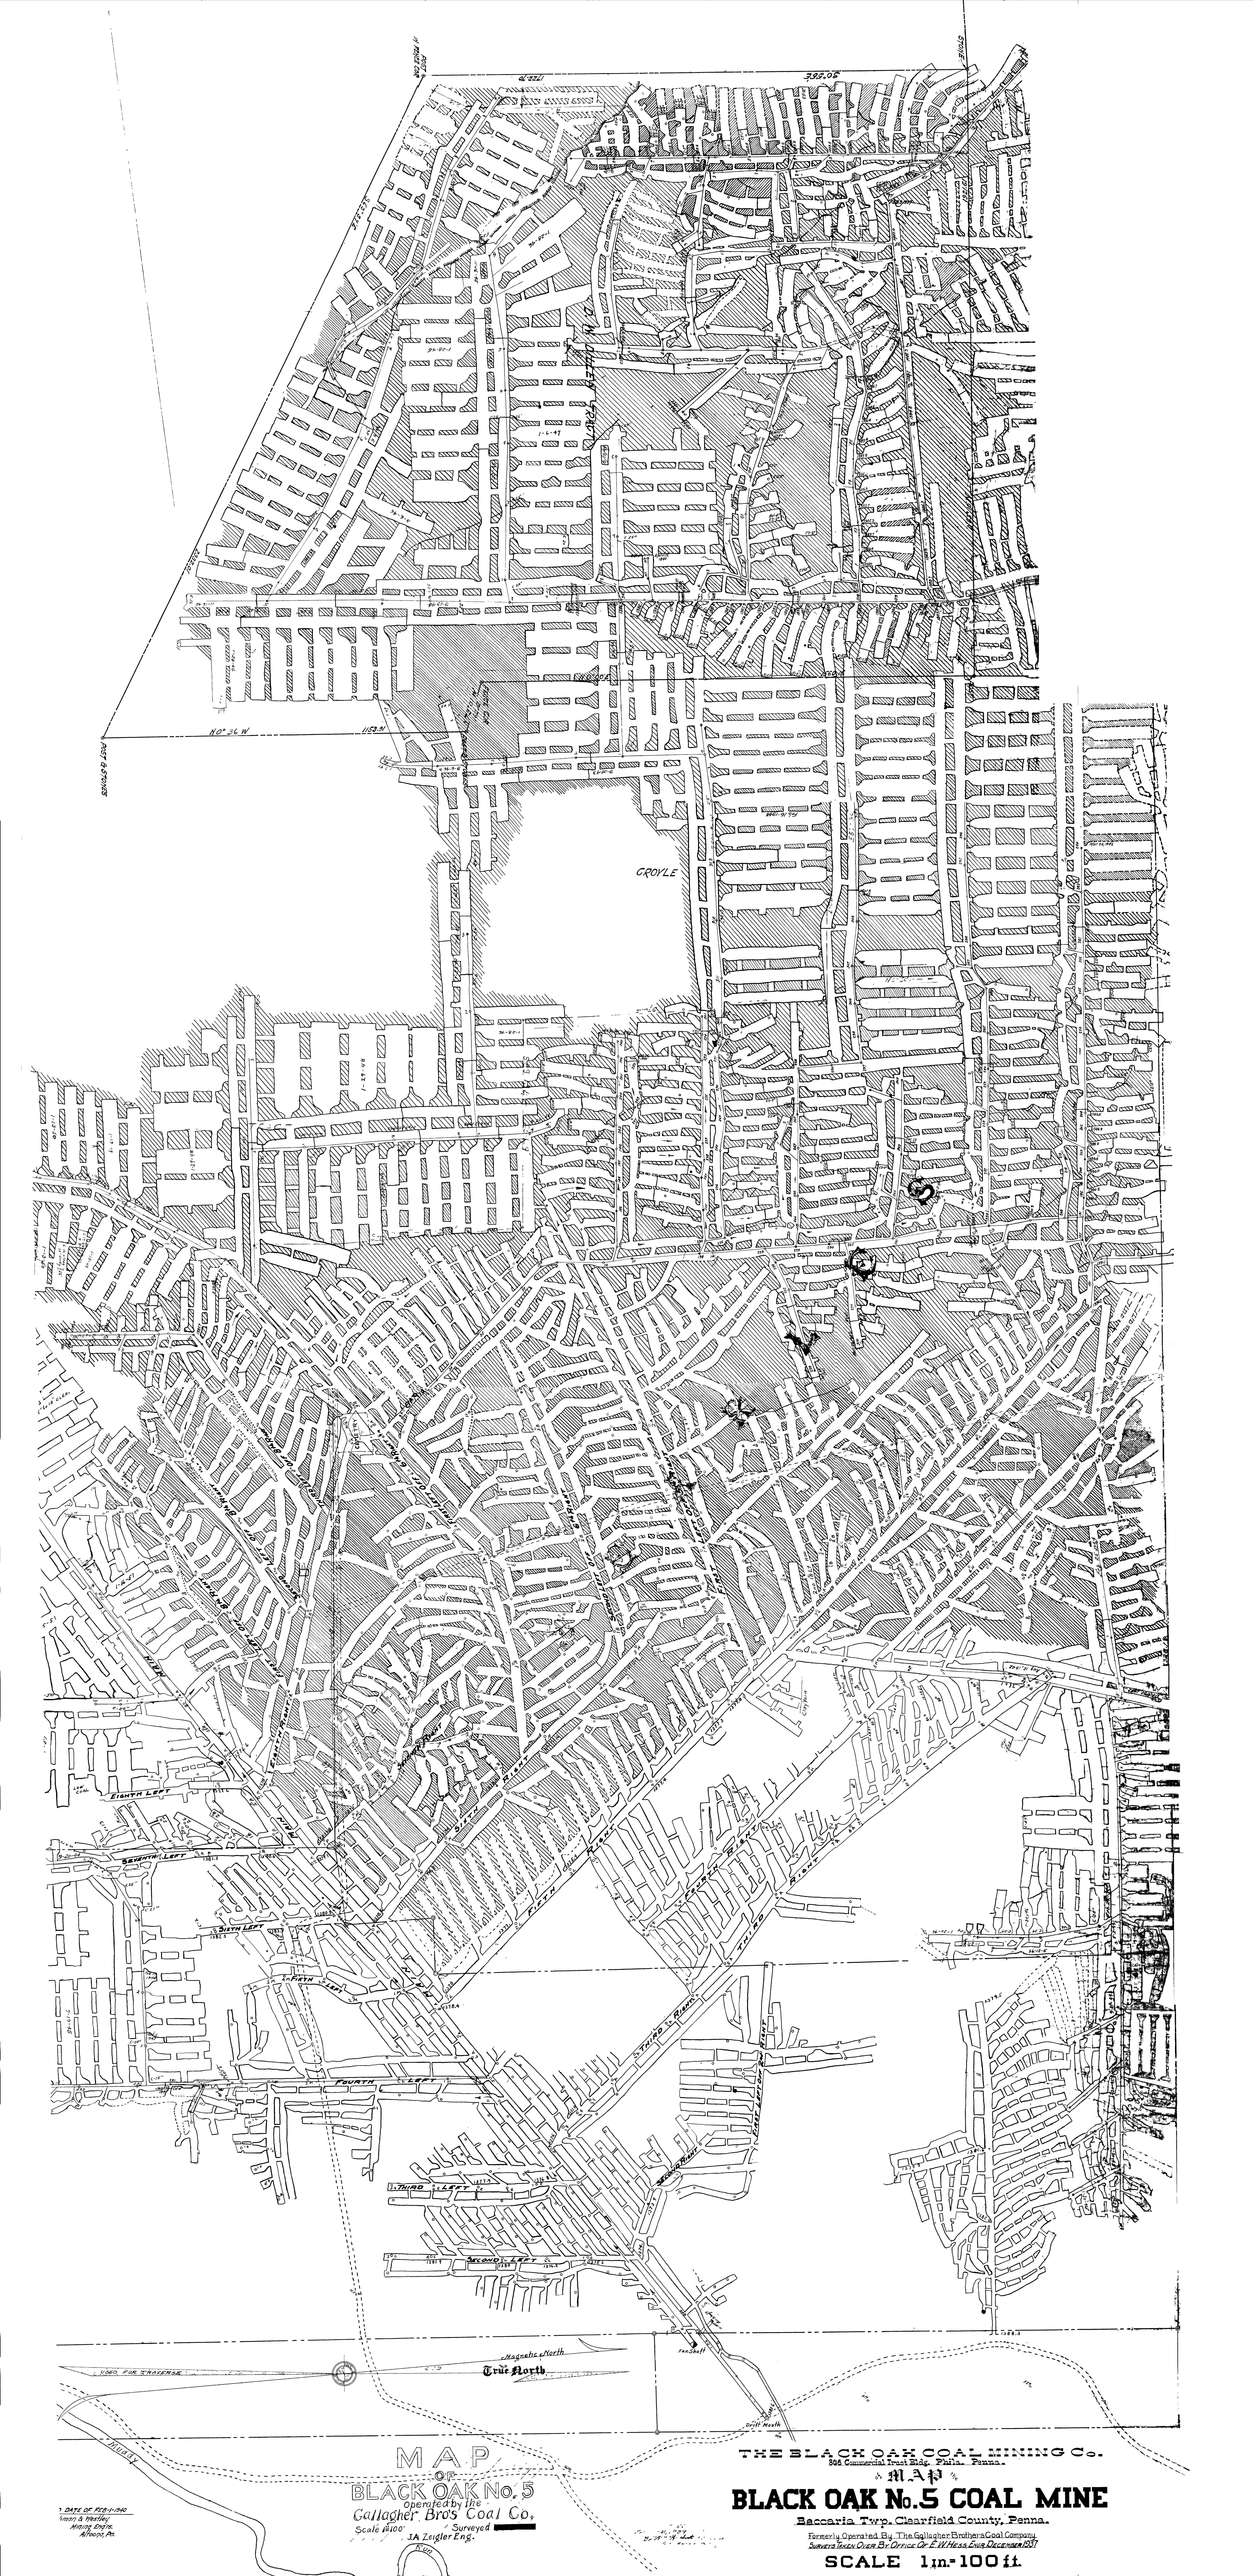

MAIN
FIRST LEFT OFF 2nd RIGHT
SECOND RIGHT
SECOND LEFT
THIRD LEFT
THIRD RIGHT
FOURTH LEFT
FOURTH RIGHT
FIFTH LEFT
FIFTH RIGHT
SIXTH LEFT
SIXTH RIGHT
SEVENTH LEFT
EIGHTH LEFT
EIGHTH RIGHT
FIRST LEFT OFF 6th RIGHT
SECOND LEFT OFF 6th RIGHT
FIRST LEFT OFF 8th RIGHT
SECOND LEFT OFF 8th RIGHT
THIRD LEFT OFF 8th RIGHT
CEMETERY
LOW COAL
Clay Vein
Aug 12, 1942
Feb 16-1944
Mar 20, 1942
7-19-45
1-29-48
1-28-46
1-6-47
9-6-46
9-28-43
9-19-44
11-16-45
1-10-49
1-13-50
1-16-51
CROYLE
D. W. DILLEN TRACT
FENCE COR
POST & STONES
POST IN FENCE COR
STONE
N0°36 W
1153.91
2332.01
S63°39'E
1722.70
S0°55'E
1388.3
Fan Shaft
Drift Mouth
Muddy Run
Magnetic North
True North
USED FOR TRAVERSE

THE BLACK OAK COAL MINING Co.
806 Commercial Trust Bldg. Phila. Penna.

of MAP the

BLACK OAK No.5 COAL MINE

Beccaria Twp. Clearfield County, Penna.

Formerly Operated By The Gallagher Brothers Coal Company
Surveys Taken Over By Office Of E. W. Hess, Engr. December 1937

SCALE 1 in.= 100 ft.

MAP
OF
BLACK OAK No. 5
operated by the
Gallagher Bro's Coal Co.
Scale 1"=100' Surveyed [redacted]
J.A. Zeigler Eng.

DATE OF FEB-1-1940
lman & Westley
Mining Eng'rs.
Altoona, Pa.