


MAP SHOWING MINING OPERATION NO. 2
 (CUPPER FREEPORT SEAM)
 OF THE
 SOUTH FORK MINING CO.
 SITUATE IN
 CONRAD TWP.
 CAMBRIA CO., PA.
 SCALE - 1"=100'
 NOV. 30, 1951 + EXTENSIONS TO JAN. 11, 1955
 A. CALVIN GARRAULT, JR.
 JOHNSTOWN, PA.

SUEAN E. C. CONRAD TWP.



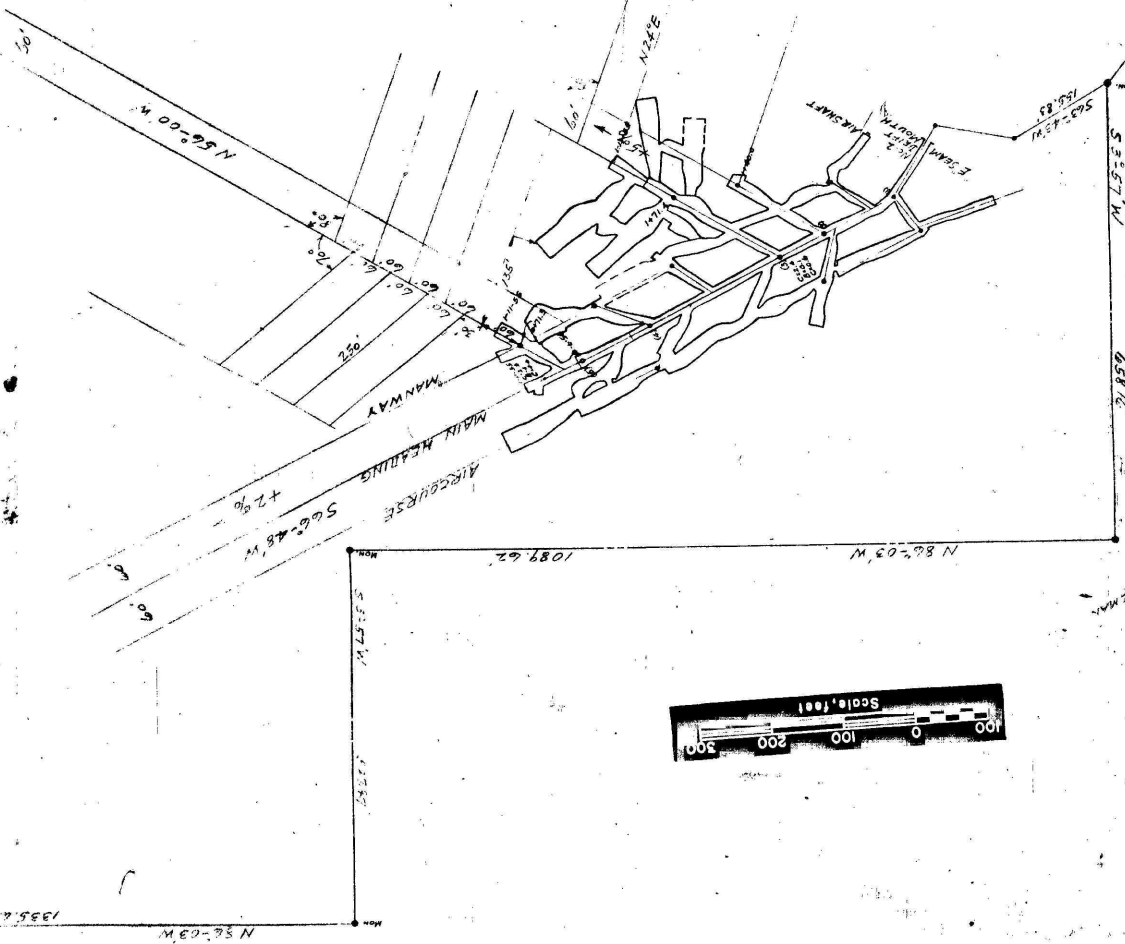

MS-25 03113 305 206 506 34287