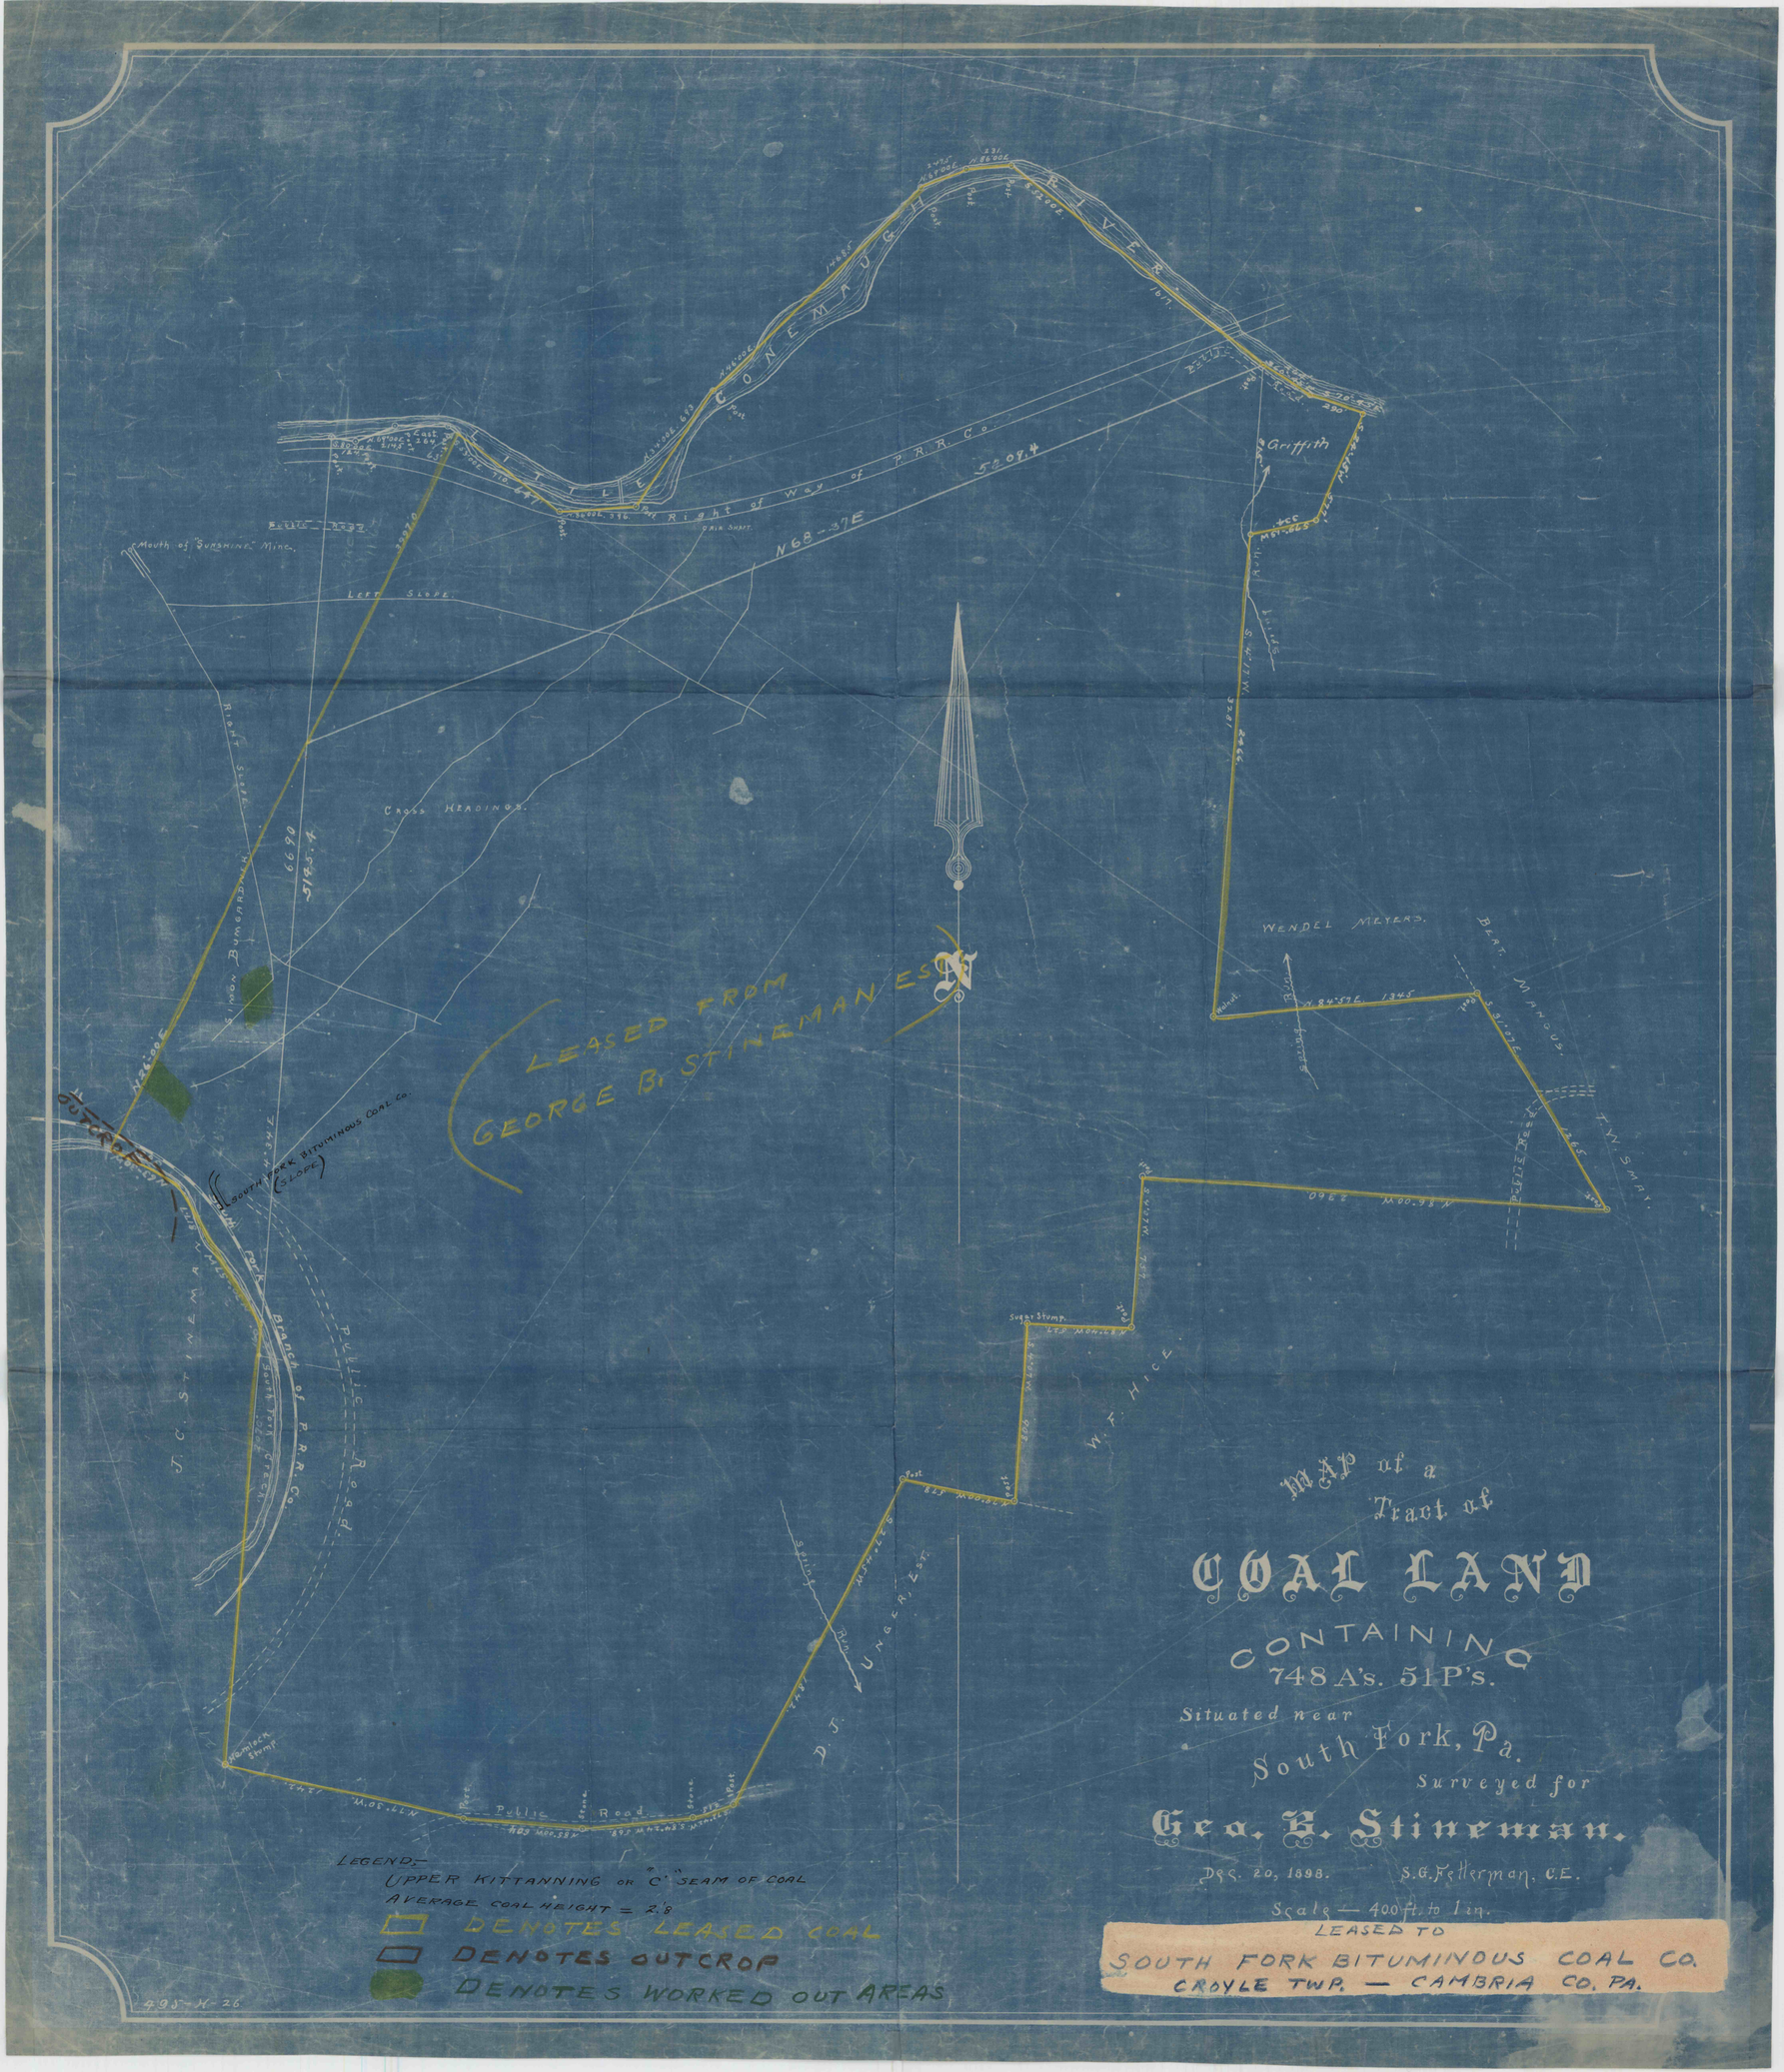
Mouth of "Sunshine" Mine.
Left Slope.
Cross Headings.
Simon Bumgardner.
Right of Way of P.R.R.Co.
N68-37E
Griffith
Wendel Meyers.
Beat Manous.
T.W. Smay.
Public Road
South Fork Bituminous Coal Co. (Slope)
Branch of P.R.R.Co.
J.C. Stineman
Sugar Stump.
W.F. Hice
D.J. Unger, Est.
Hemlock Stump.
Public Road
LEASED FROM
GEORGE B. STINEMAN ESQ.
MAP of a Tract of
COAL LAND
CONTAINING
748 A's. 51 P's.
Situated near
South Fork, Pa.
Surveyed for
Geo. B. Stineman.
Dec. 20, 1898.
S.G. Fetterman, C.E.
Scale — 400 ft. to 1 in.
LEASED TO
SOUTH FORK BITUMINOUS COAL CO.
CROYLE TWP. — CAMBRIA CO. PA.
LEGEND:-
UPPER KITTANNING OR "C" SEAM OF COAL
AVERAGE COAL HEIGHT = 2'8
DENOTES LEASED COAL
DENOTES OUTCROP
DENOTES WORKED OUT AREAS
498-H-26