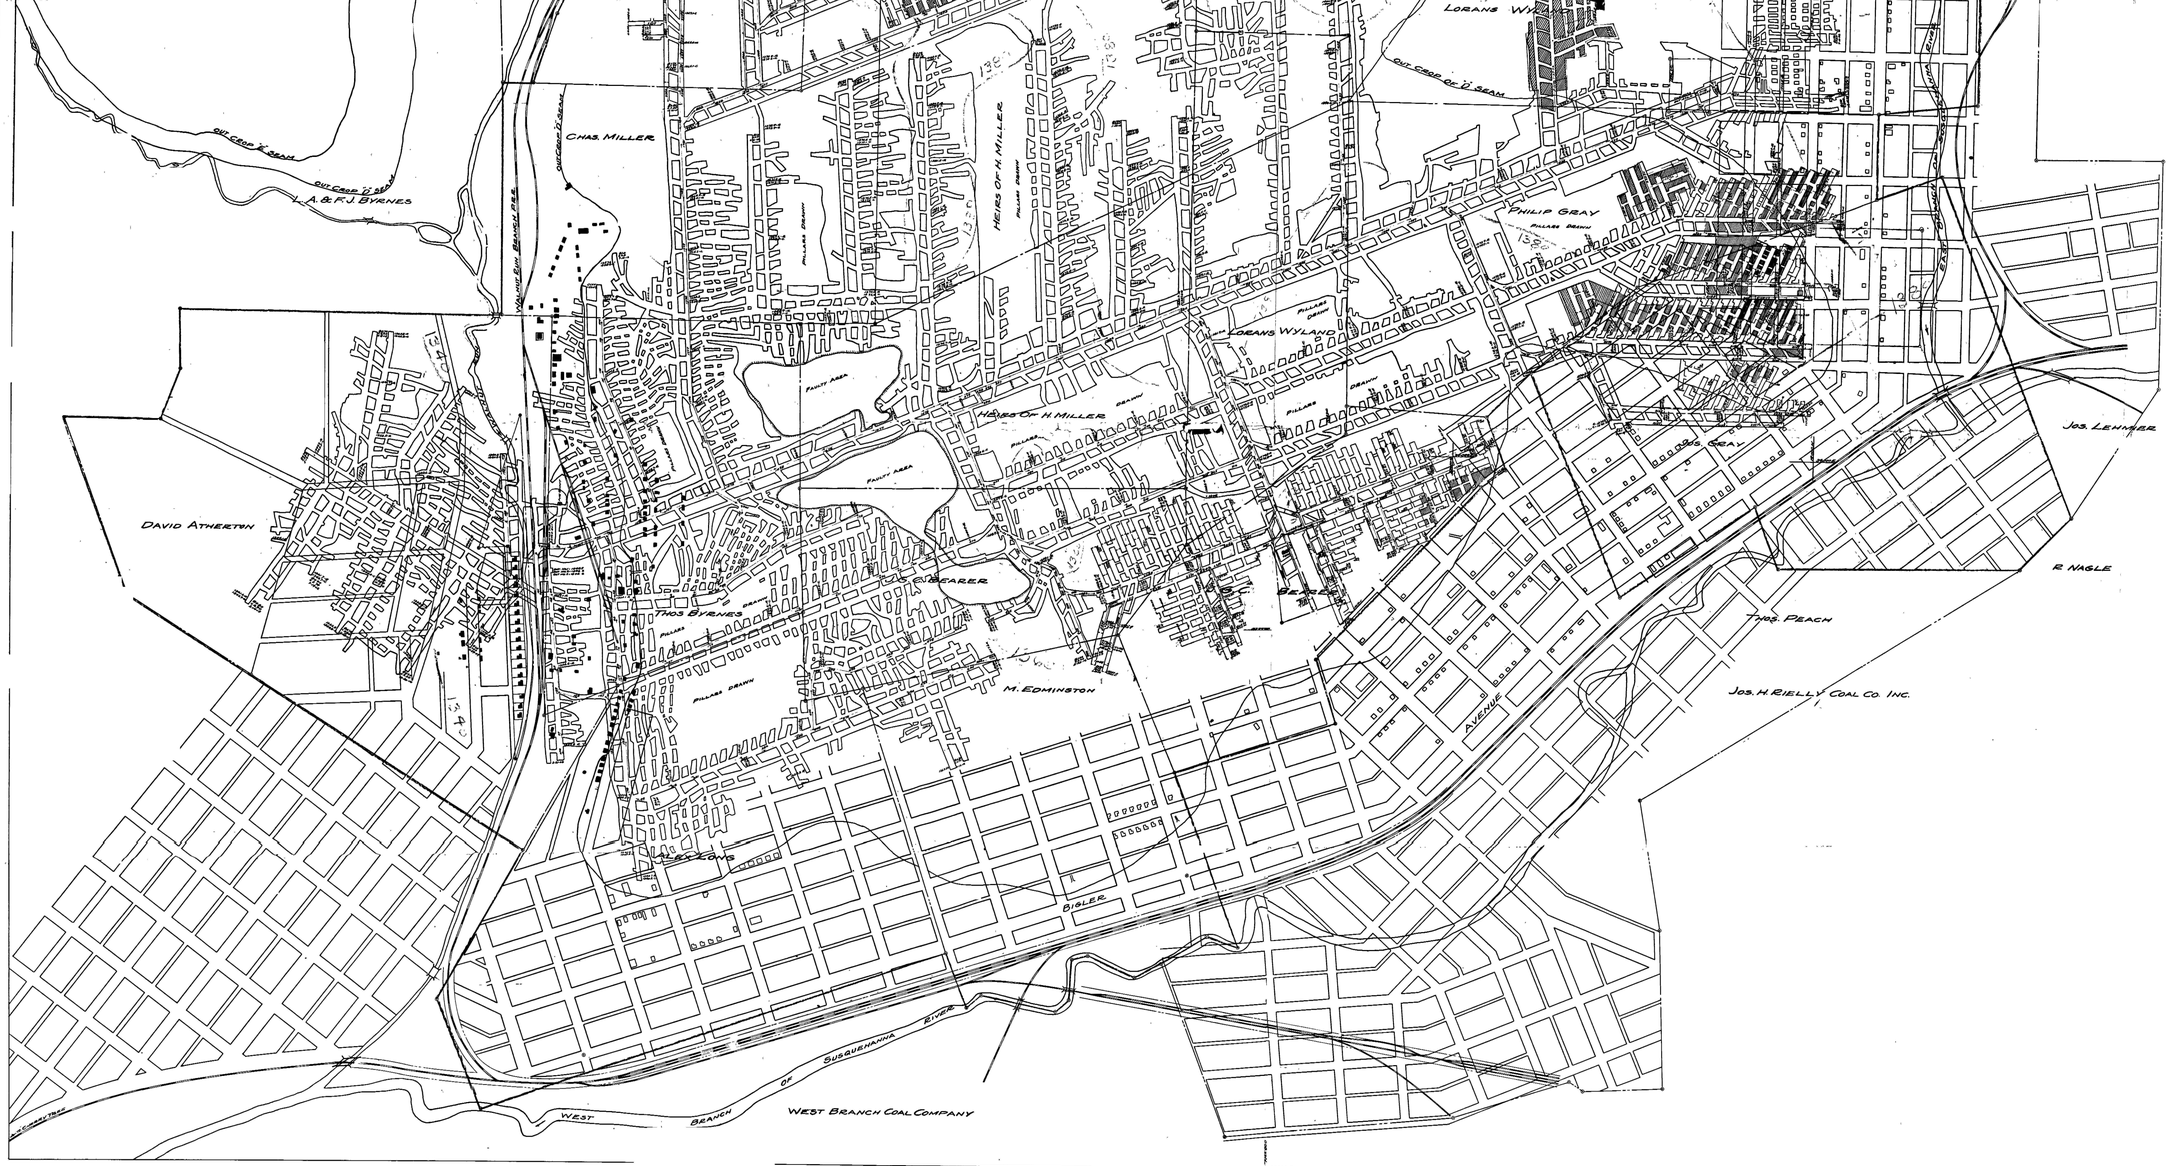

I CERTIFY THAT THIS BLUE PRINT IS A TRUE AND CORRECT COPY OF THE ORIGINAL MAP OF SPANGLER NO. 4 MINE AND THAT THE ORIGINAL MAP IS A TRUE, COMPLETE AND CORRECT RECORD, MAP AND SURVEY OF ALL THE ELEVATIONS MADE IN SAID SPANGLER'S MINE.

SEPT. 12. 1934. Geo. G. Thompson
Mine Foreman

MAP SHOWING

SPANGLER NO 4 MINE

"B" SEAM

OPERATED BY

MADEIRA HILL COAL MINING CO.

SITUATED IN SUSQUEHANNA TOWNSHIP

CAMBRIA COUNTY PENNSYLVANIA

SCALE 1 IN = 200 FT. MARCH 27, 1934