




SPRINGDALE MINE WORKINGS

SITUATE IN
ALLEGHENY AND WESTMORELAND COUNTIES
PENNSYLVANIA

ALTMIRE BROS. COAL CO., INC.

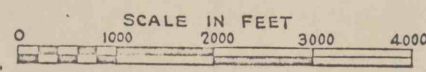

DATE: SEPTEMBER 30, 1968

PREPARED BY: Richard J. Walter