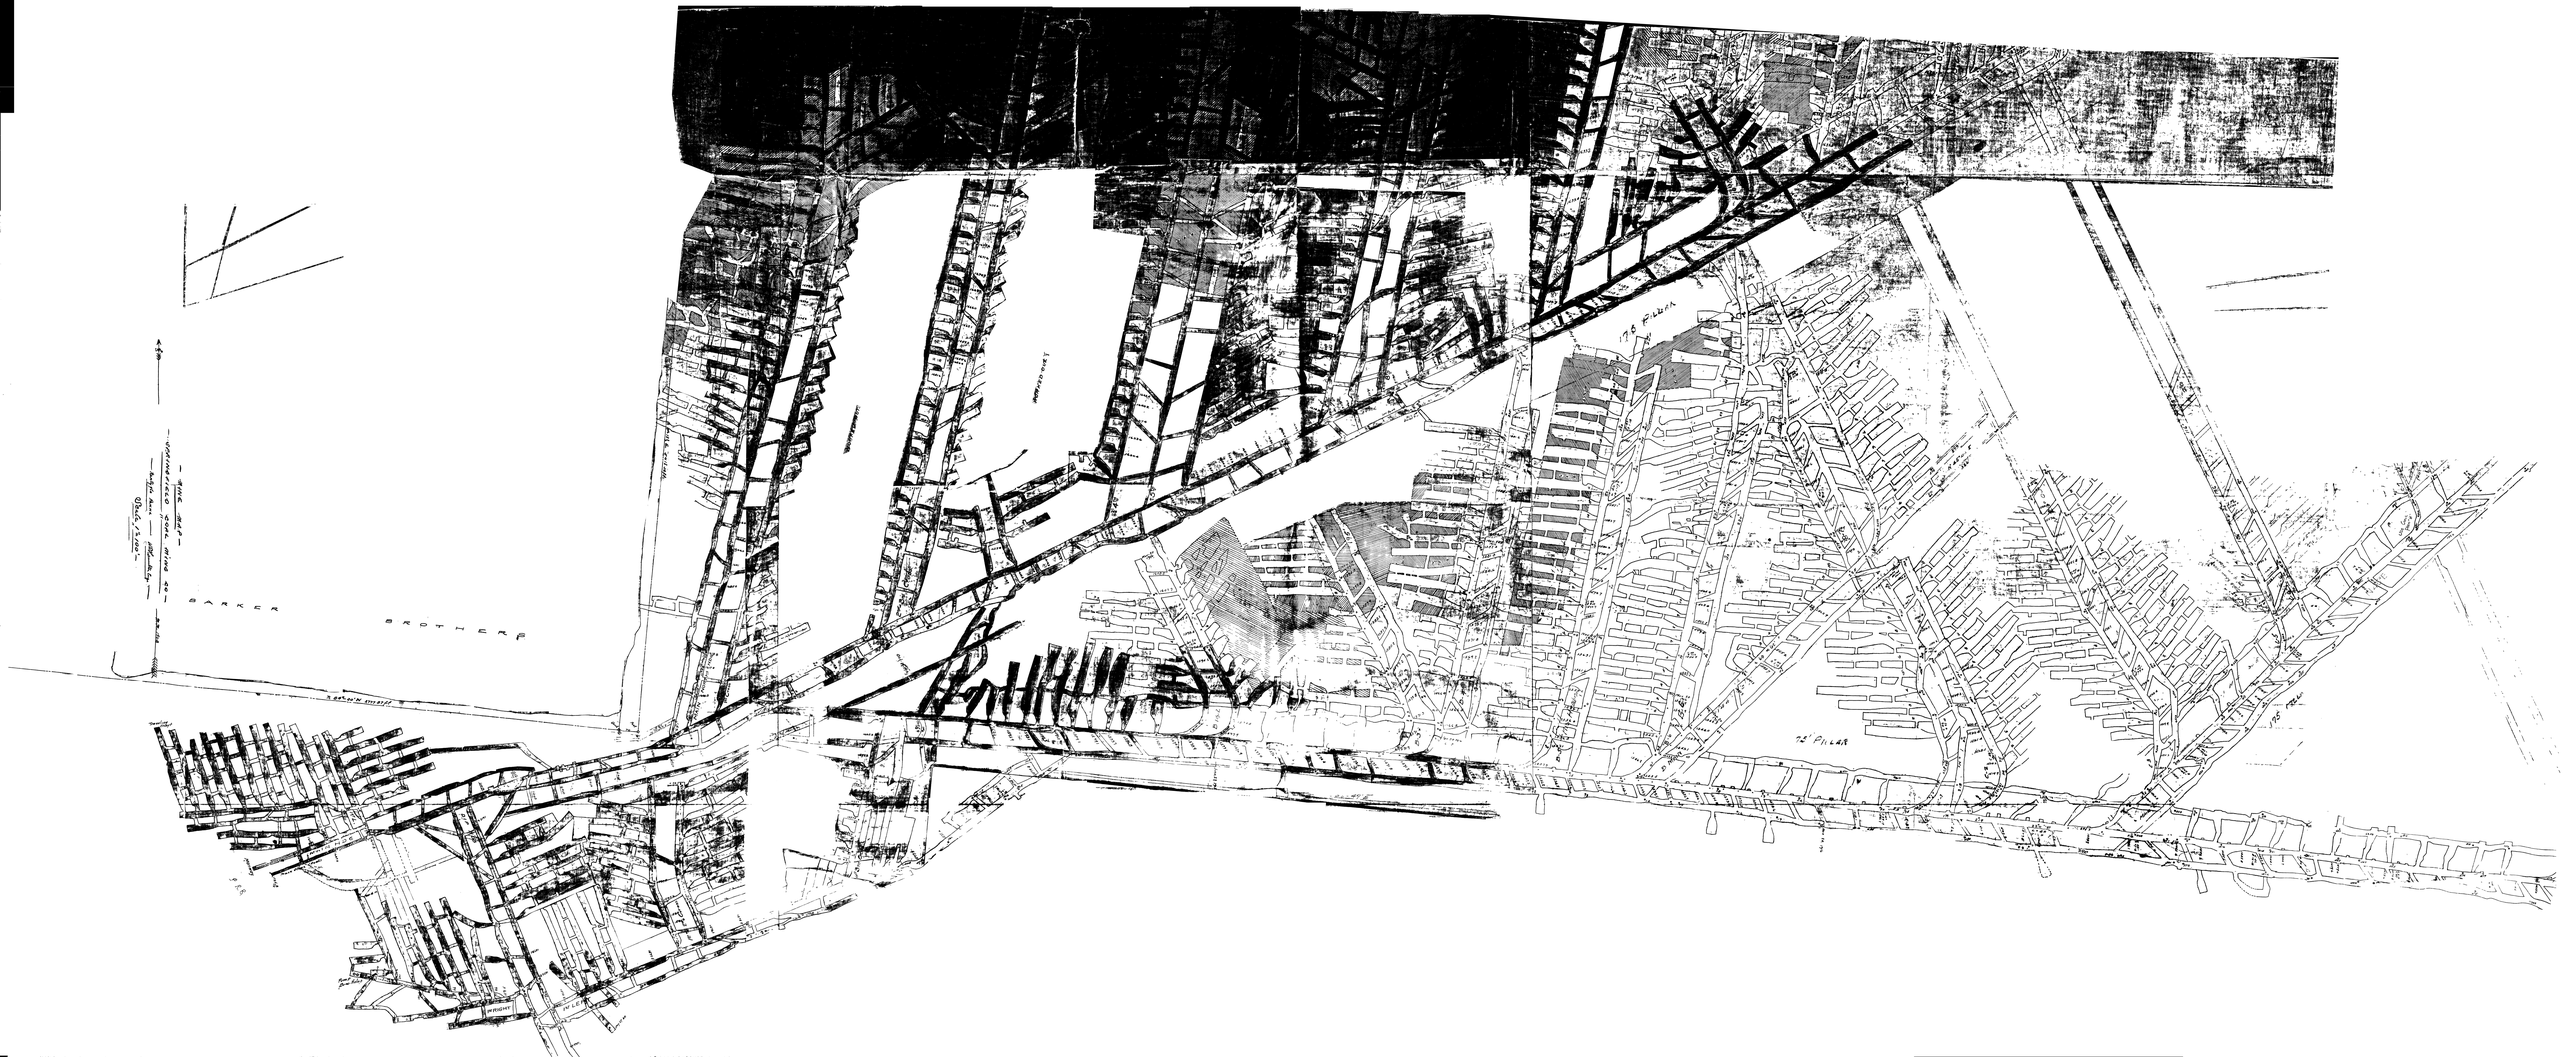
BARKER
BROTHERS
75' PILLAR
75' PILLAR
75' PILLAR