




FACTORY TRACT

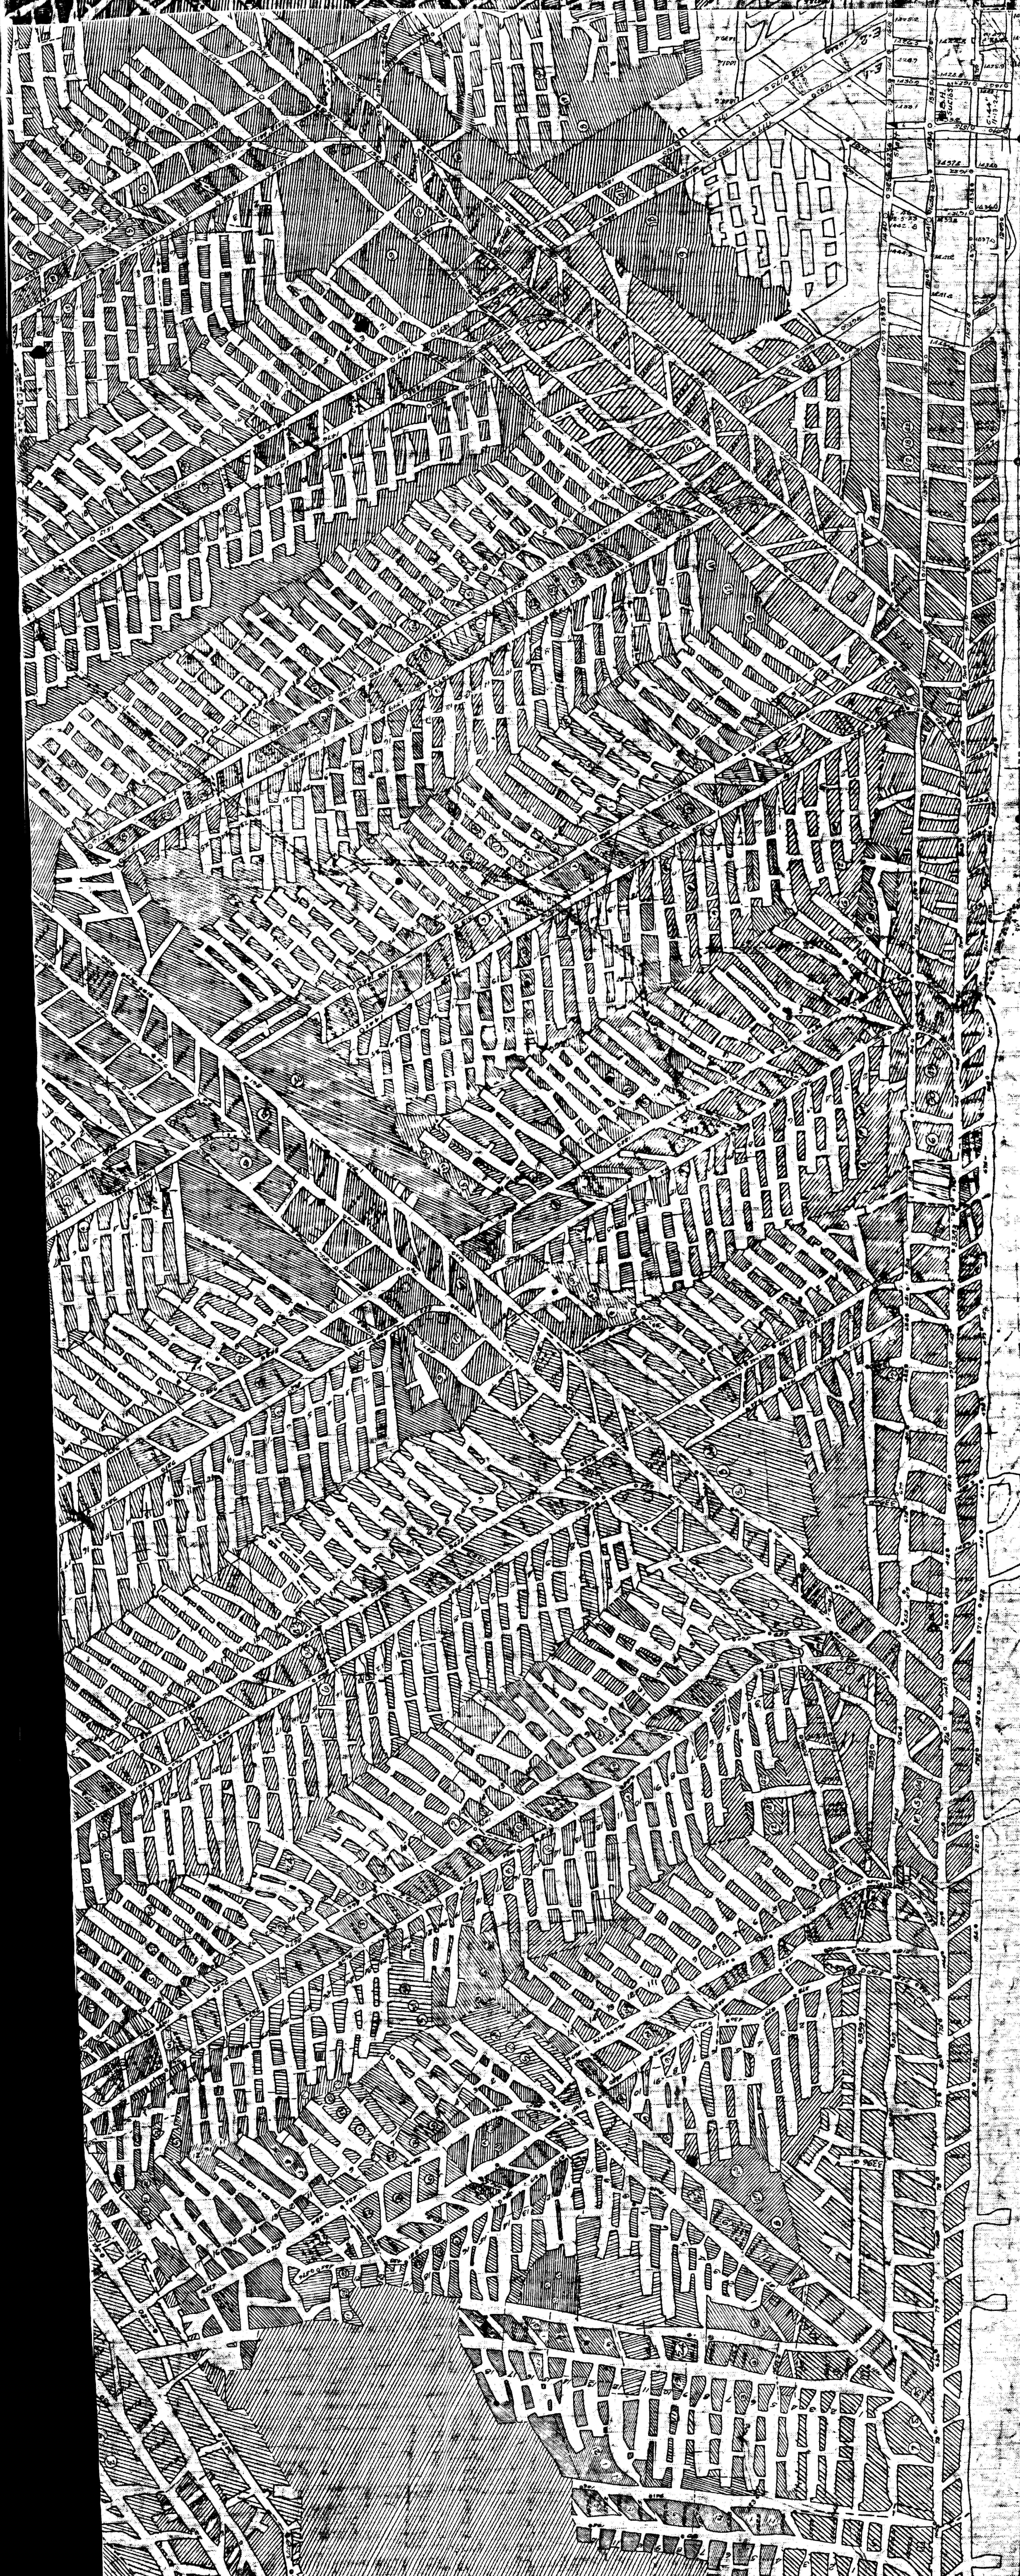

DAVIS STREET

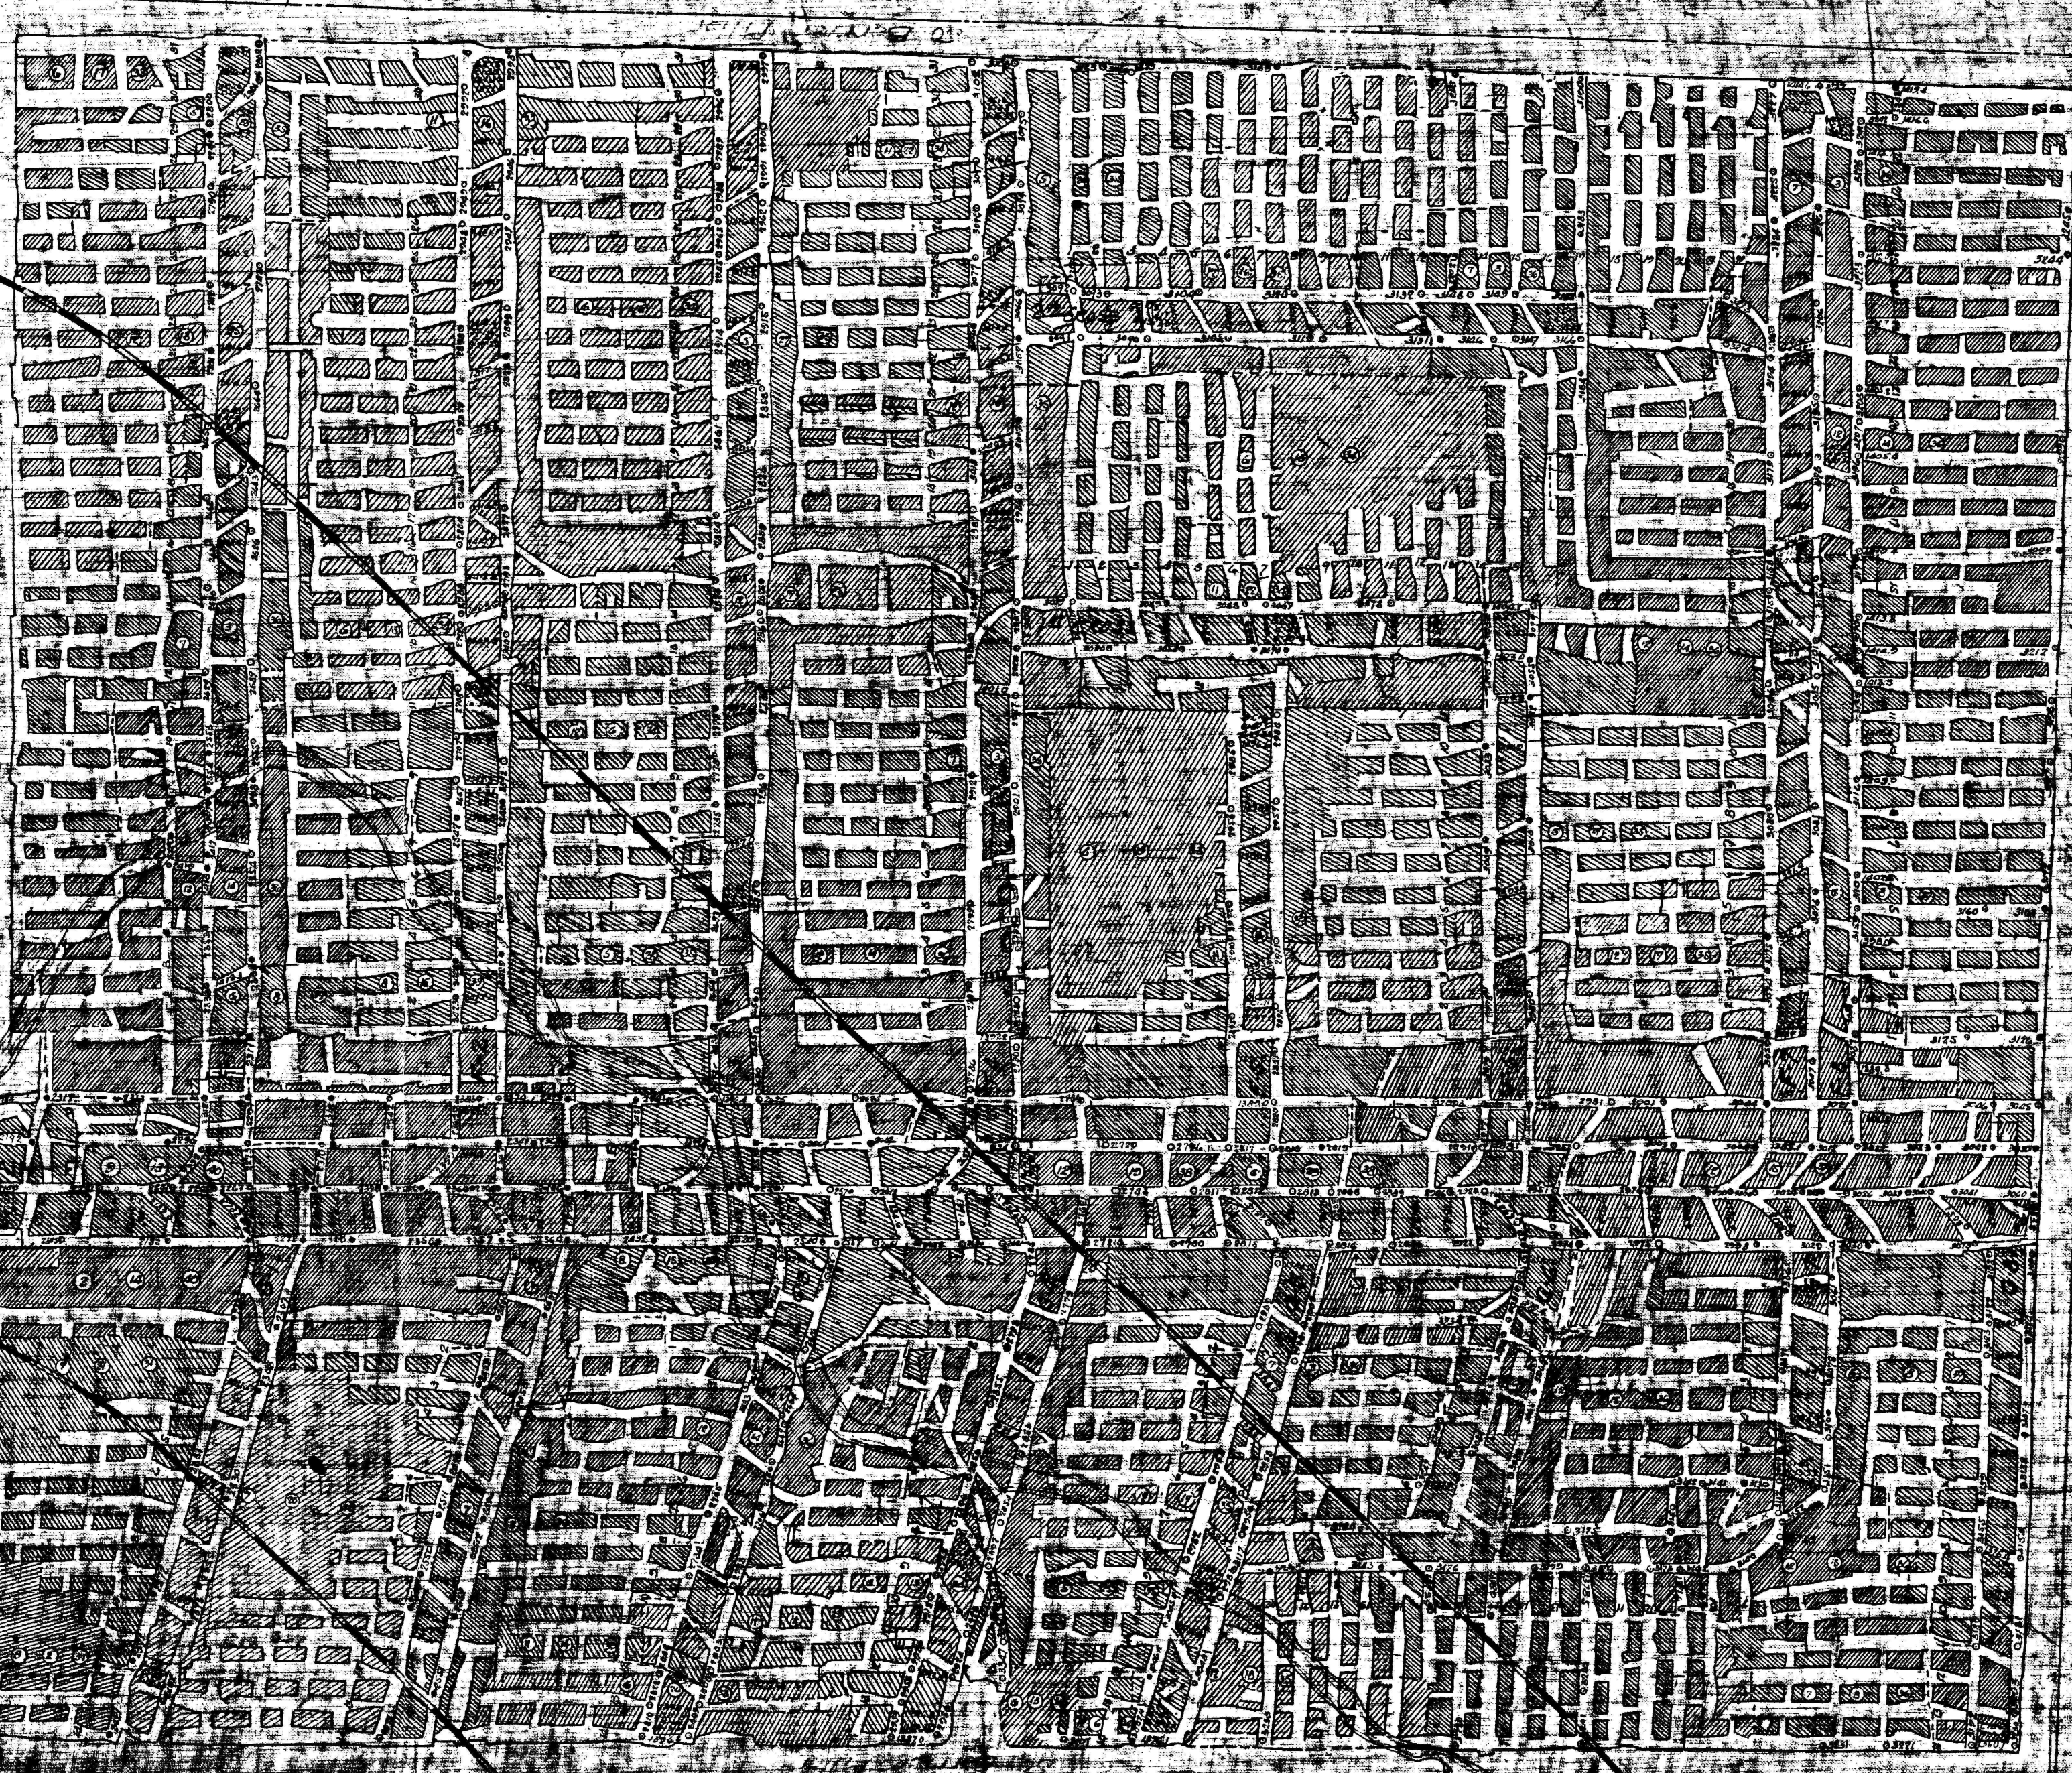

DEPARTMENT OF MINES
HARRISBURG
PENNSYLVANIA

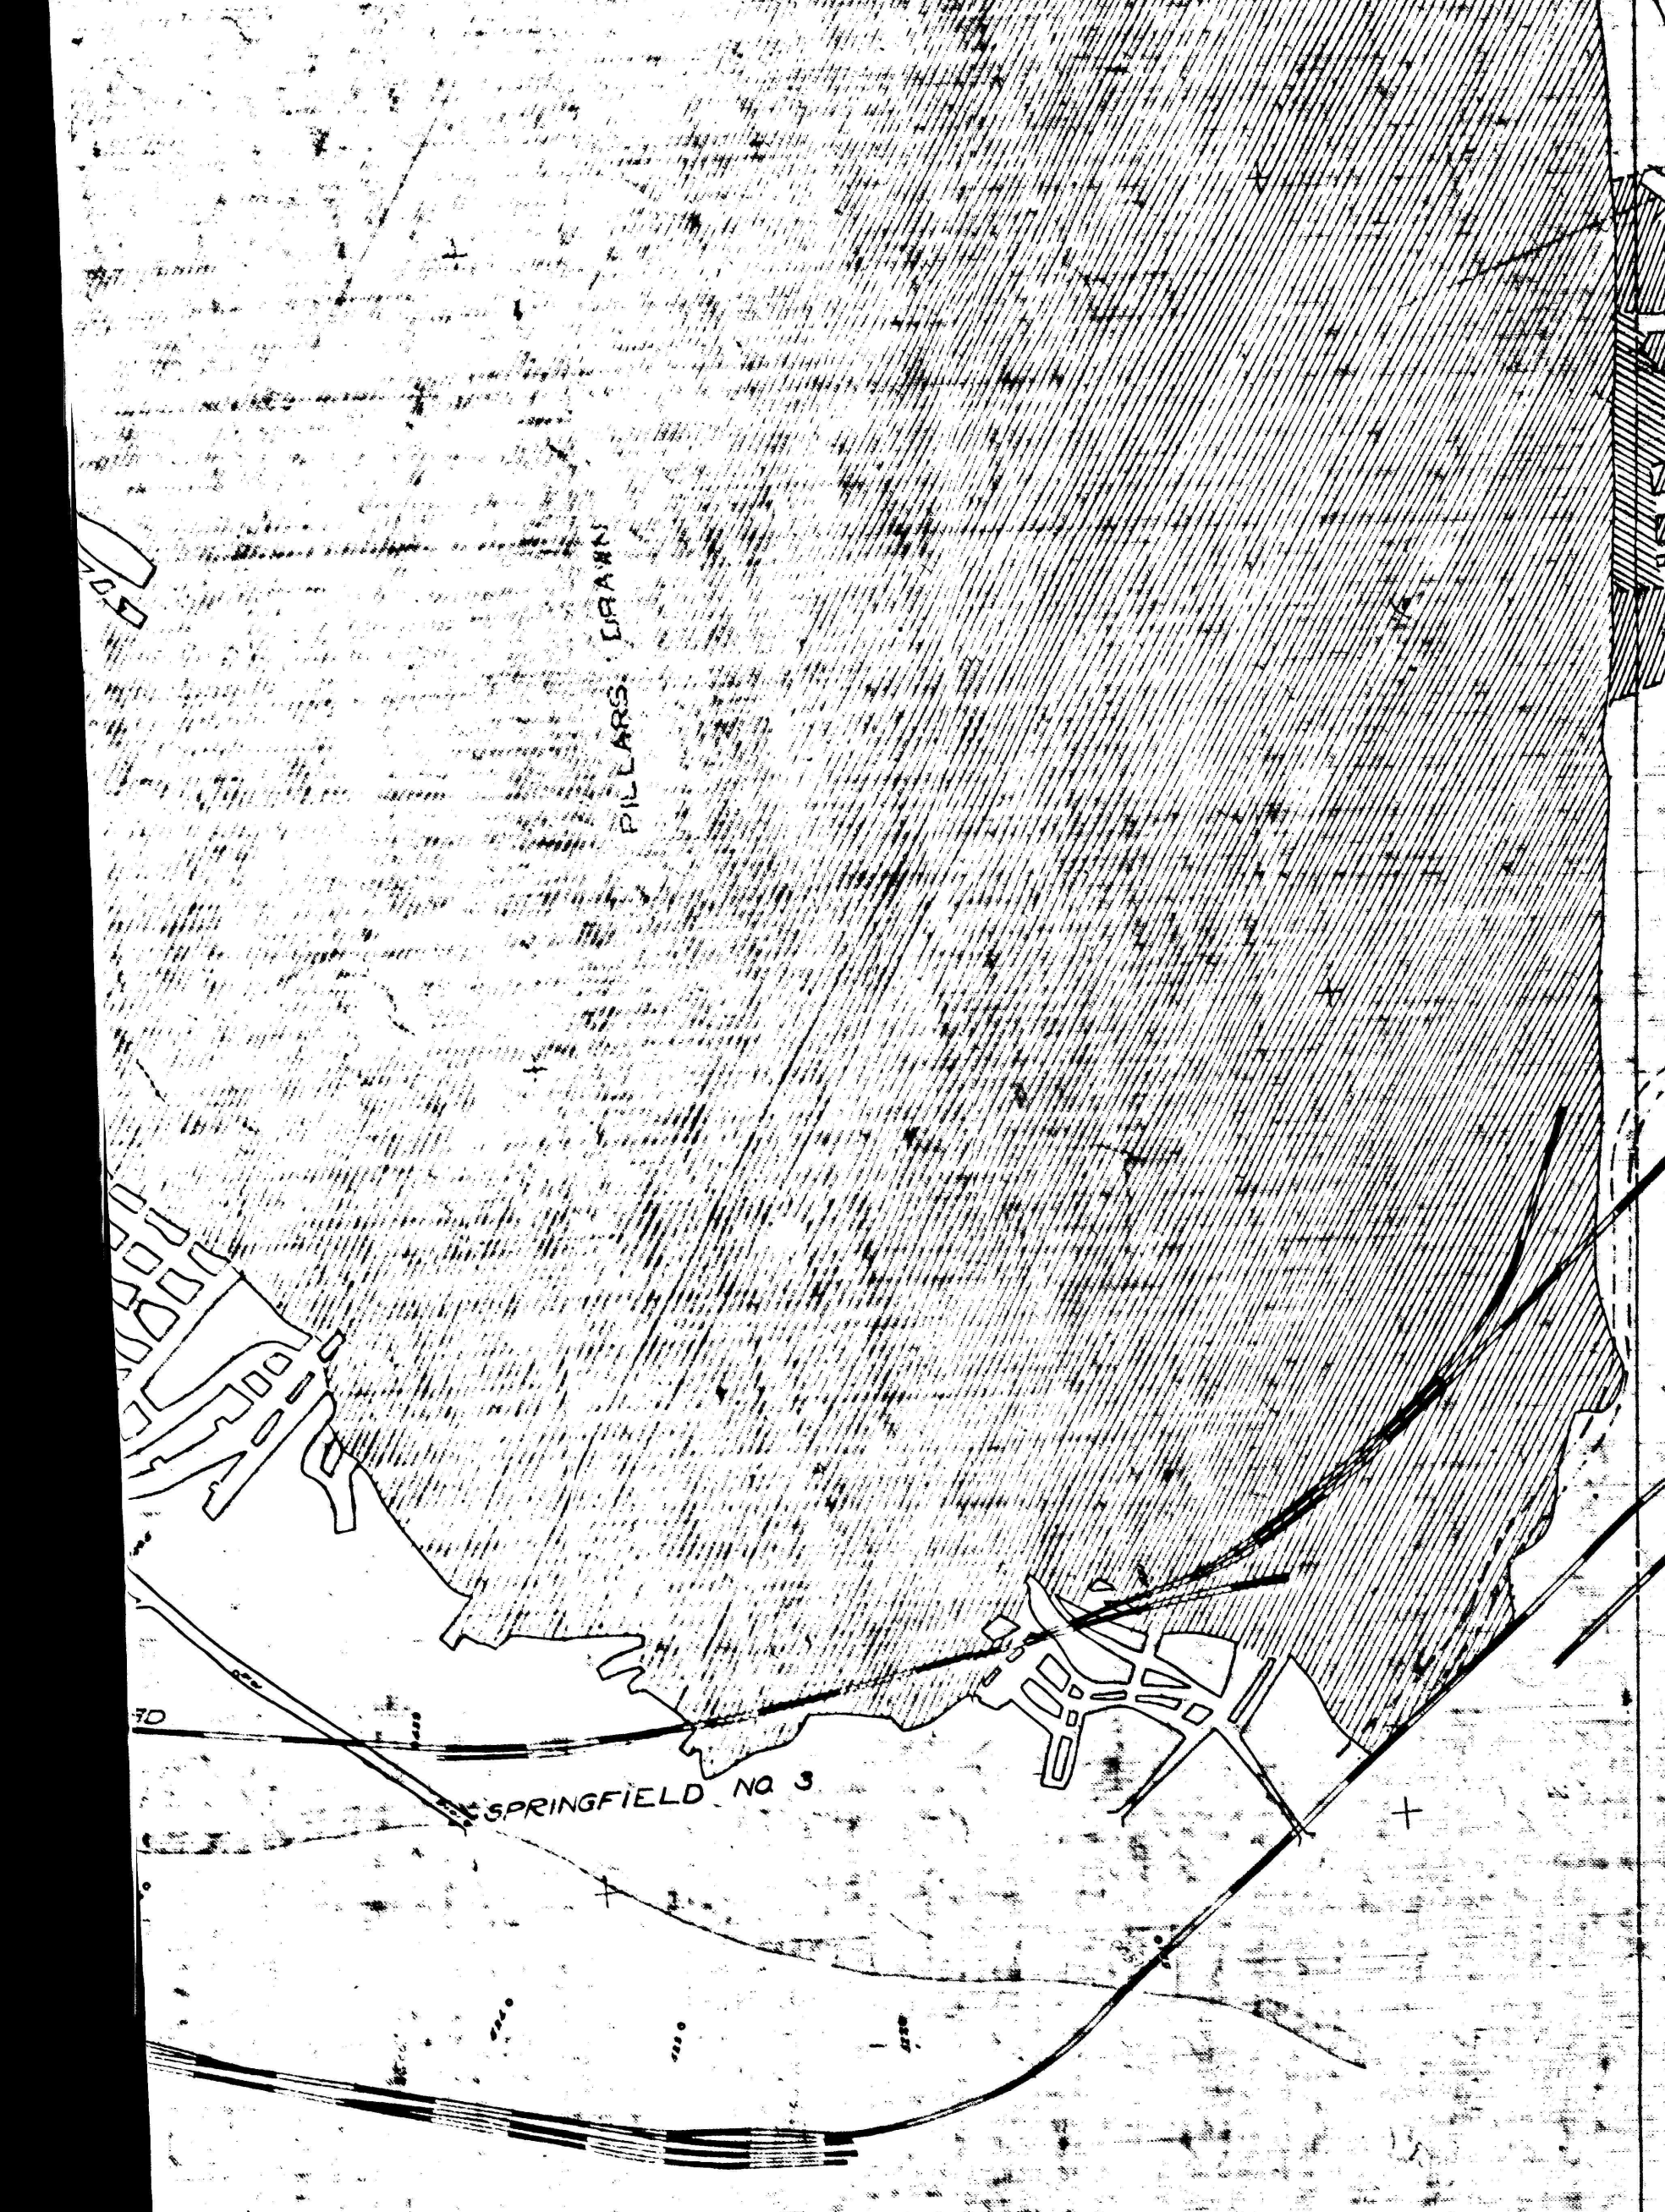

DEEP MINE SAFETY 200