


IGFIELD #4 MINE
FORMERLY
FIELD COAL CORPN.
WELF, PENNA.
DATE 1-20-07
NES & TUCKER CO.

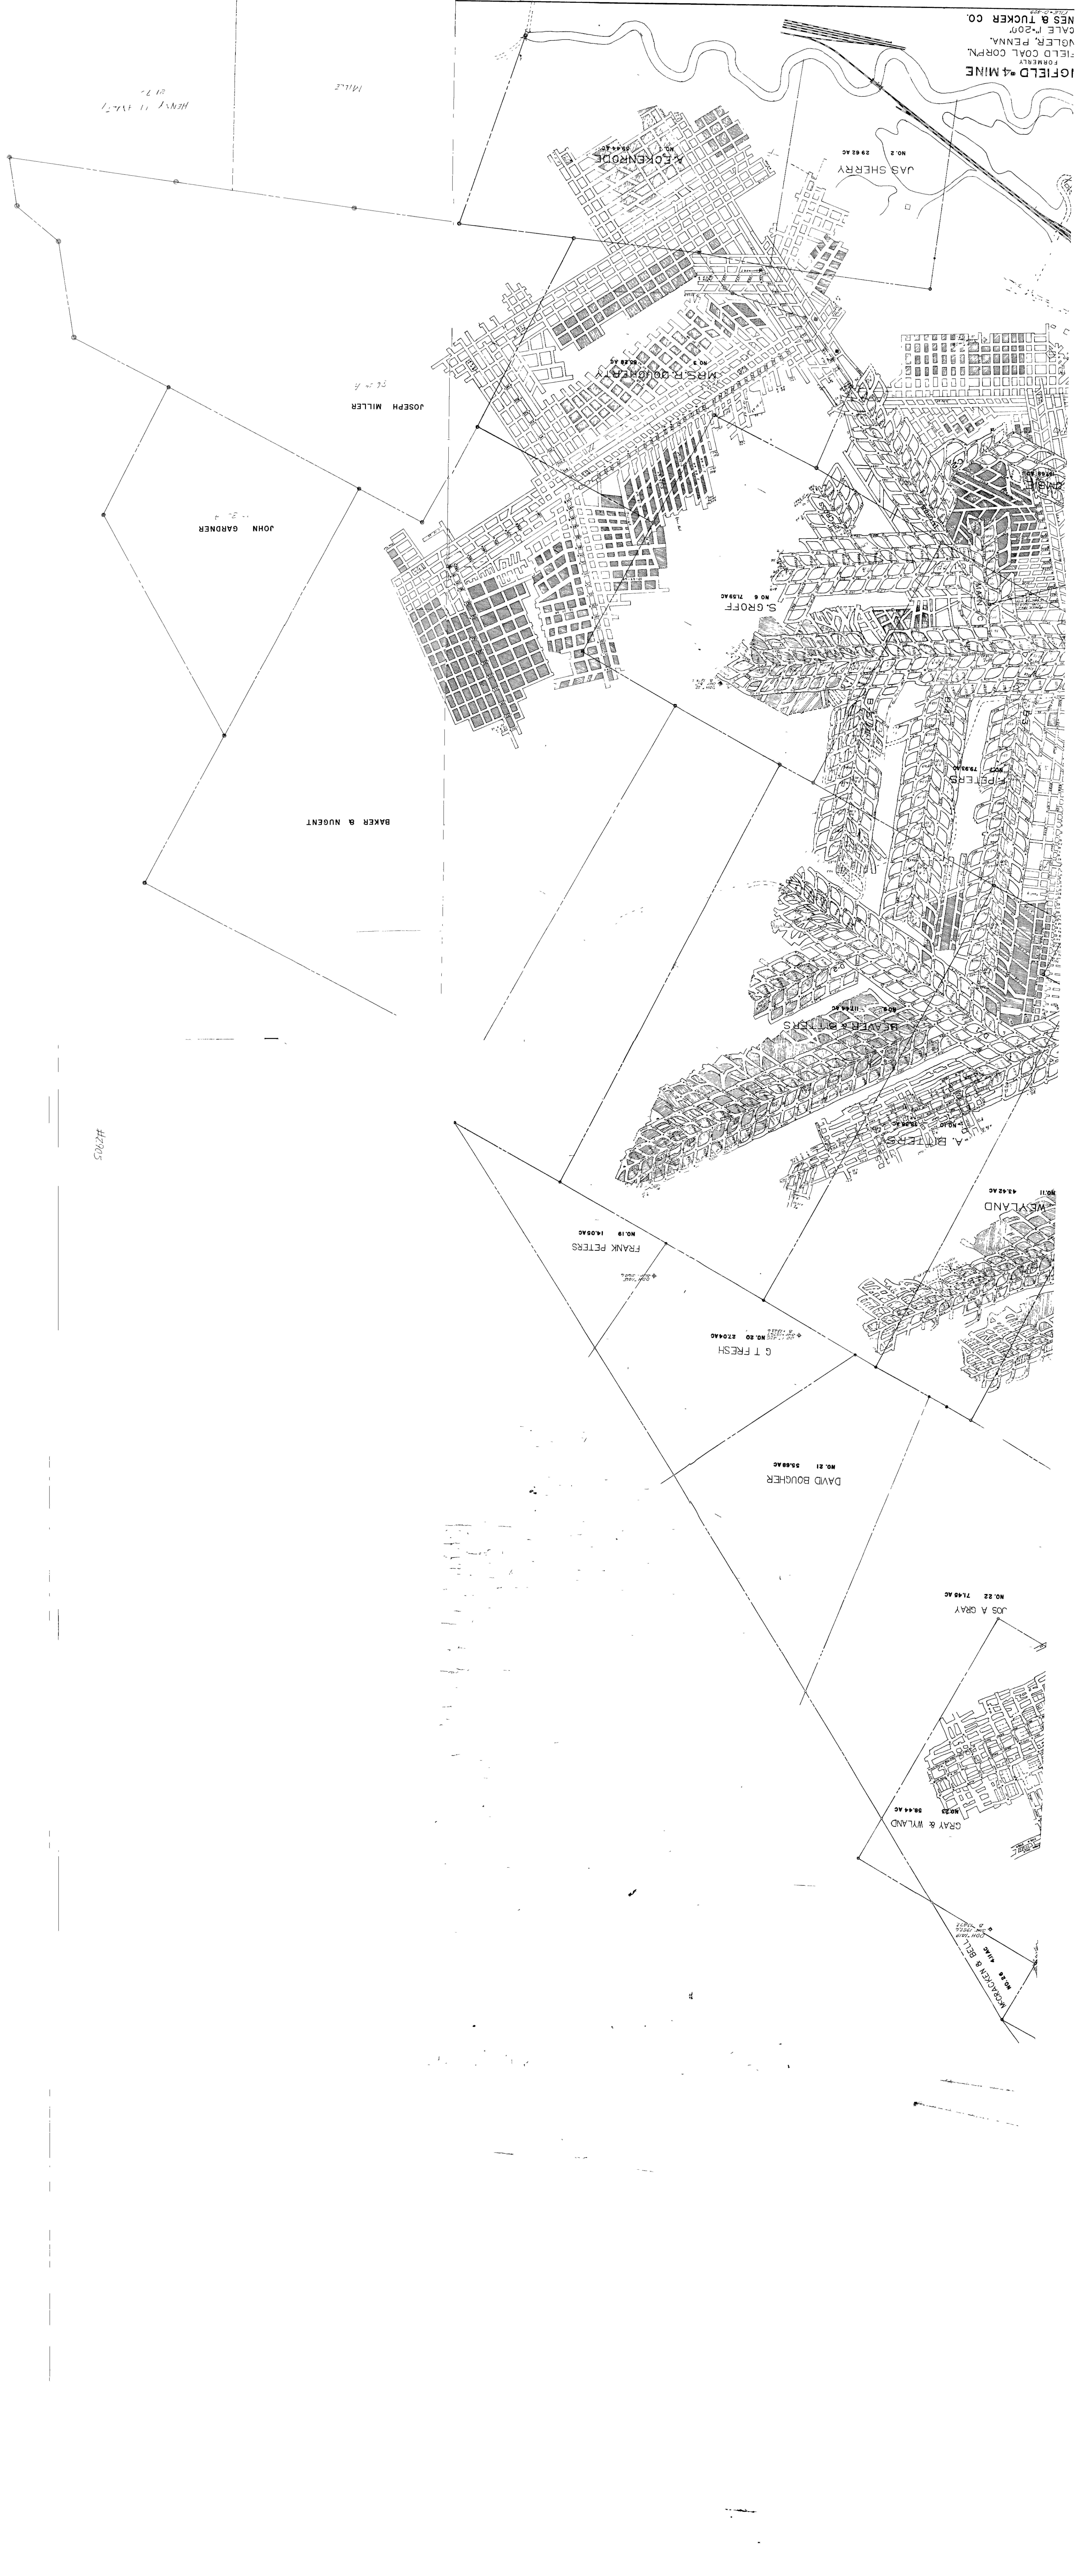

HENRY 11 AVE

MILL

JOSEPH MILLER

JOHN GARDNER

BAKER & NUGENT

#7205