


Join Sheet No. 4

Join Sheet No. 4

Join Sheet No. 4

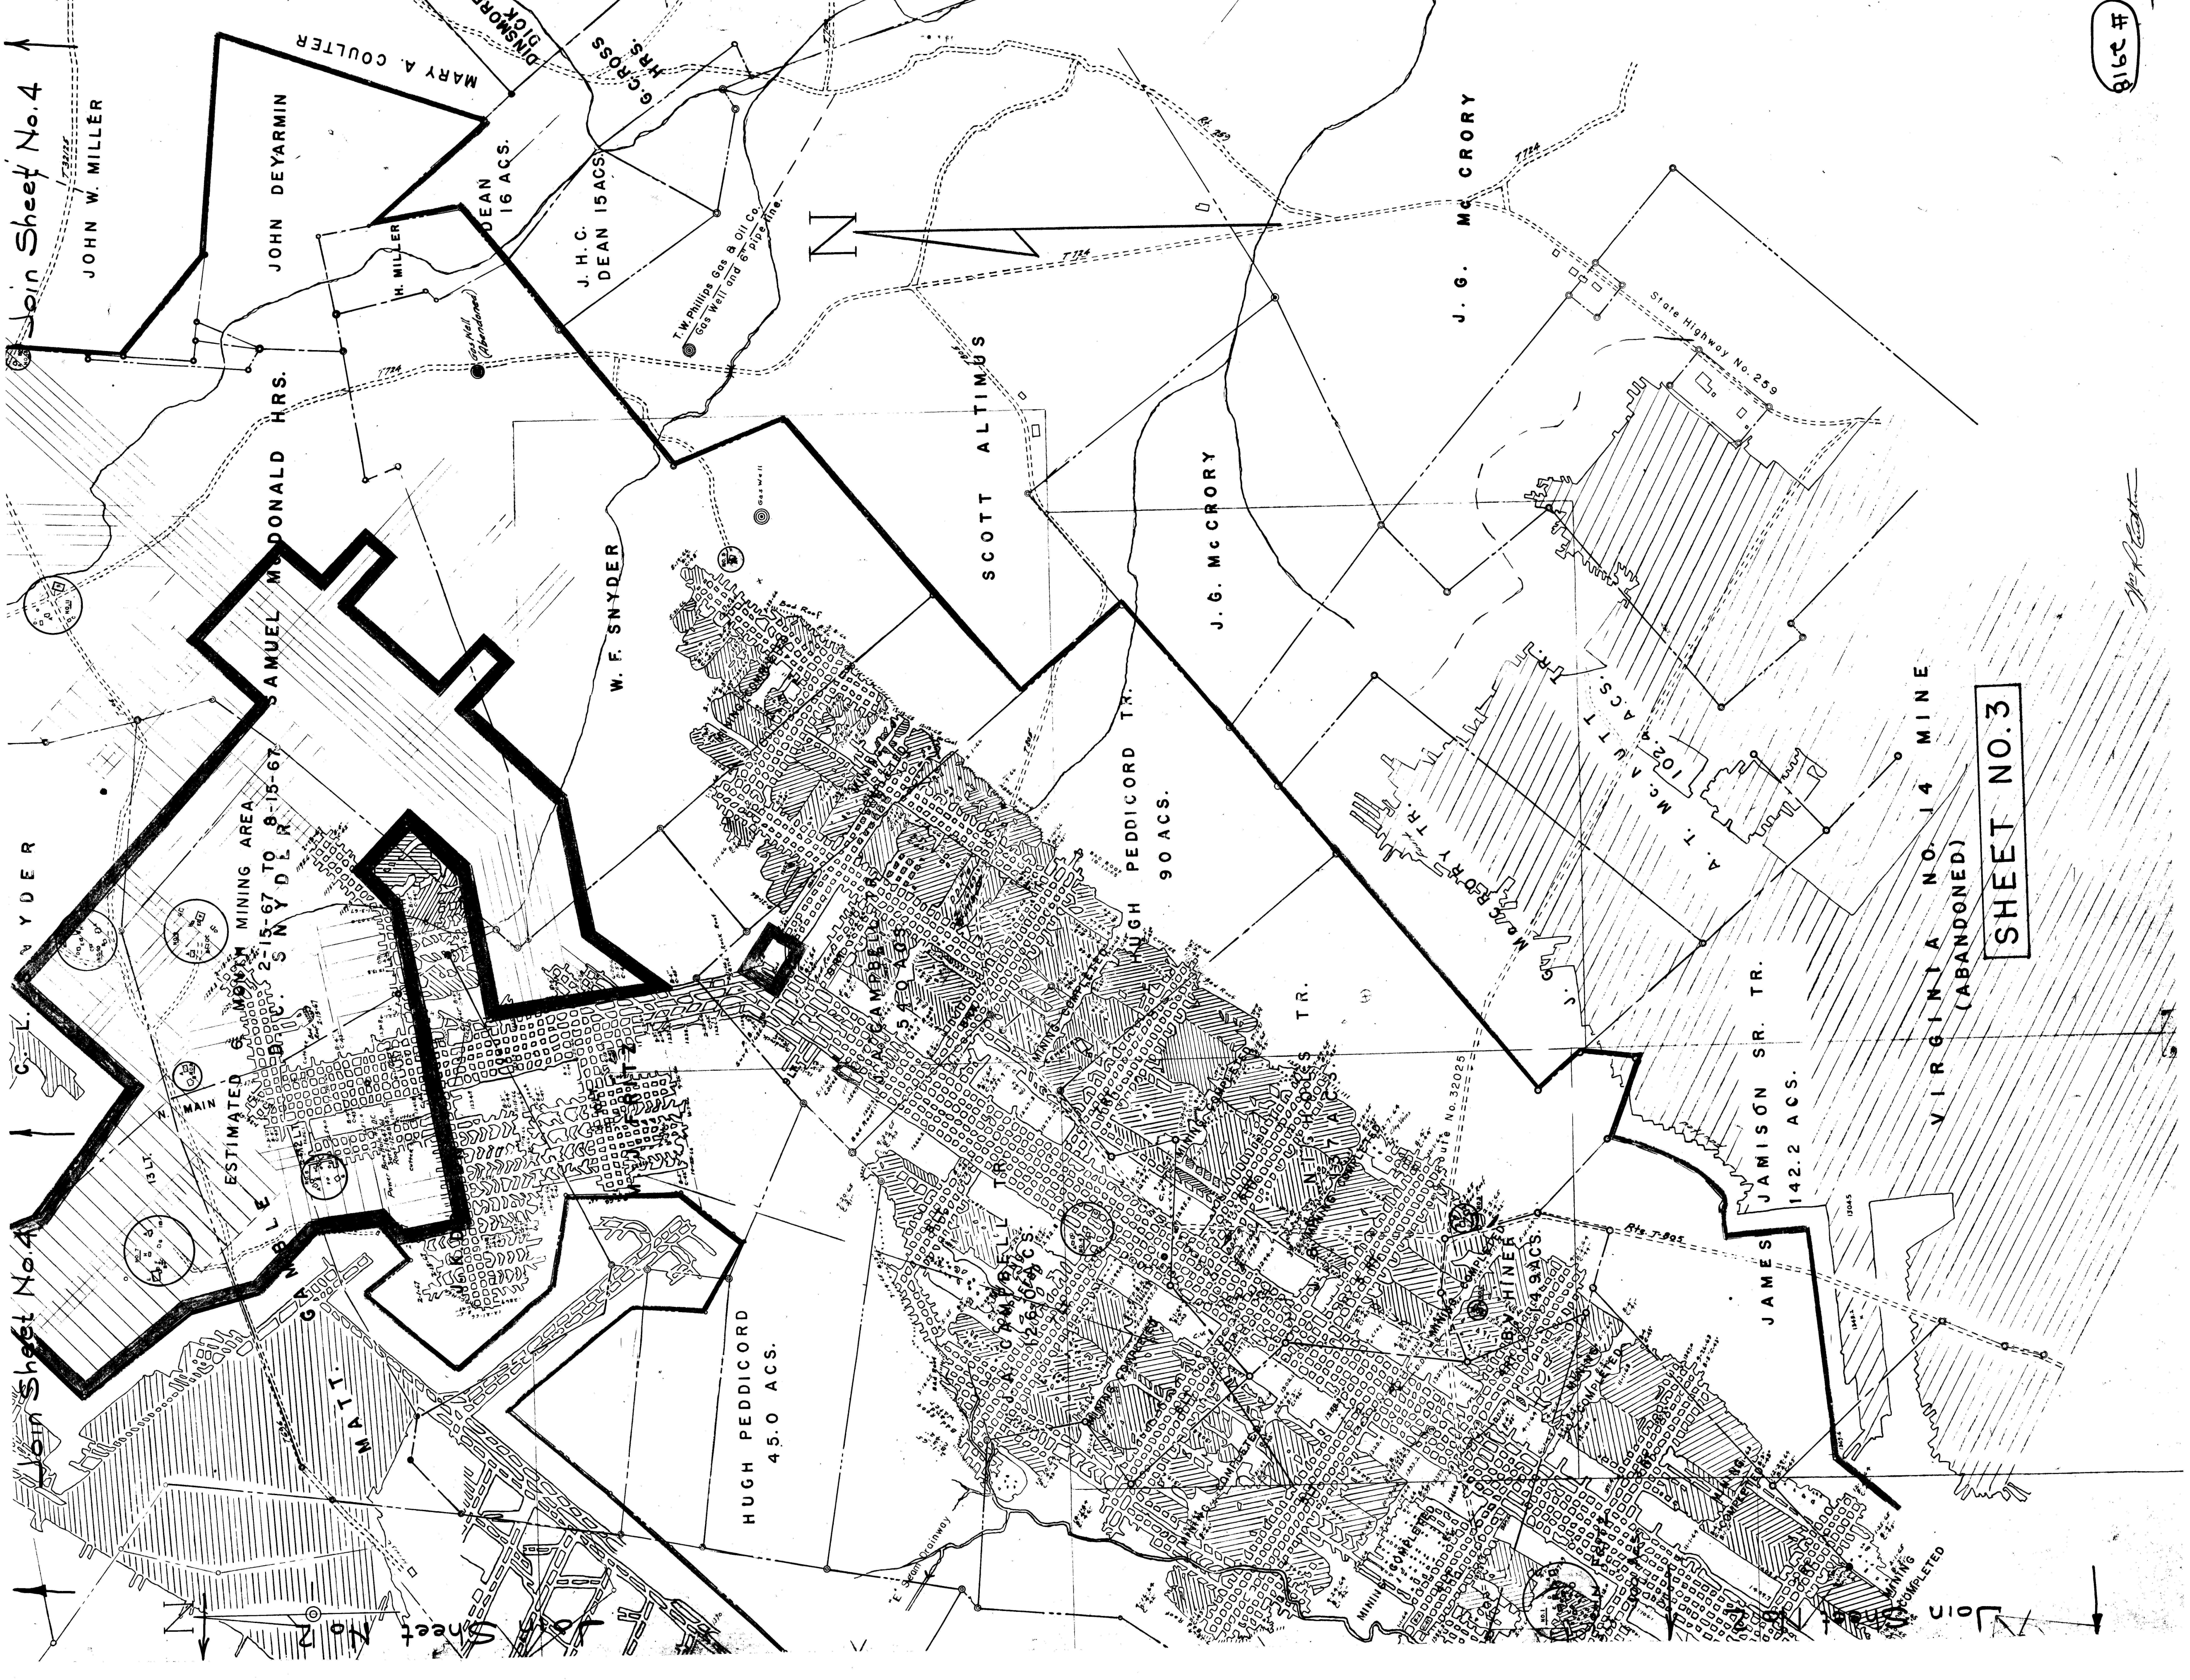

SHEET NO. 3

916c #