


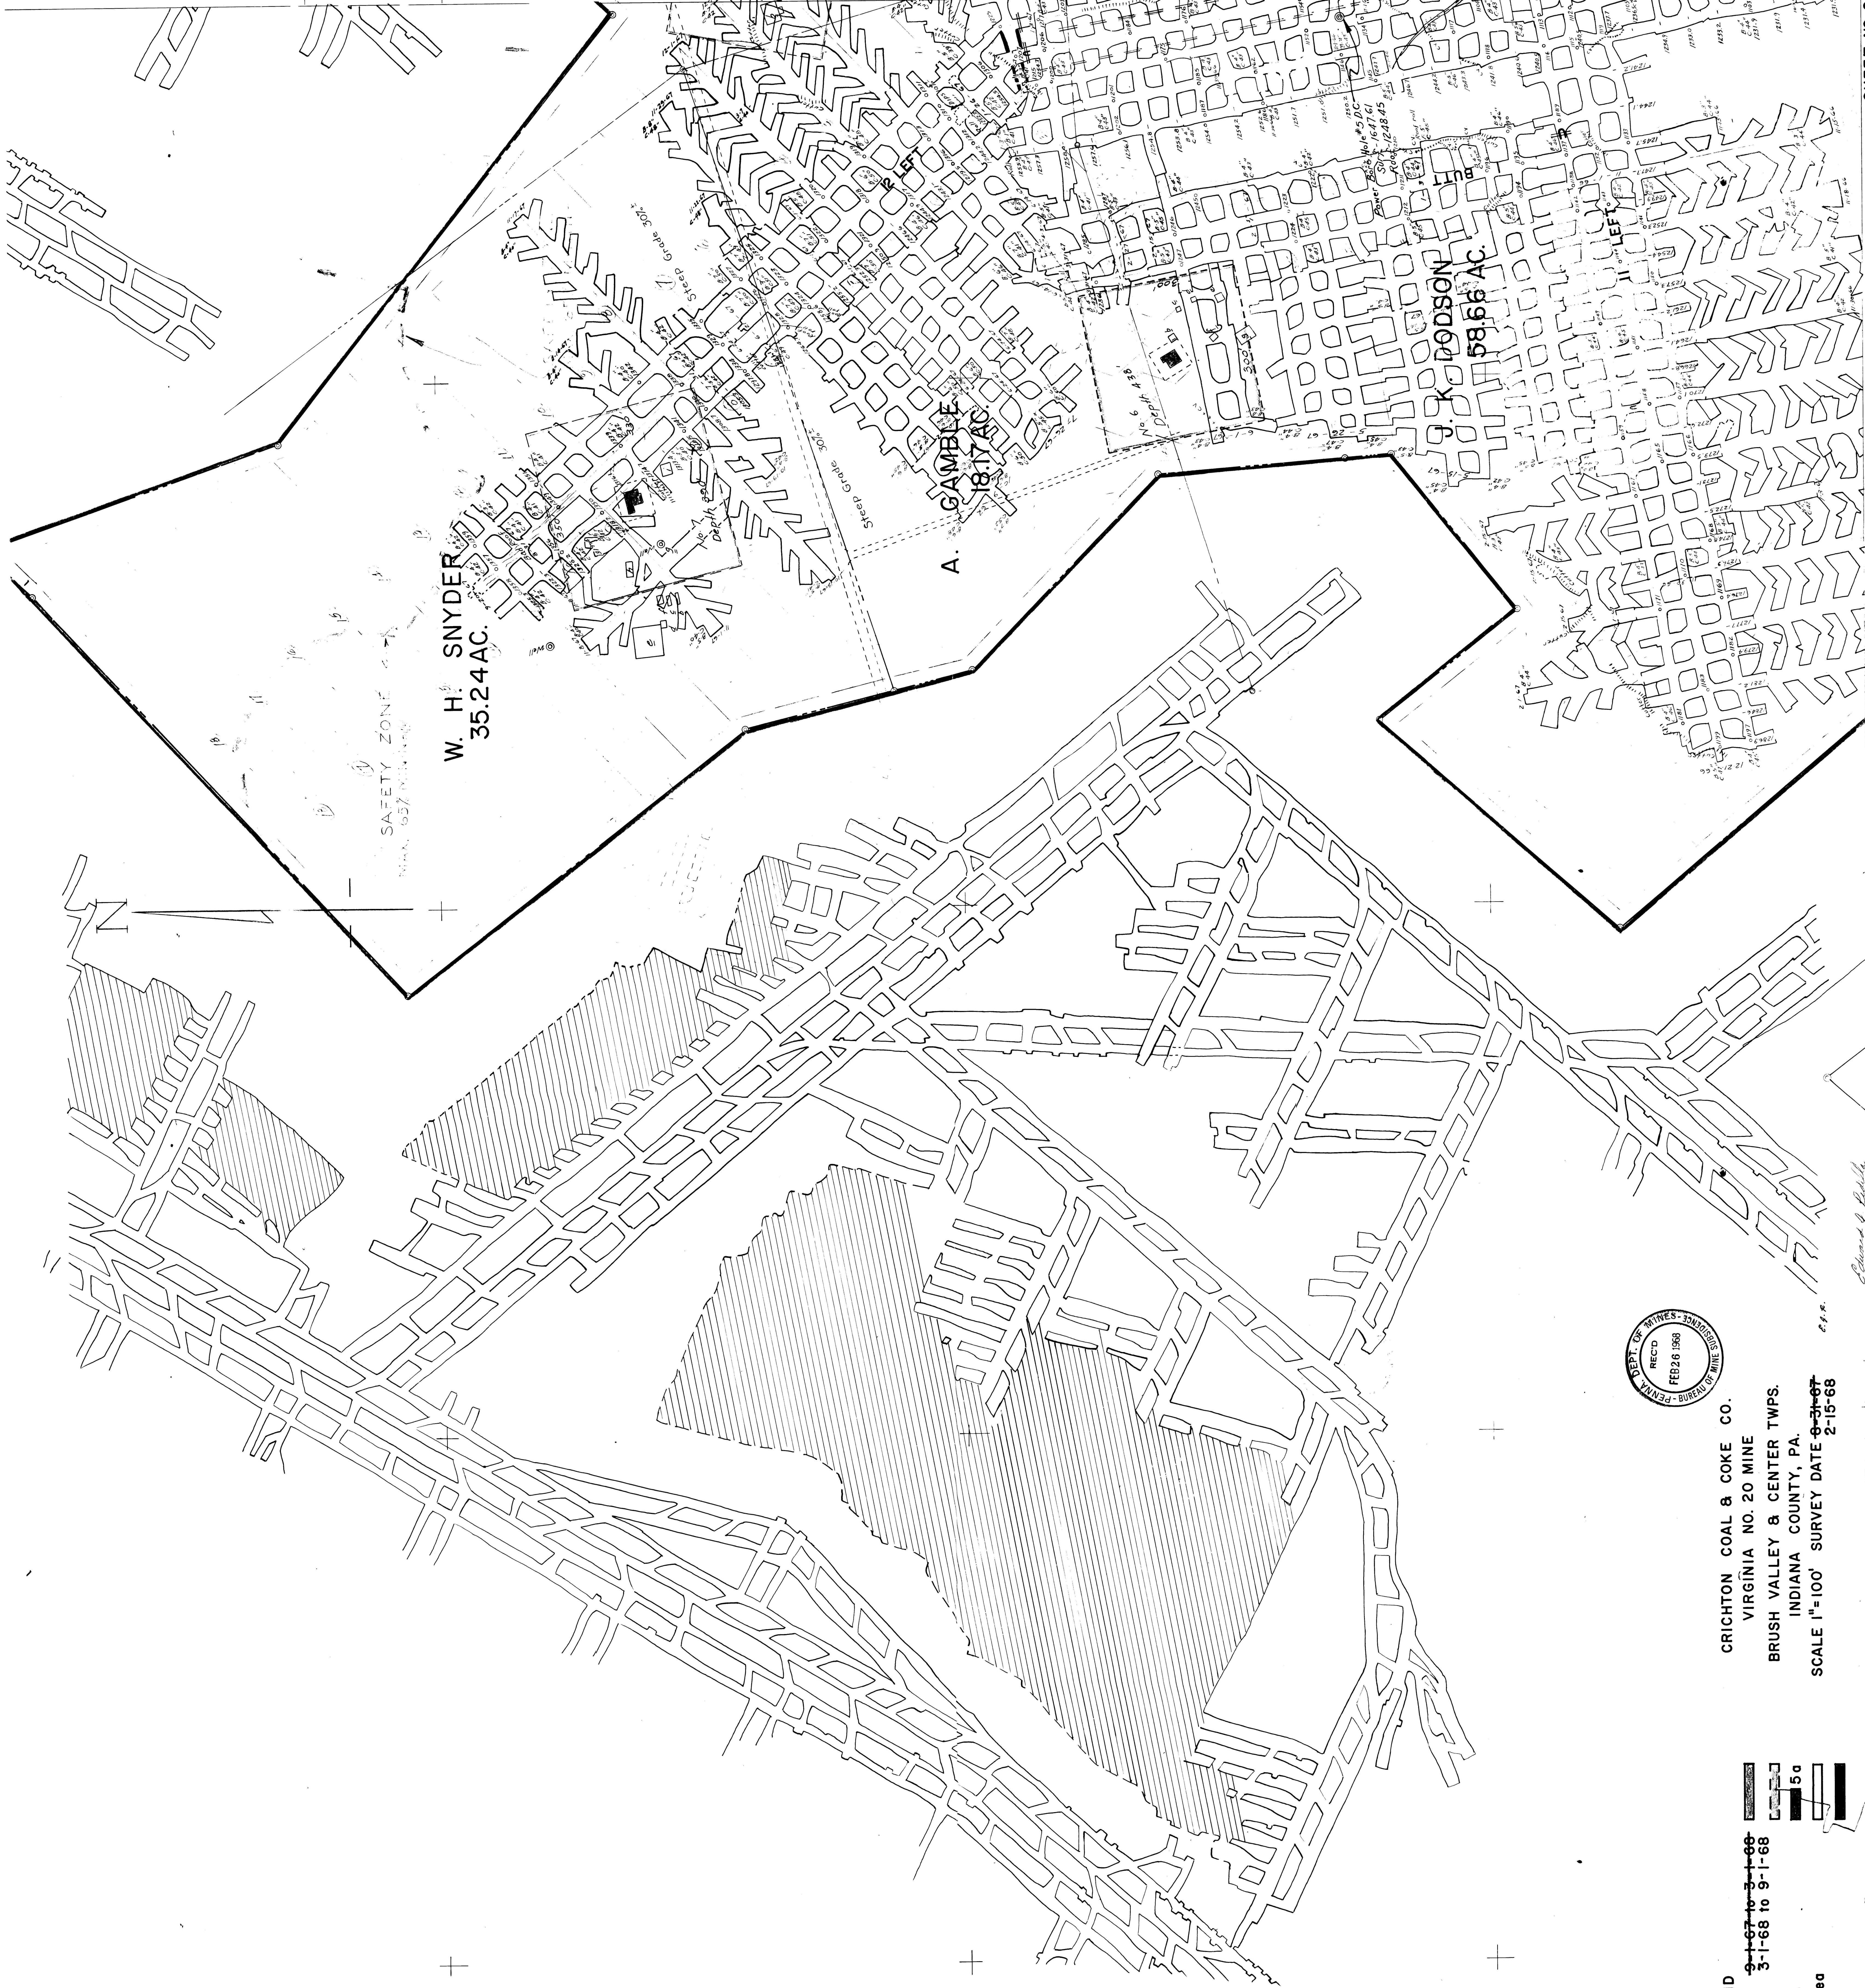

CRICHTON COAL & COKE CO.
VIRGINIA NO. 20 MINE
BRUSH VALLEY & CENTER TOWNSHIPS
INDIANA COUNTY, PA.
SCALE 1"=100' SURVEY DATE 9-30-67

LEGEND
Contemplated Mining 9-1-67 to 3-1-68
Support Area 3-1-68 to 9-1-68
Protected Structures 5a
Mining Completed Area
Boundary Line

Edward J. Ballew