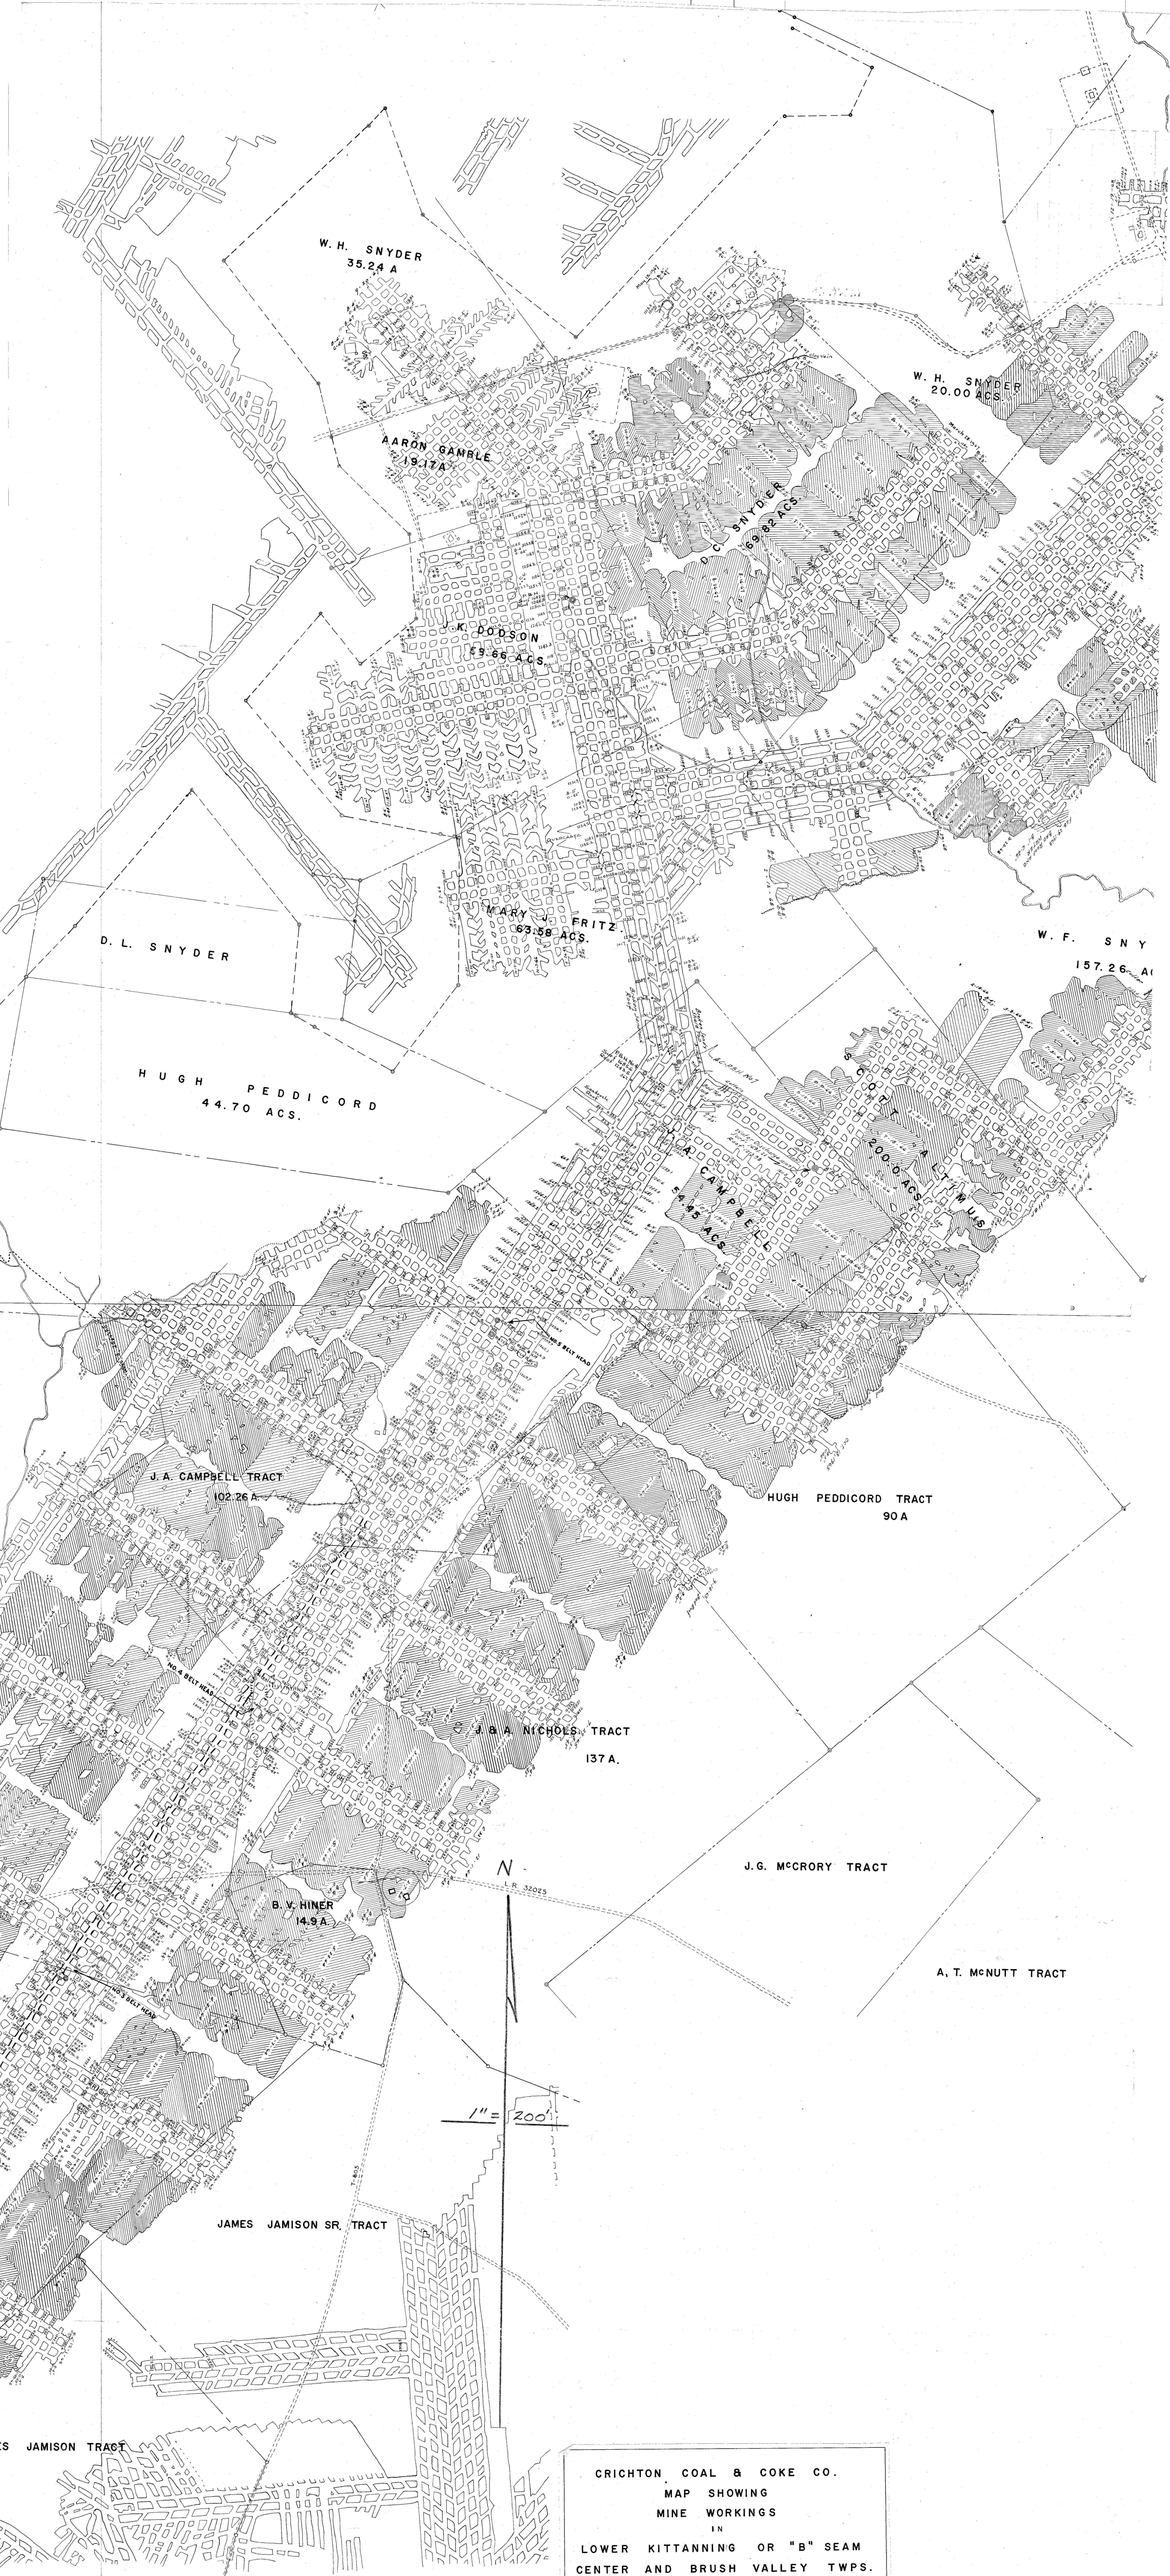

CRICHTON COAL & COKE CO.
MAP SHOWING
MINE WORKINGS
IN
LOWER KITTANNING OR "B" SEAM
CENTER AND BRUSH VALLEY TWPS.