


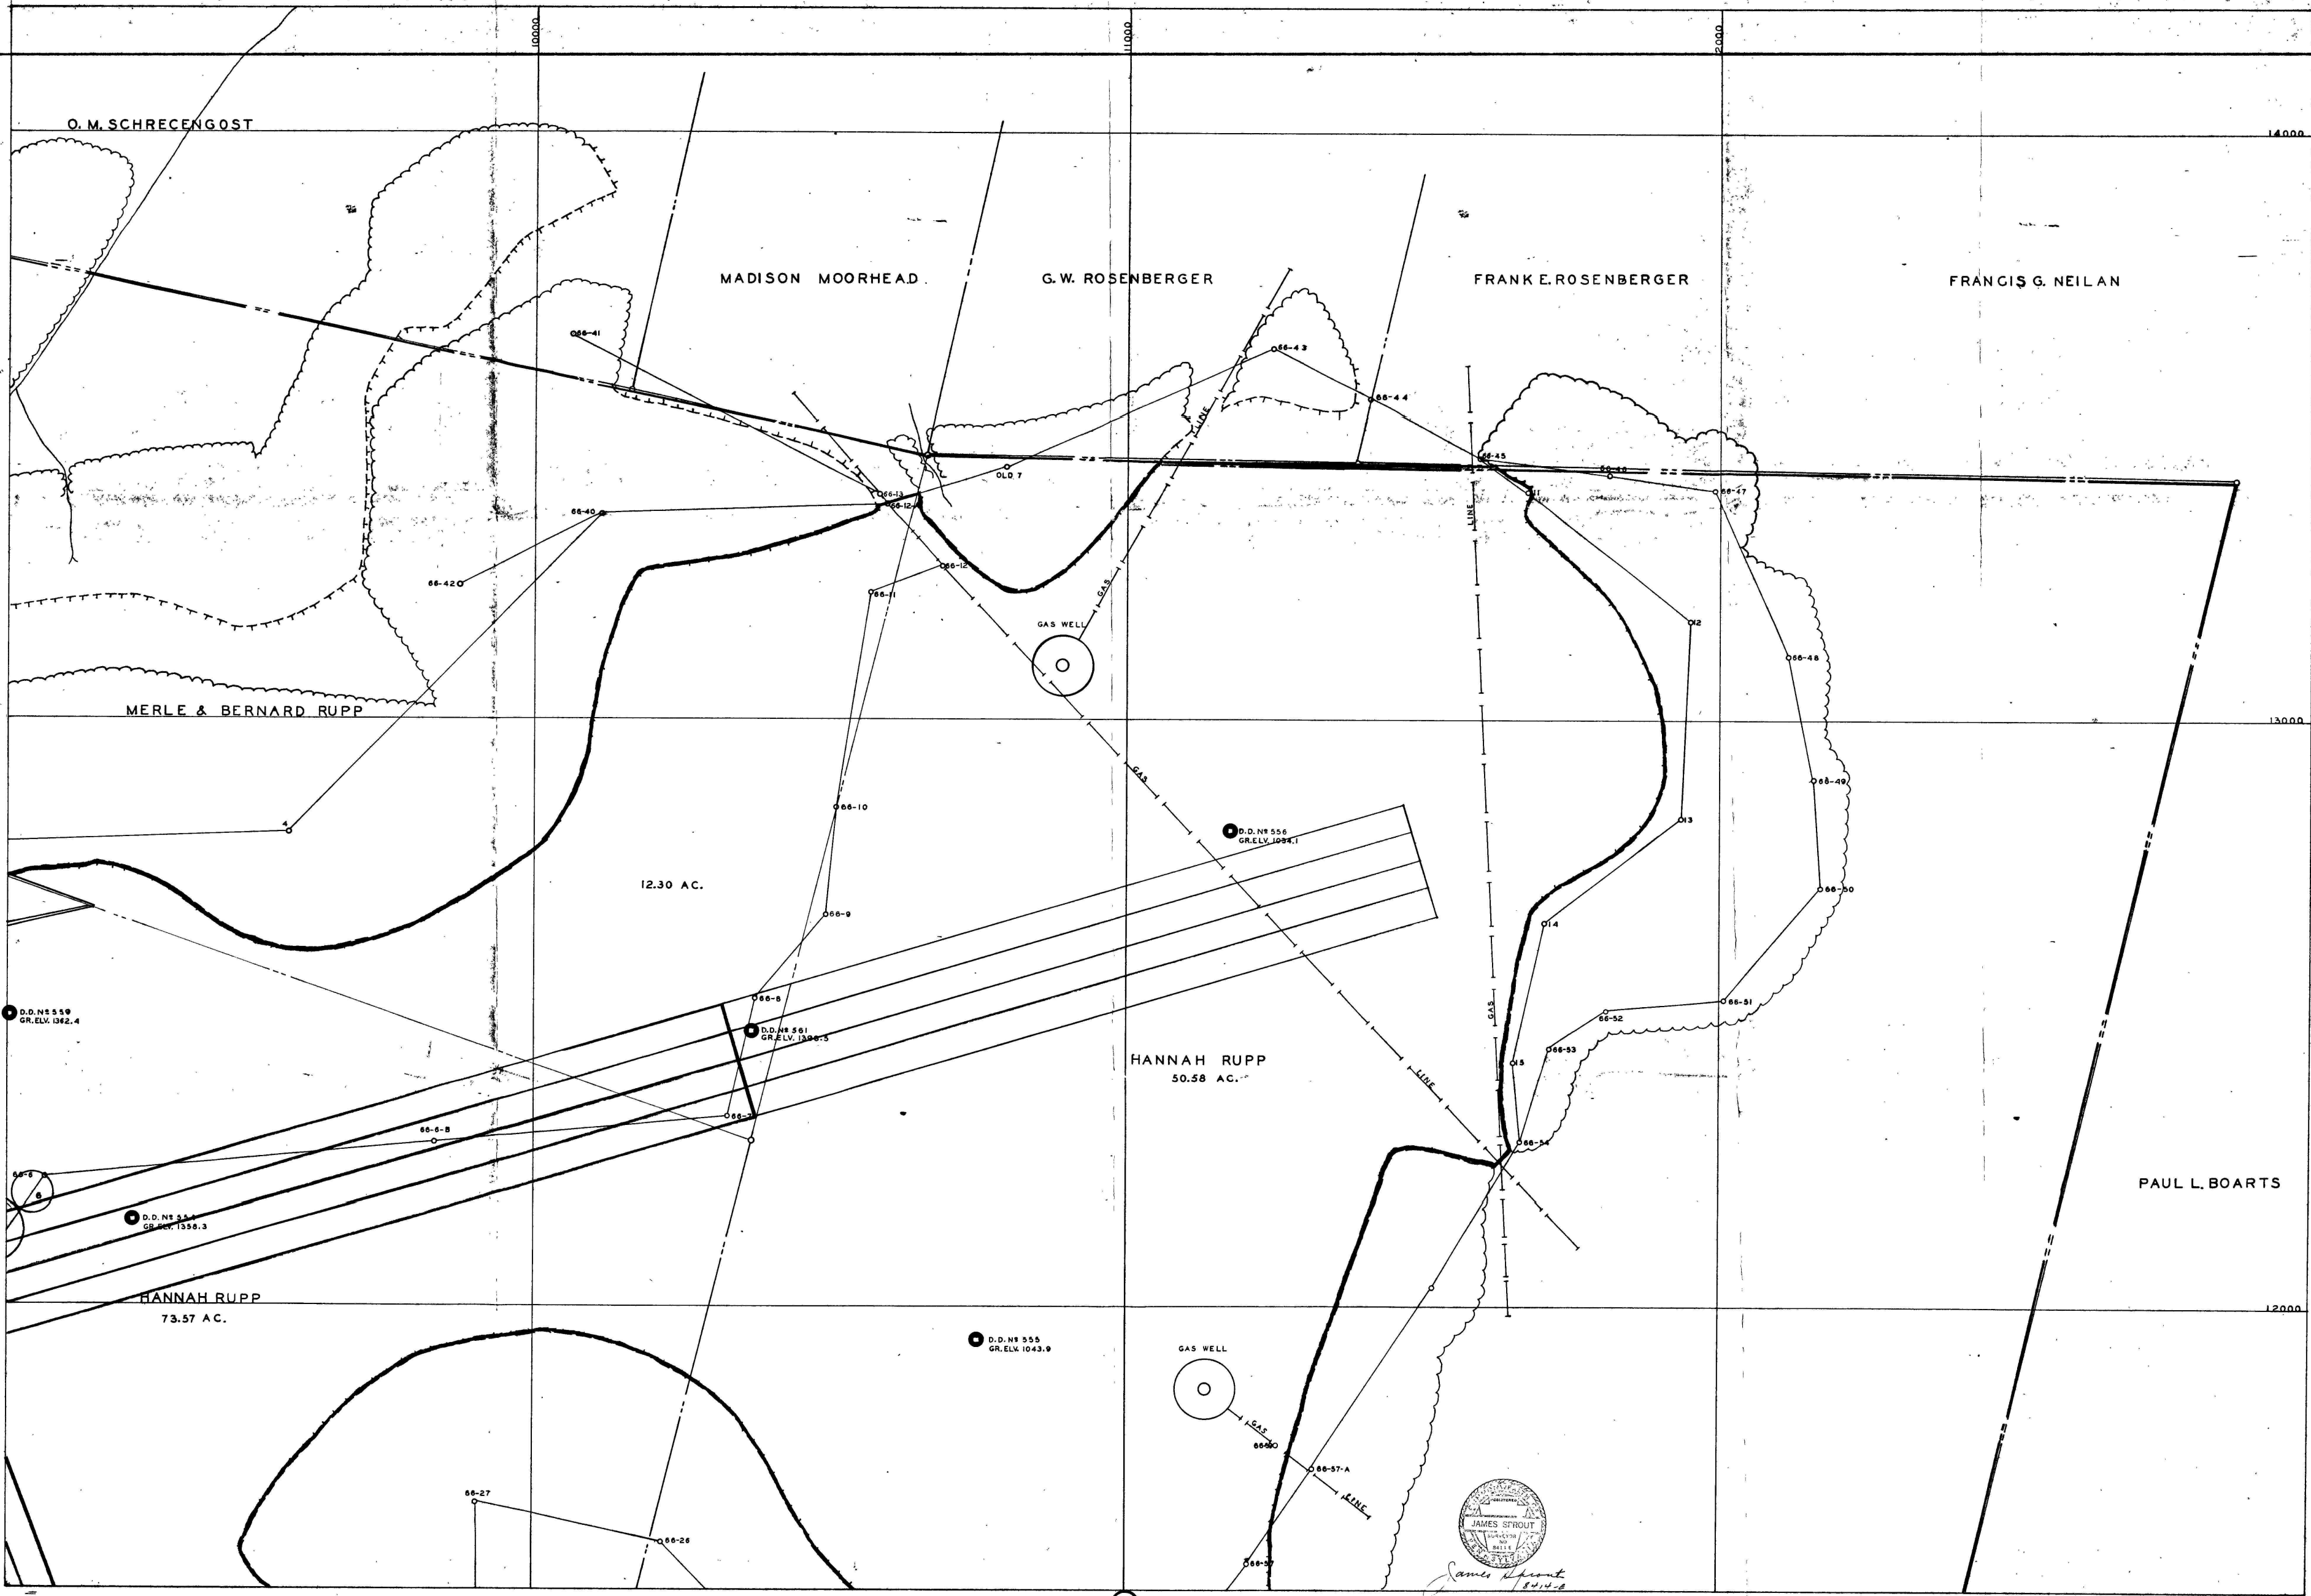

O. M. SCHRECENGOST

MADISON MOORHEAD

G. W. ROSENBERGER

FRANK E. ROSENBERGER

FRANCIS G. NEILAN

MERLE & BERNARD RUPP

12.30 AC.

HANNAH RUPP
50.58 AC.

HANNAH RUPP
73.57 AC.

PAUL L. BOARTS

