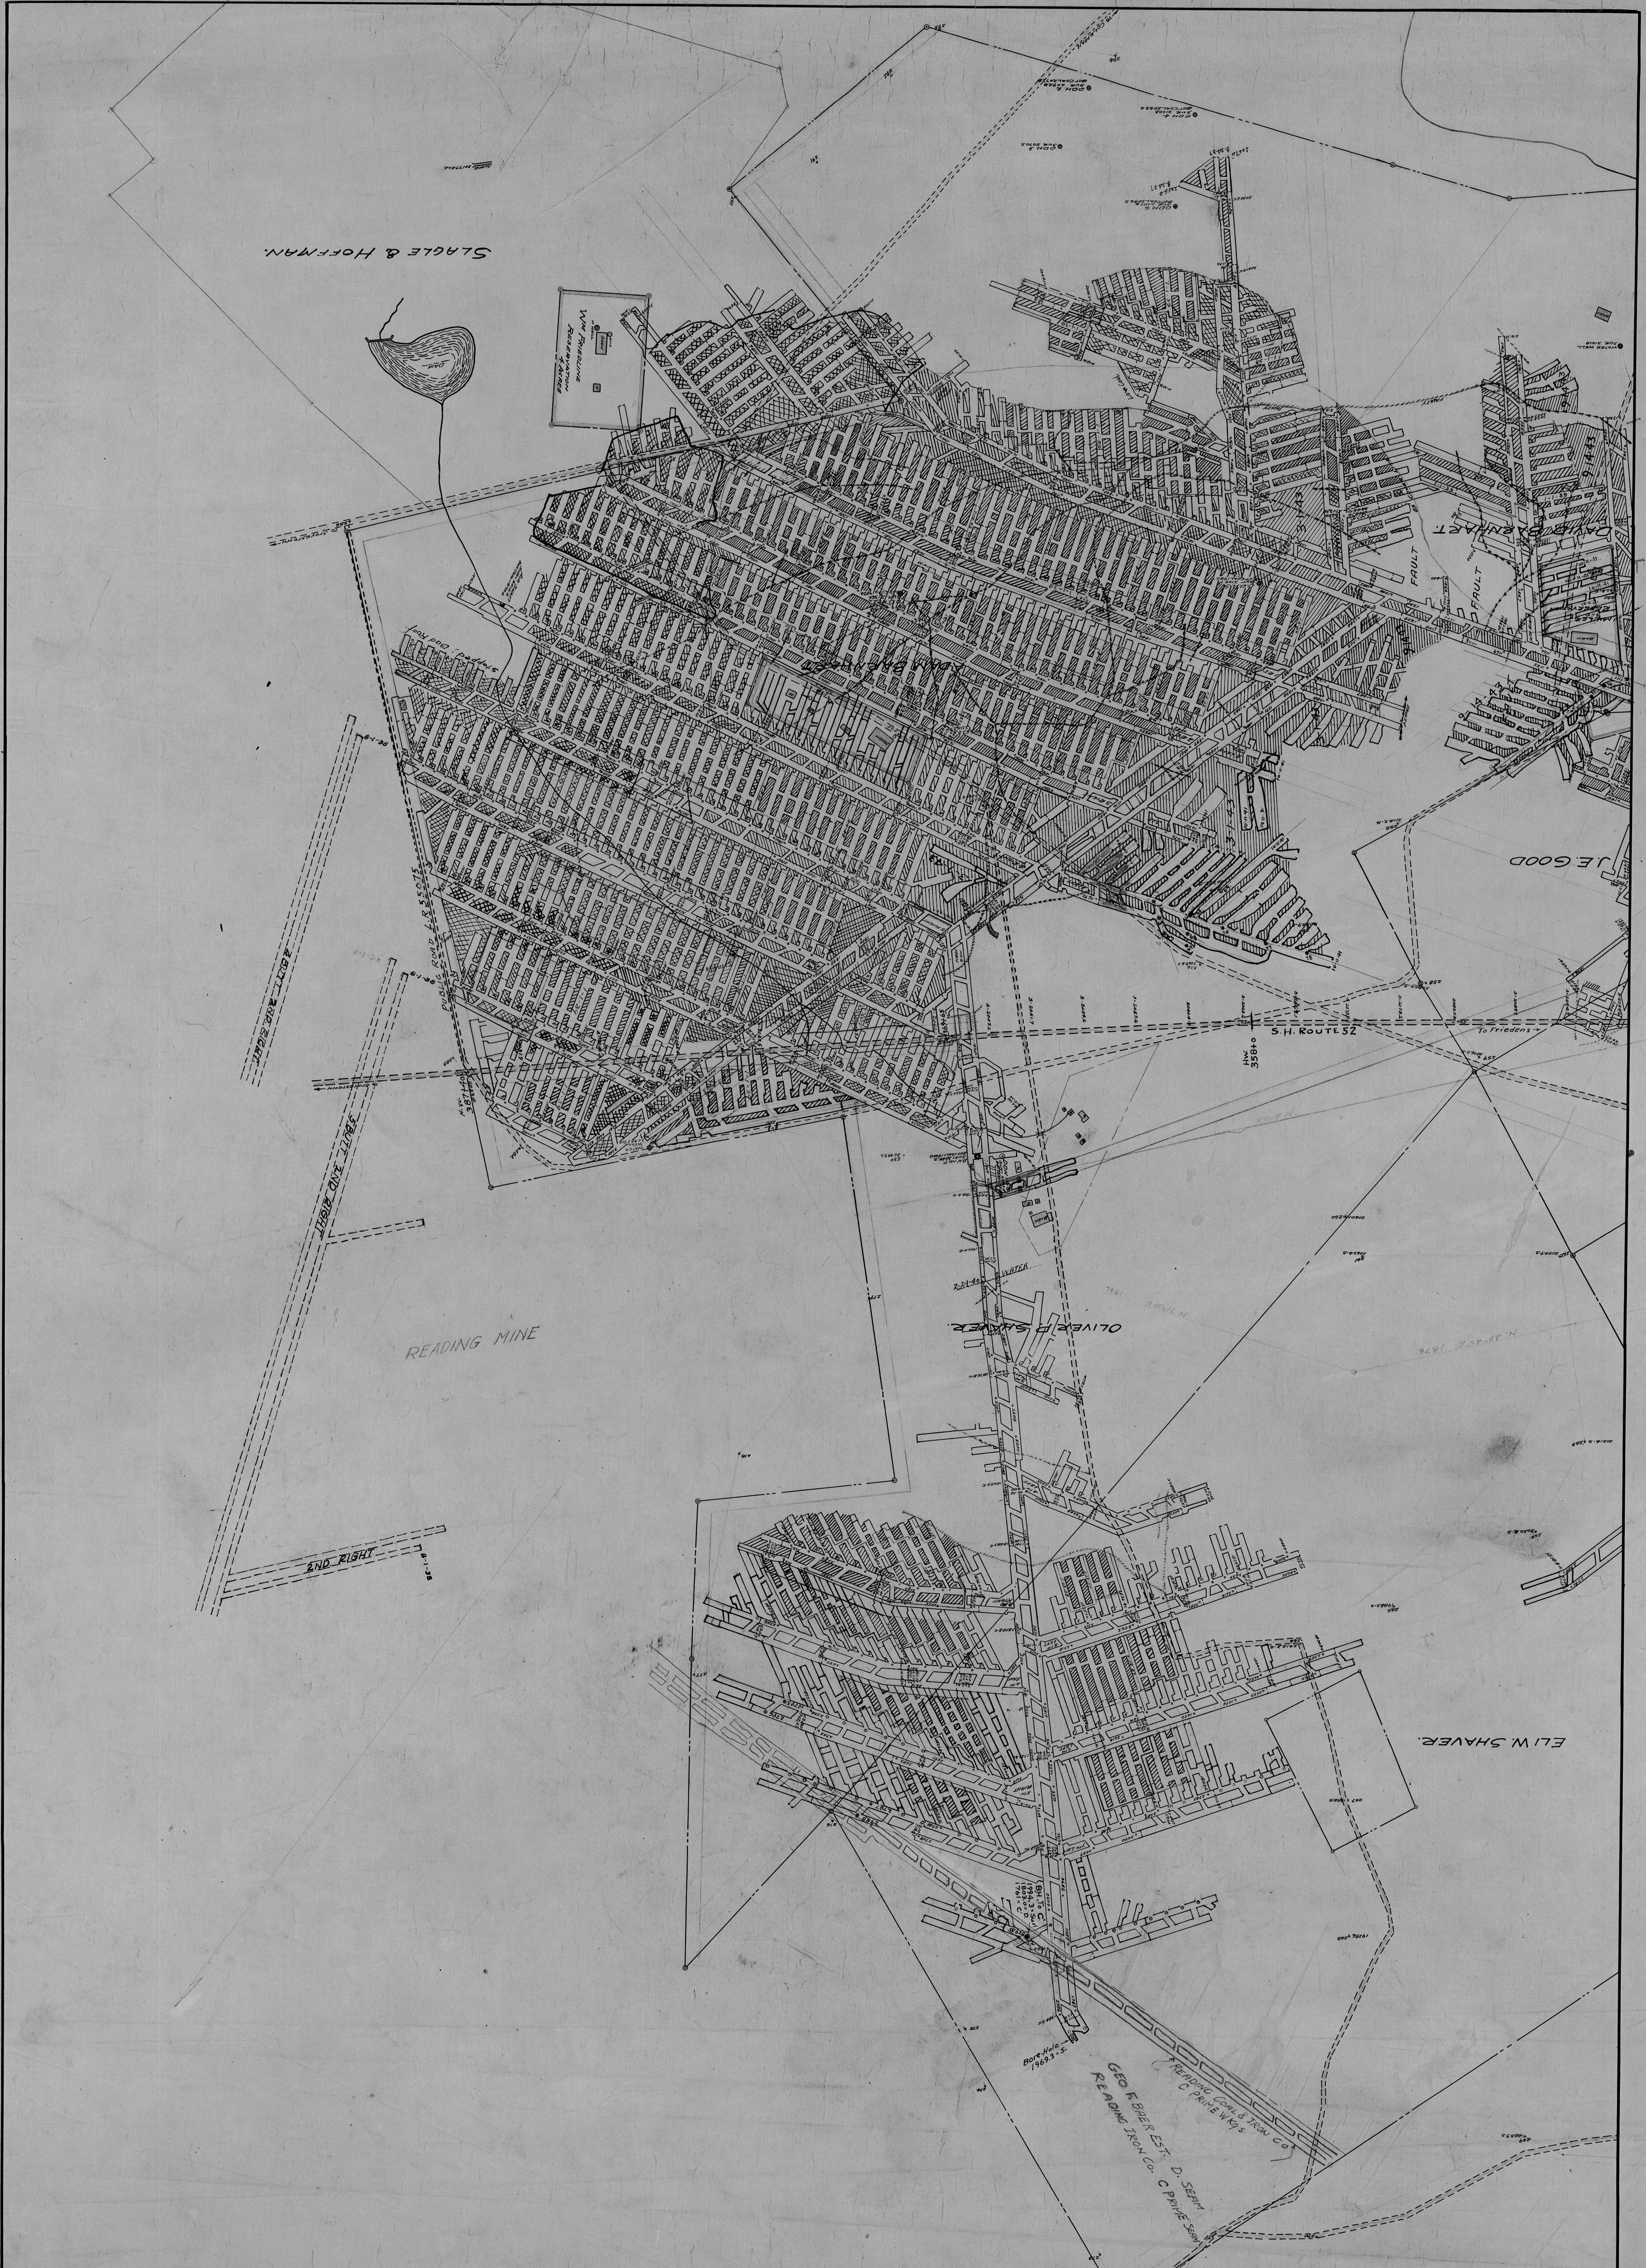
SLAGLE & HOFFMAN.
WM FRIEDLINE RESERVATION 4 ACRES
CABIN
DAM
To STOYESTOWN
Stopped; Bad Roof
GDH 2 SUR. 2092.8 Bot COAL 2072.8
GDH 3 SUR. 2070.5
GDH 4 SUR. 2100.8 Bot COAL 2062.6
GDH 6 SUR. 2082.8 Bot COAL 2046.2
8-24-37
WATER WELL SUR. 2101.8
LOW COAL
1-1-39
3-1-43
9-1-43
9-14-43
10-11-41
DAVID BARNHART.
FAULT
FAULT
J.E. GOOD
PUBLIC ROAD L.R. 55075
H.W. 387+0
S.H. ROUTE 52
To Friedens →
HW. 358+0
4 BUTT 2ND RIGHT
3 BUTT 2ND RIGHT
6-1-38
2ND. RIGHT
8-1-38
READING MINE
2-2-40
WATER
OLIVER P. SHAVER.
N 40°45' E 1876
ELI W. SHAVER.
BH. To C 1994.3 Surf. 1803.0 D 1761 C
Bore Hole 1969.3 S.
READING COAL & IRON CO. C PRIME WKGS
GEO. F. BAER EST. D. SEAM
READING IRON CO. C PRIME SEAM