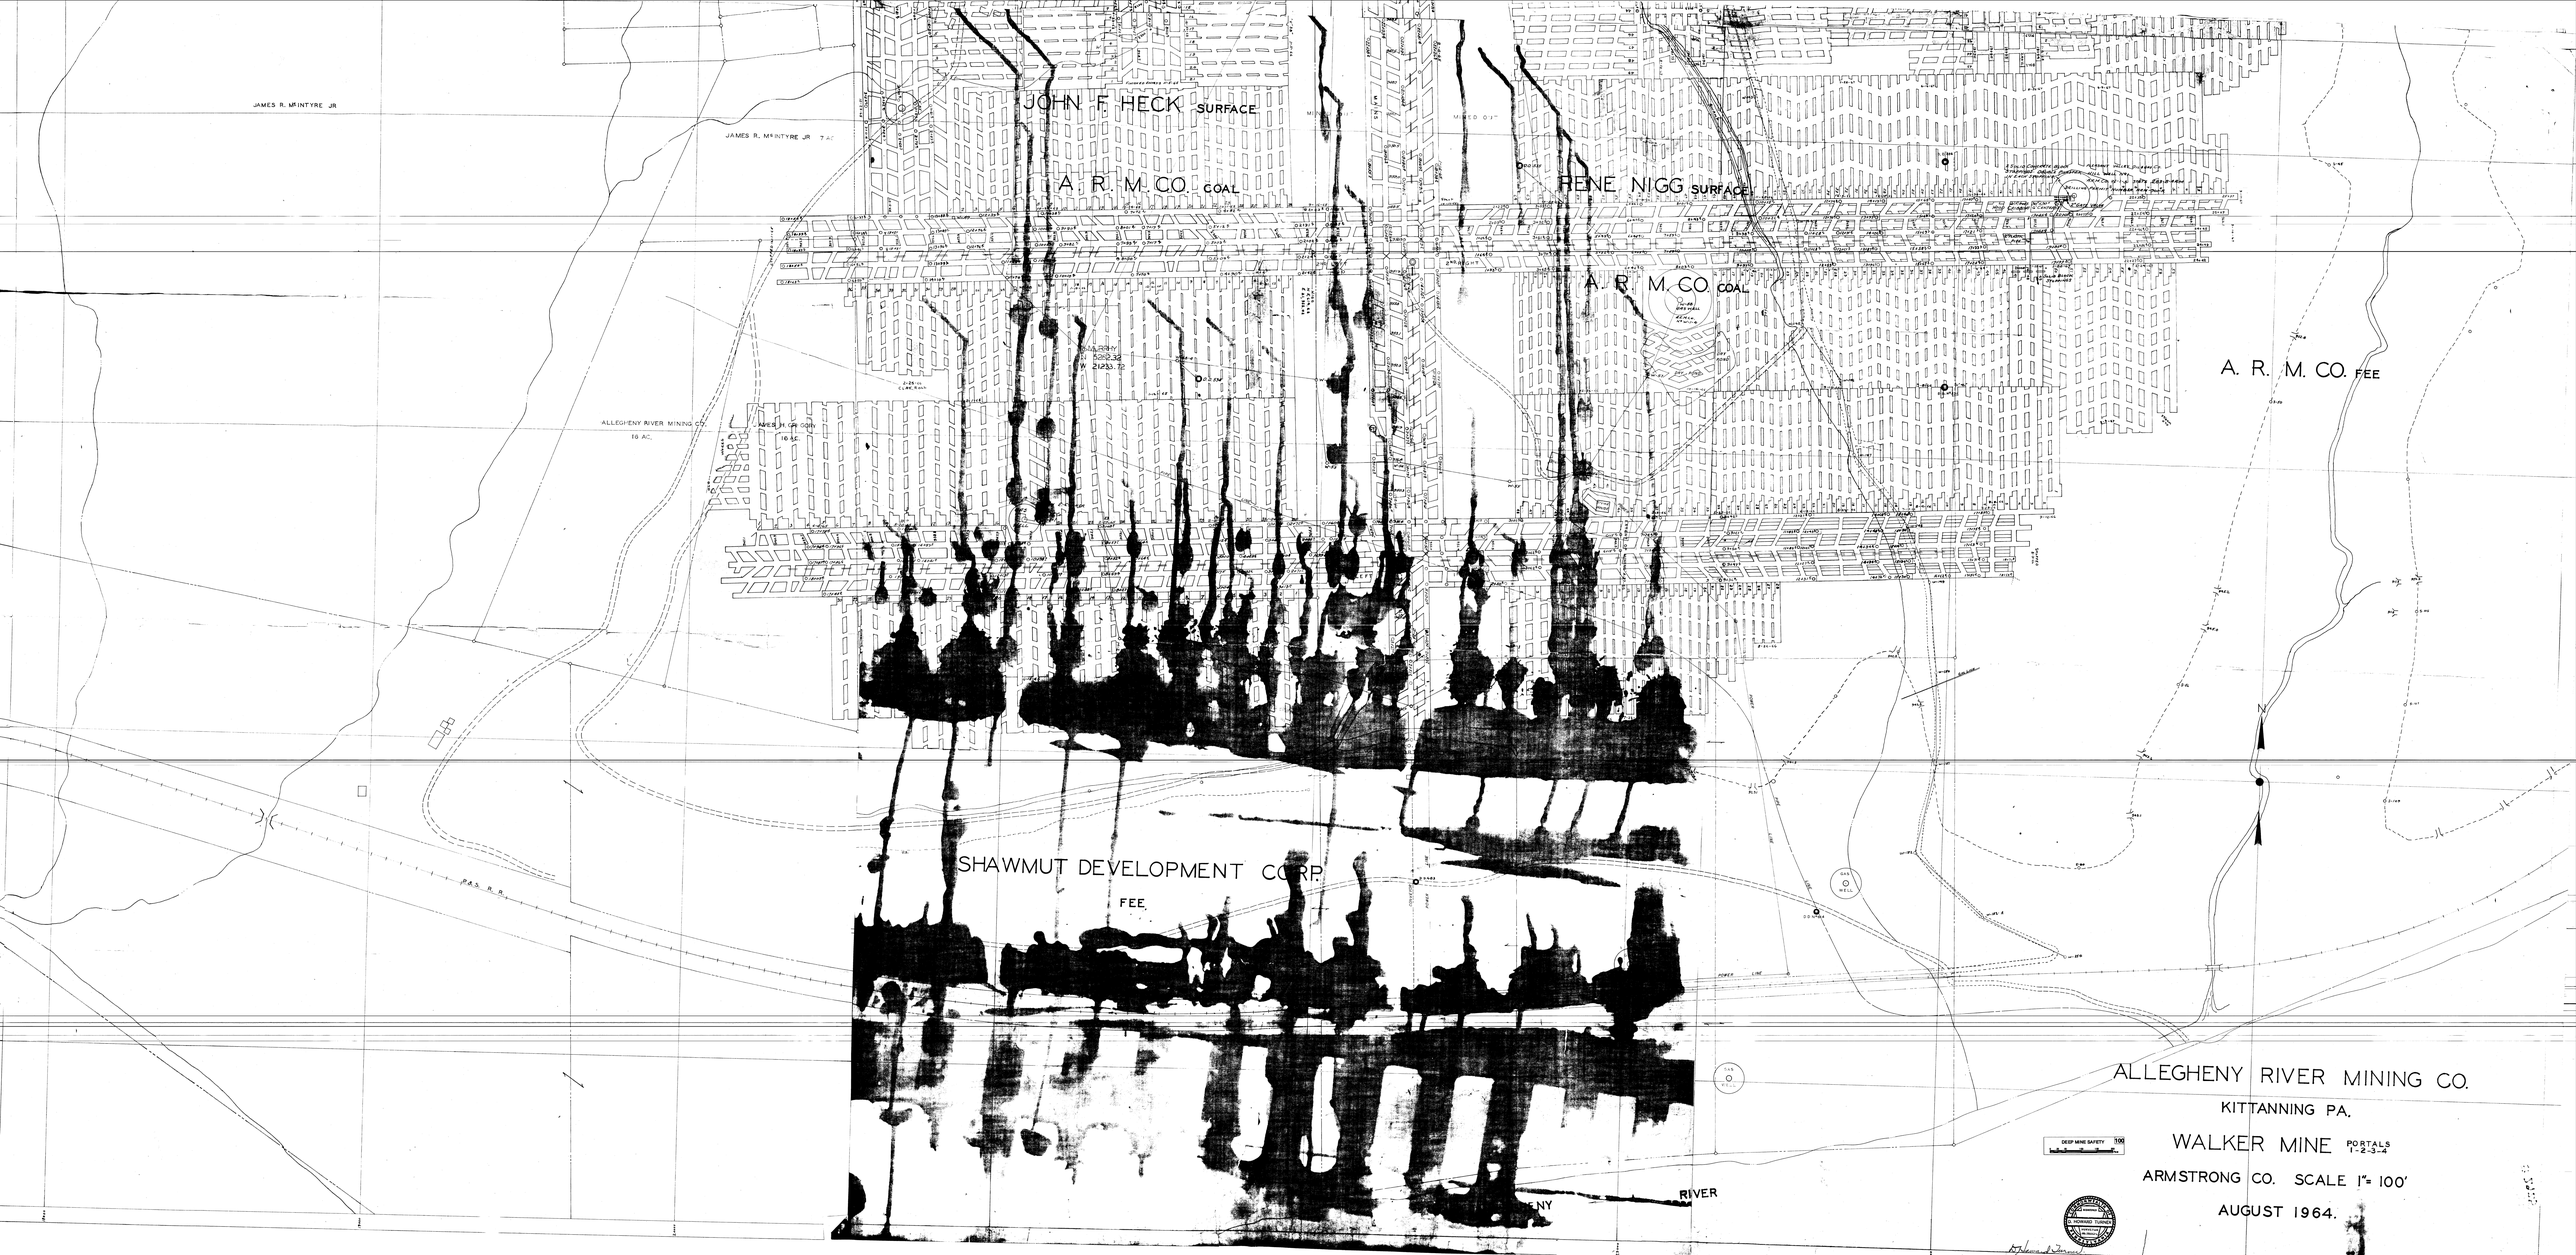
JOHN F HECK SURFACE
A. R. M. CO. COAL
RENE NIGG SURFACE
A. R. M. CO. COAL
A. R. M. CO. FEE
SHAWMUT DEVELOPMENT CORP.
FEE
JAMES R. McINTYRE JR
JAMES R. McINTYRE JR 7 AC.
ALLEGHENY RIVER MINING CO.
16 AC.
JAMES H. GA CORP.
10 AC.
P.R.R.
RIVER
N
ALLEGHENY RIVER MINING CO.
KITTANNING PA.
WALKER MINE PORTALS 1-2-3-4
ARMSTRONG CO. SCALE 1"= 100'
AUGUST 1964.
DEEP MINE SAFETY 100