


UNITED STATES
DEPARTMENT OF THE INTERIOR
GEOLOGICAL SURVEY


STATE OF PENNSYLVANIA
REPRESENTED BY THE
DEPARTMENT OF INTERNAL AFFAIRS
TOPOGRAPHIC AND GEOLOGIC SURVEY

PAINT TOWNSHIP
SOMERSET COUNTY
PERMIT NUMBER - 183-1
C-PRIME OR UPPER KITTANNING SBAM
PENNSYLVANIA
WINDBER QUADRANGLE

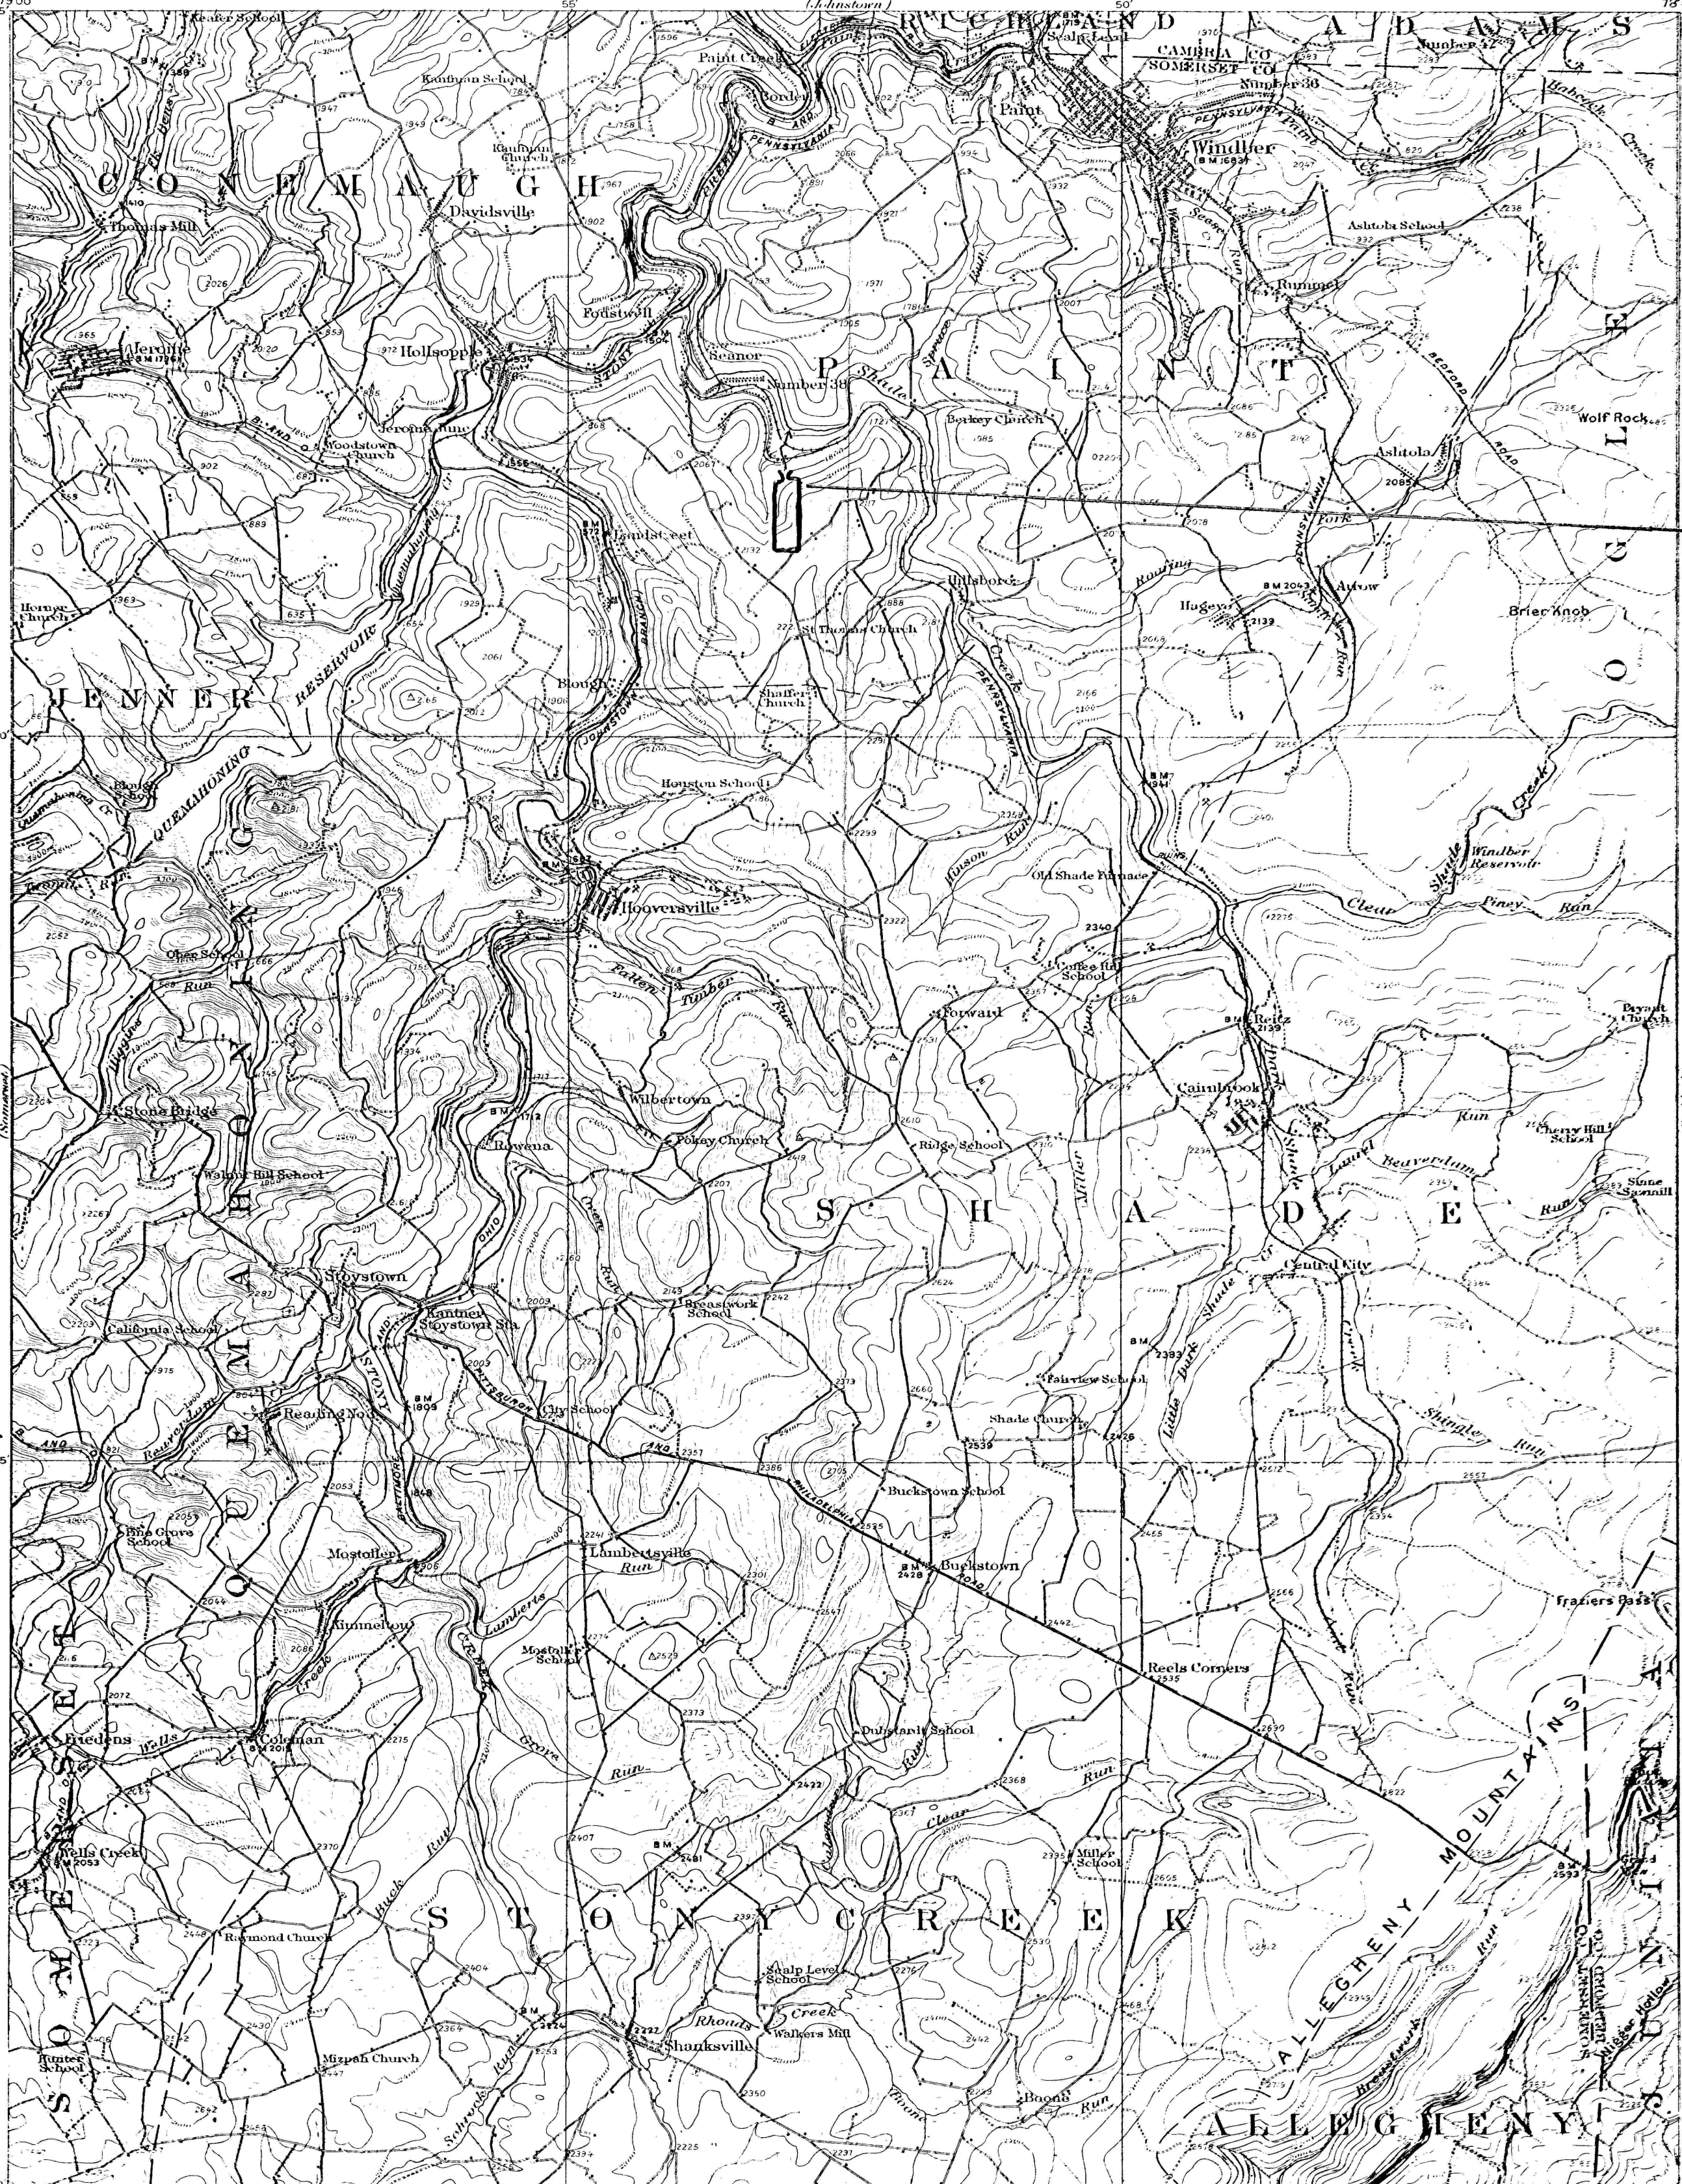

Ralph Bloom Jr.
Mine # 1.
Paint Twp.
Somerset Co.
Penna.
Located By
M.H. Tamm, Esq.
Reg. No. 13535.

R. E. Marshall, Chief Geographer.
Frank Suttan, Geographer in charge.
Topography by Robert Muldrow, Oscar Jones,
E. E. White, Leon, and E. D. Monroe.
Control by Geo. T. Hawkins and T. A. Green.
Surveyed in 1913-1914.

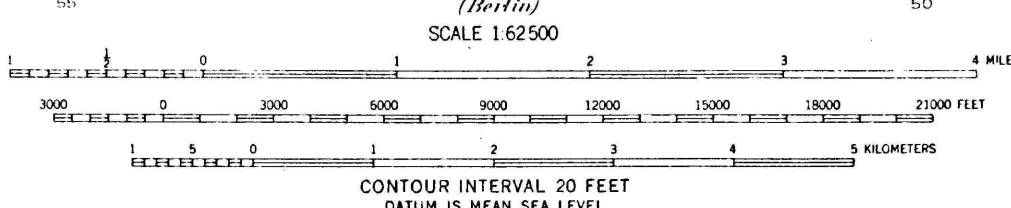

INTERIOR GEOLOGICAL SURVEY WASHINGTON D. C. 20508 MR 4833
Polyconic projection. 1927 North American datum

PA
WINDBER
N 40° 00' - 47° 30' E
134

FOR SALE BY U. S. GEOLOGICAL SURVEY, WASHINGTON 25, D. C.
A FOLDER DESCRIBING TOPOGRAPHIC MAPS AND SYMBOLS IS AVAILABLE ON REQUEST