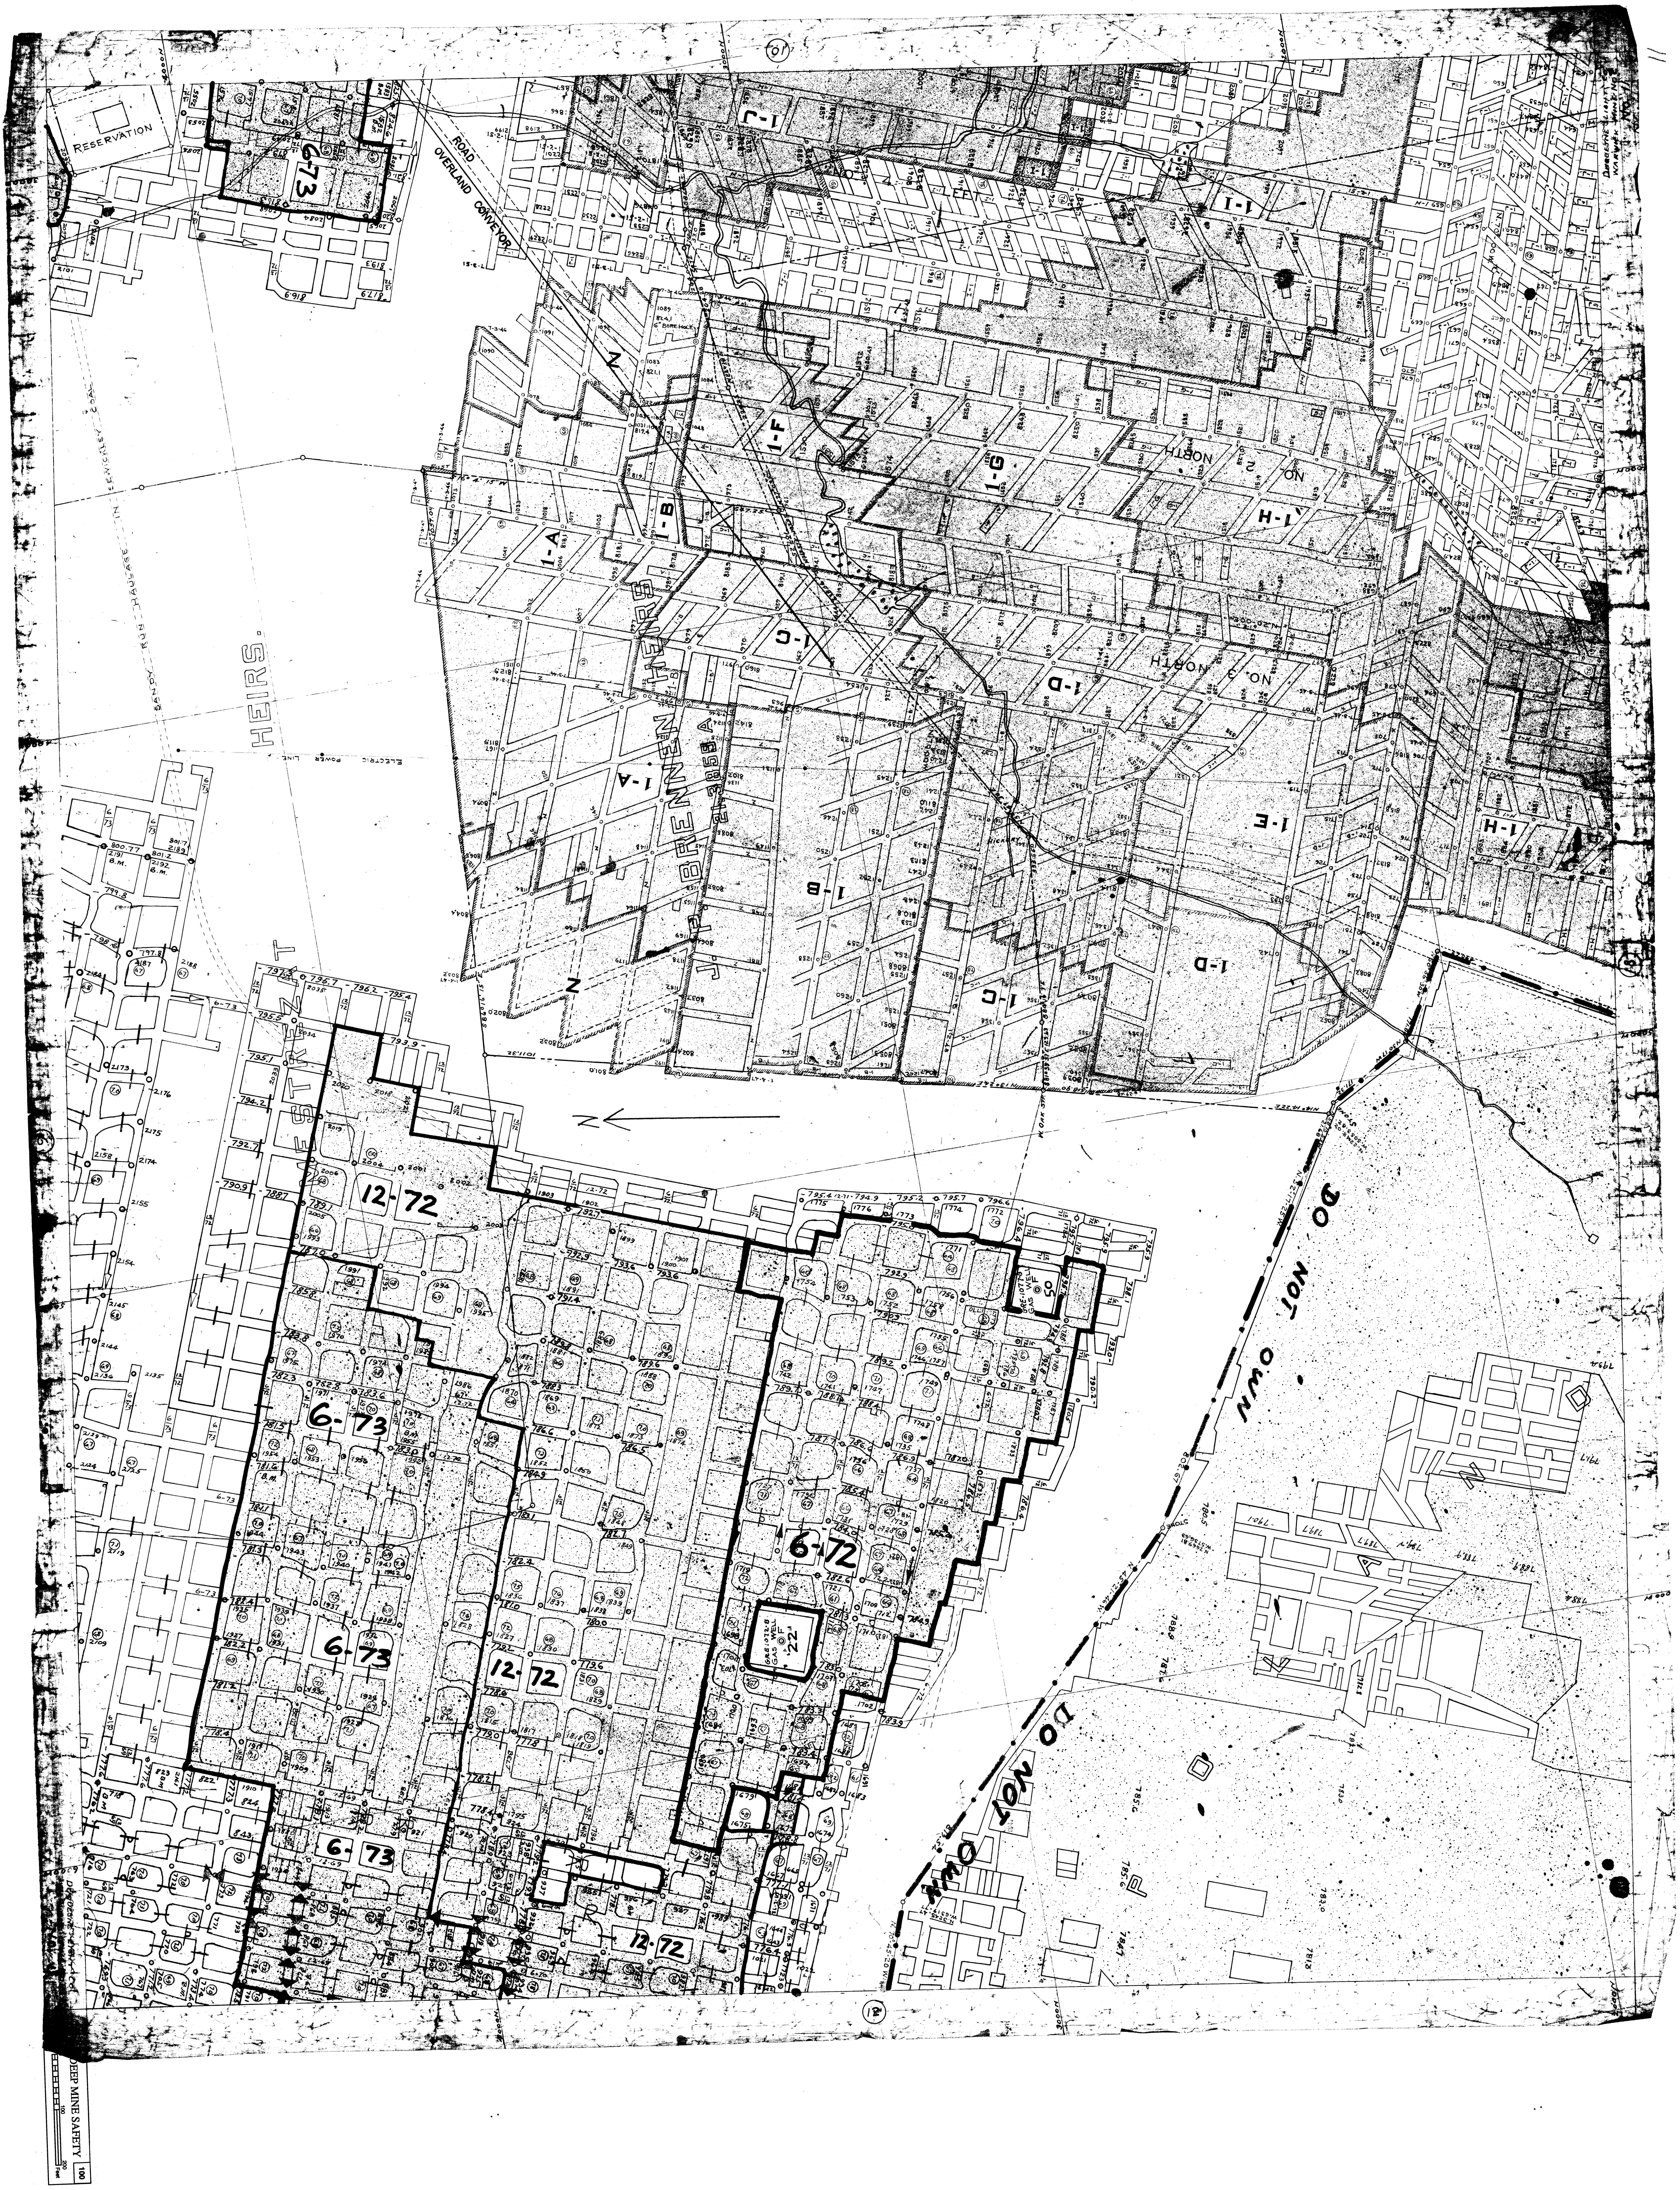
Duquesne Light Co.
Warwick Mine No. 2
No. 11
11
RESERVATION
ROAD
OVERLAND CONVEYOR
SANDY RUN HAULAGE IN SEWICKLEY COAL
HEIRS
ELECTRIC POWER LINE
J. P. BRENNEMAN 2138 SA
HEIRS
NESTREZ T
NO. 2 NORTH
NO. 3 NORTH
NO. 4 LEFT
1-A
1-B
1-C
1-D
1-E
1-F
1-G
1-H
1-I
1-J
6-73
12-72
6-72
GAS WELL F 50
GAS WELL F '22'
N
DO NOT OWN
DO NOT OWN
N. OAK ST.
HICKORY
WOODLAWN
STONE
P
A
N
10
16
18
DEEP MINE SAFETY
100
0
100
200
Feet