DEEP MINE SAFETY 100

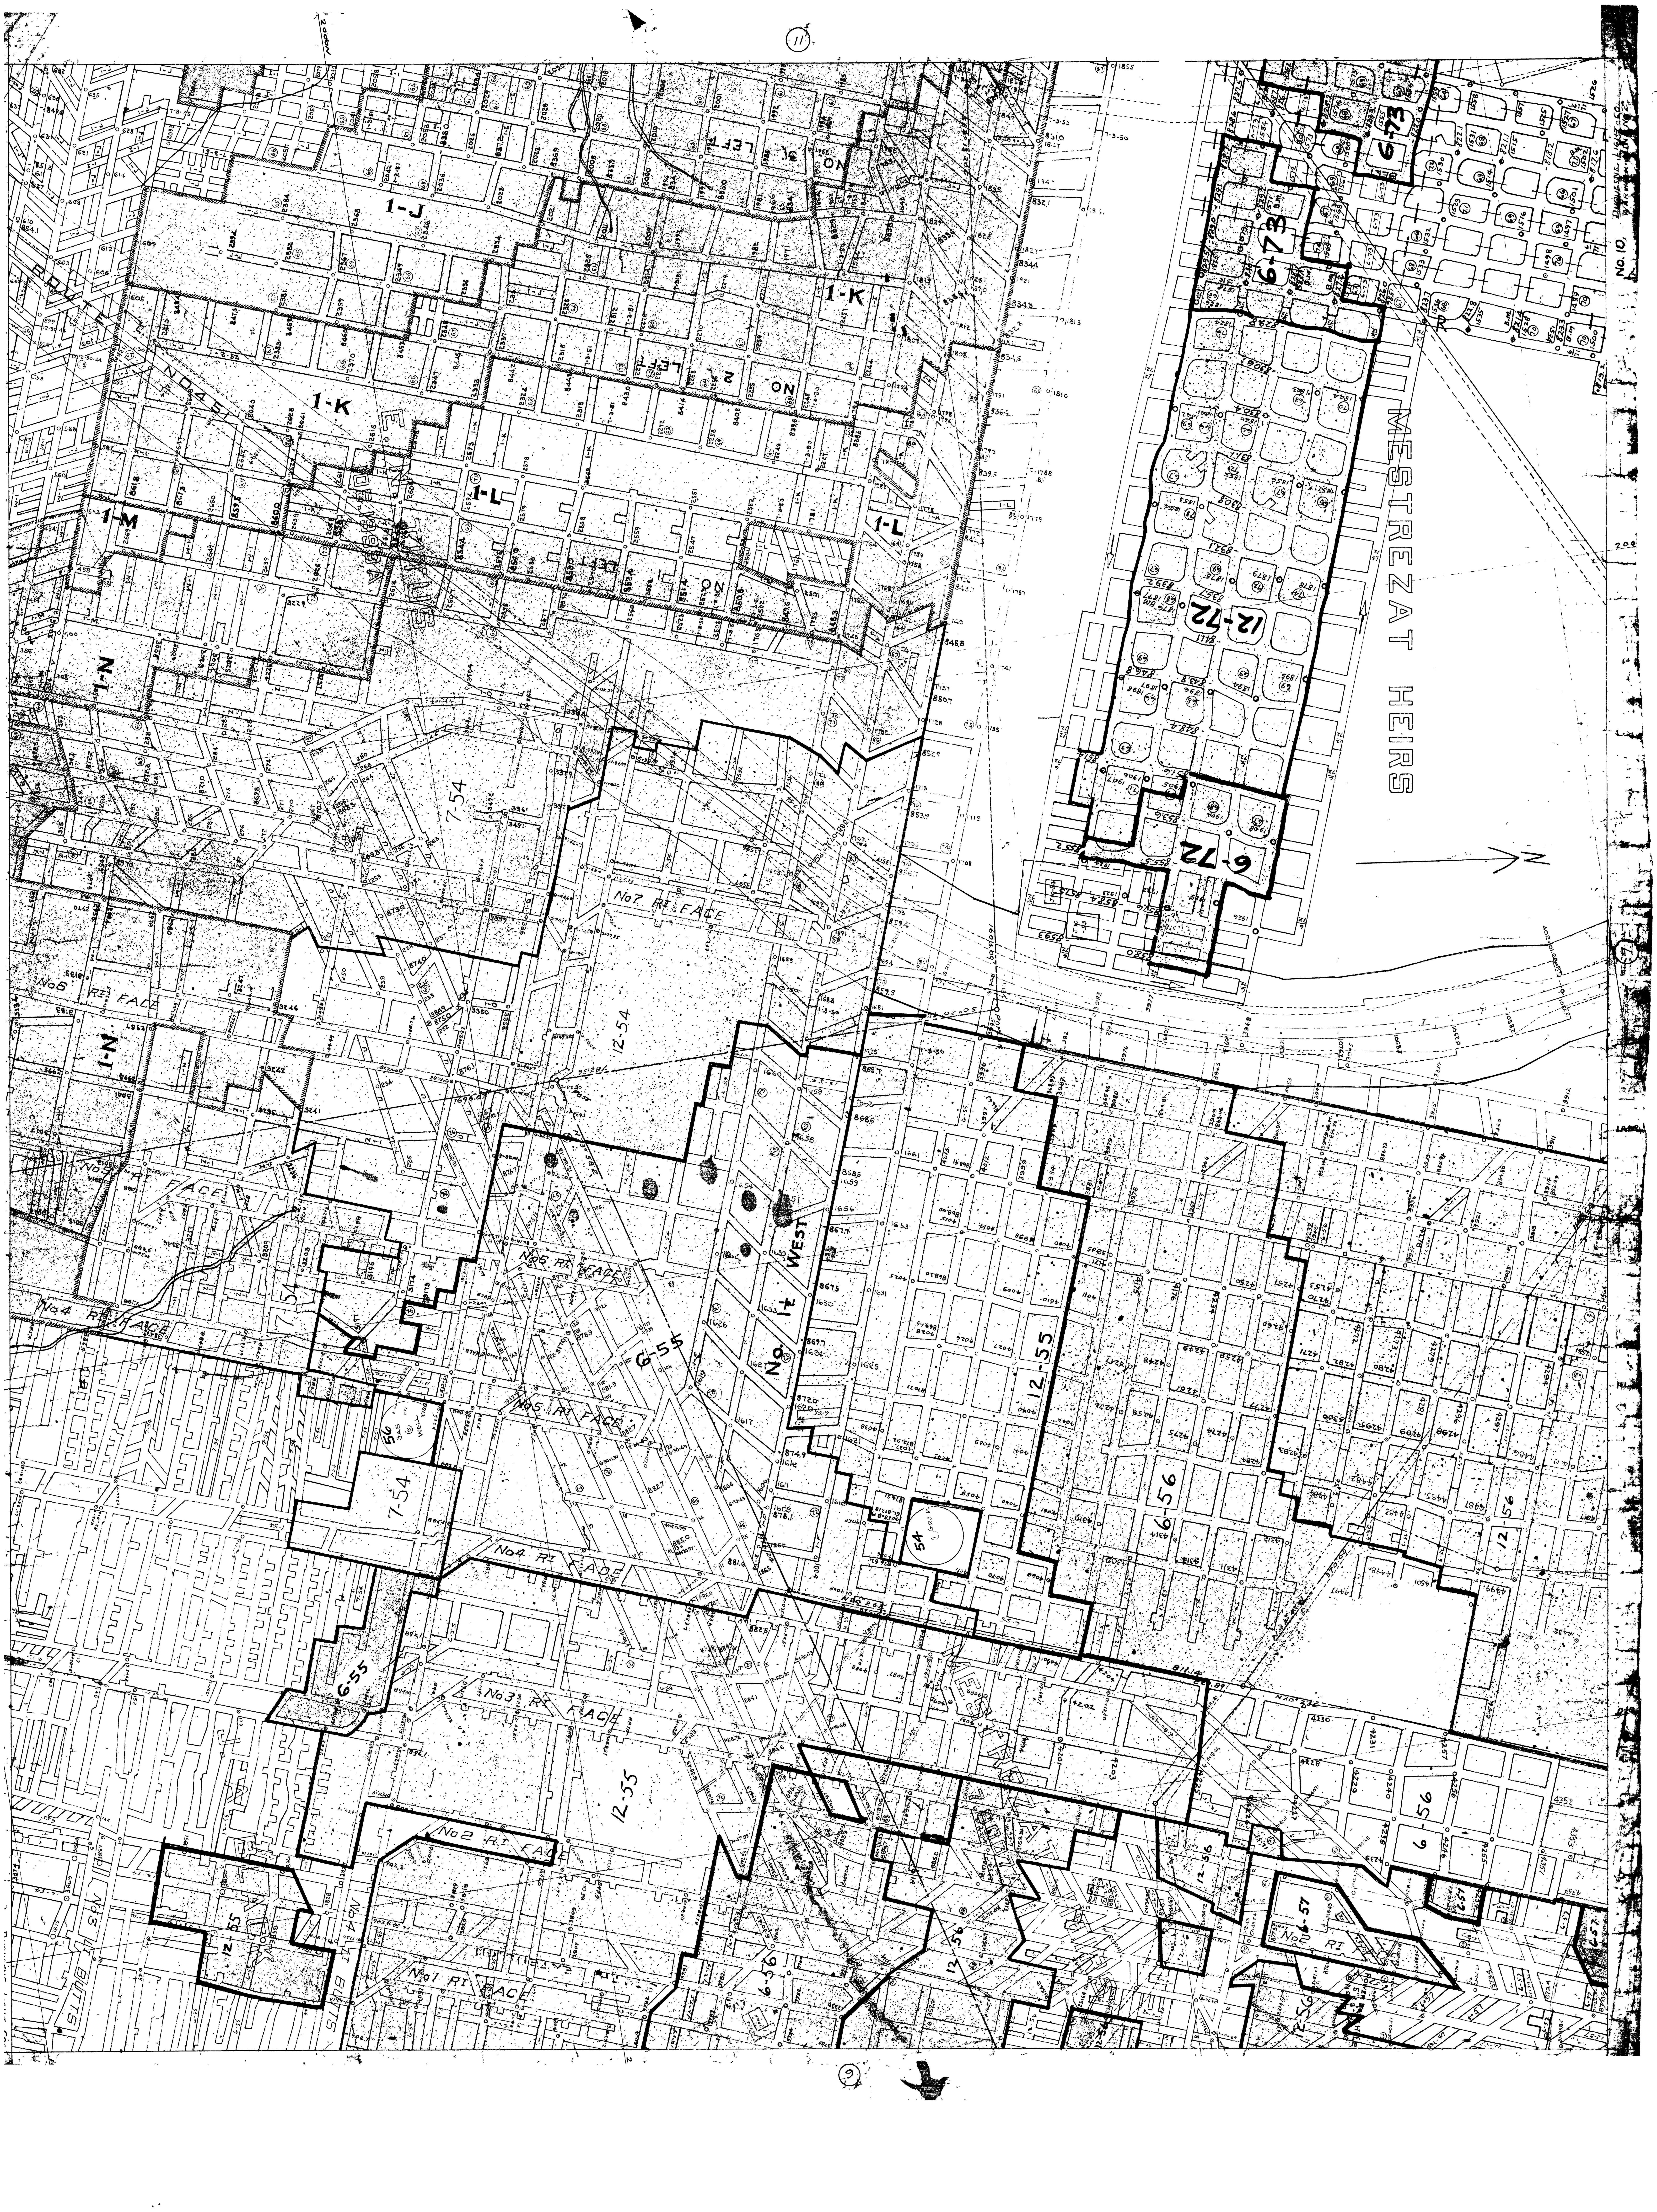
(11)
1-J
1-K
1-L
1-M
1-N
ROUTE NO 451
N LEFT
NO LEFT
MESTREZAT HEIRS
6-73
12-72
6-72
N
NO. 10
DUQUESNE LIGHT CO.
No7 RT FACE
No6 RT FACE
No5 RT FACE
No4 RT FACE
No3 RT FACE
No2 RT FACE
No1 RT FACE
7-54
12-54
6-55
12-55
6-56
12-56
6-57
No 1½ WEST
56 GAS WELL
54 GAS WELL
N5 BUTTS
No4 BUTTS
811.14
N20°23E
(9)