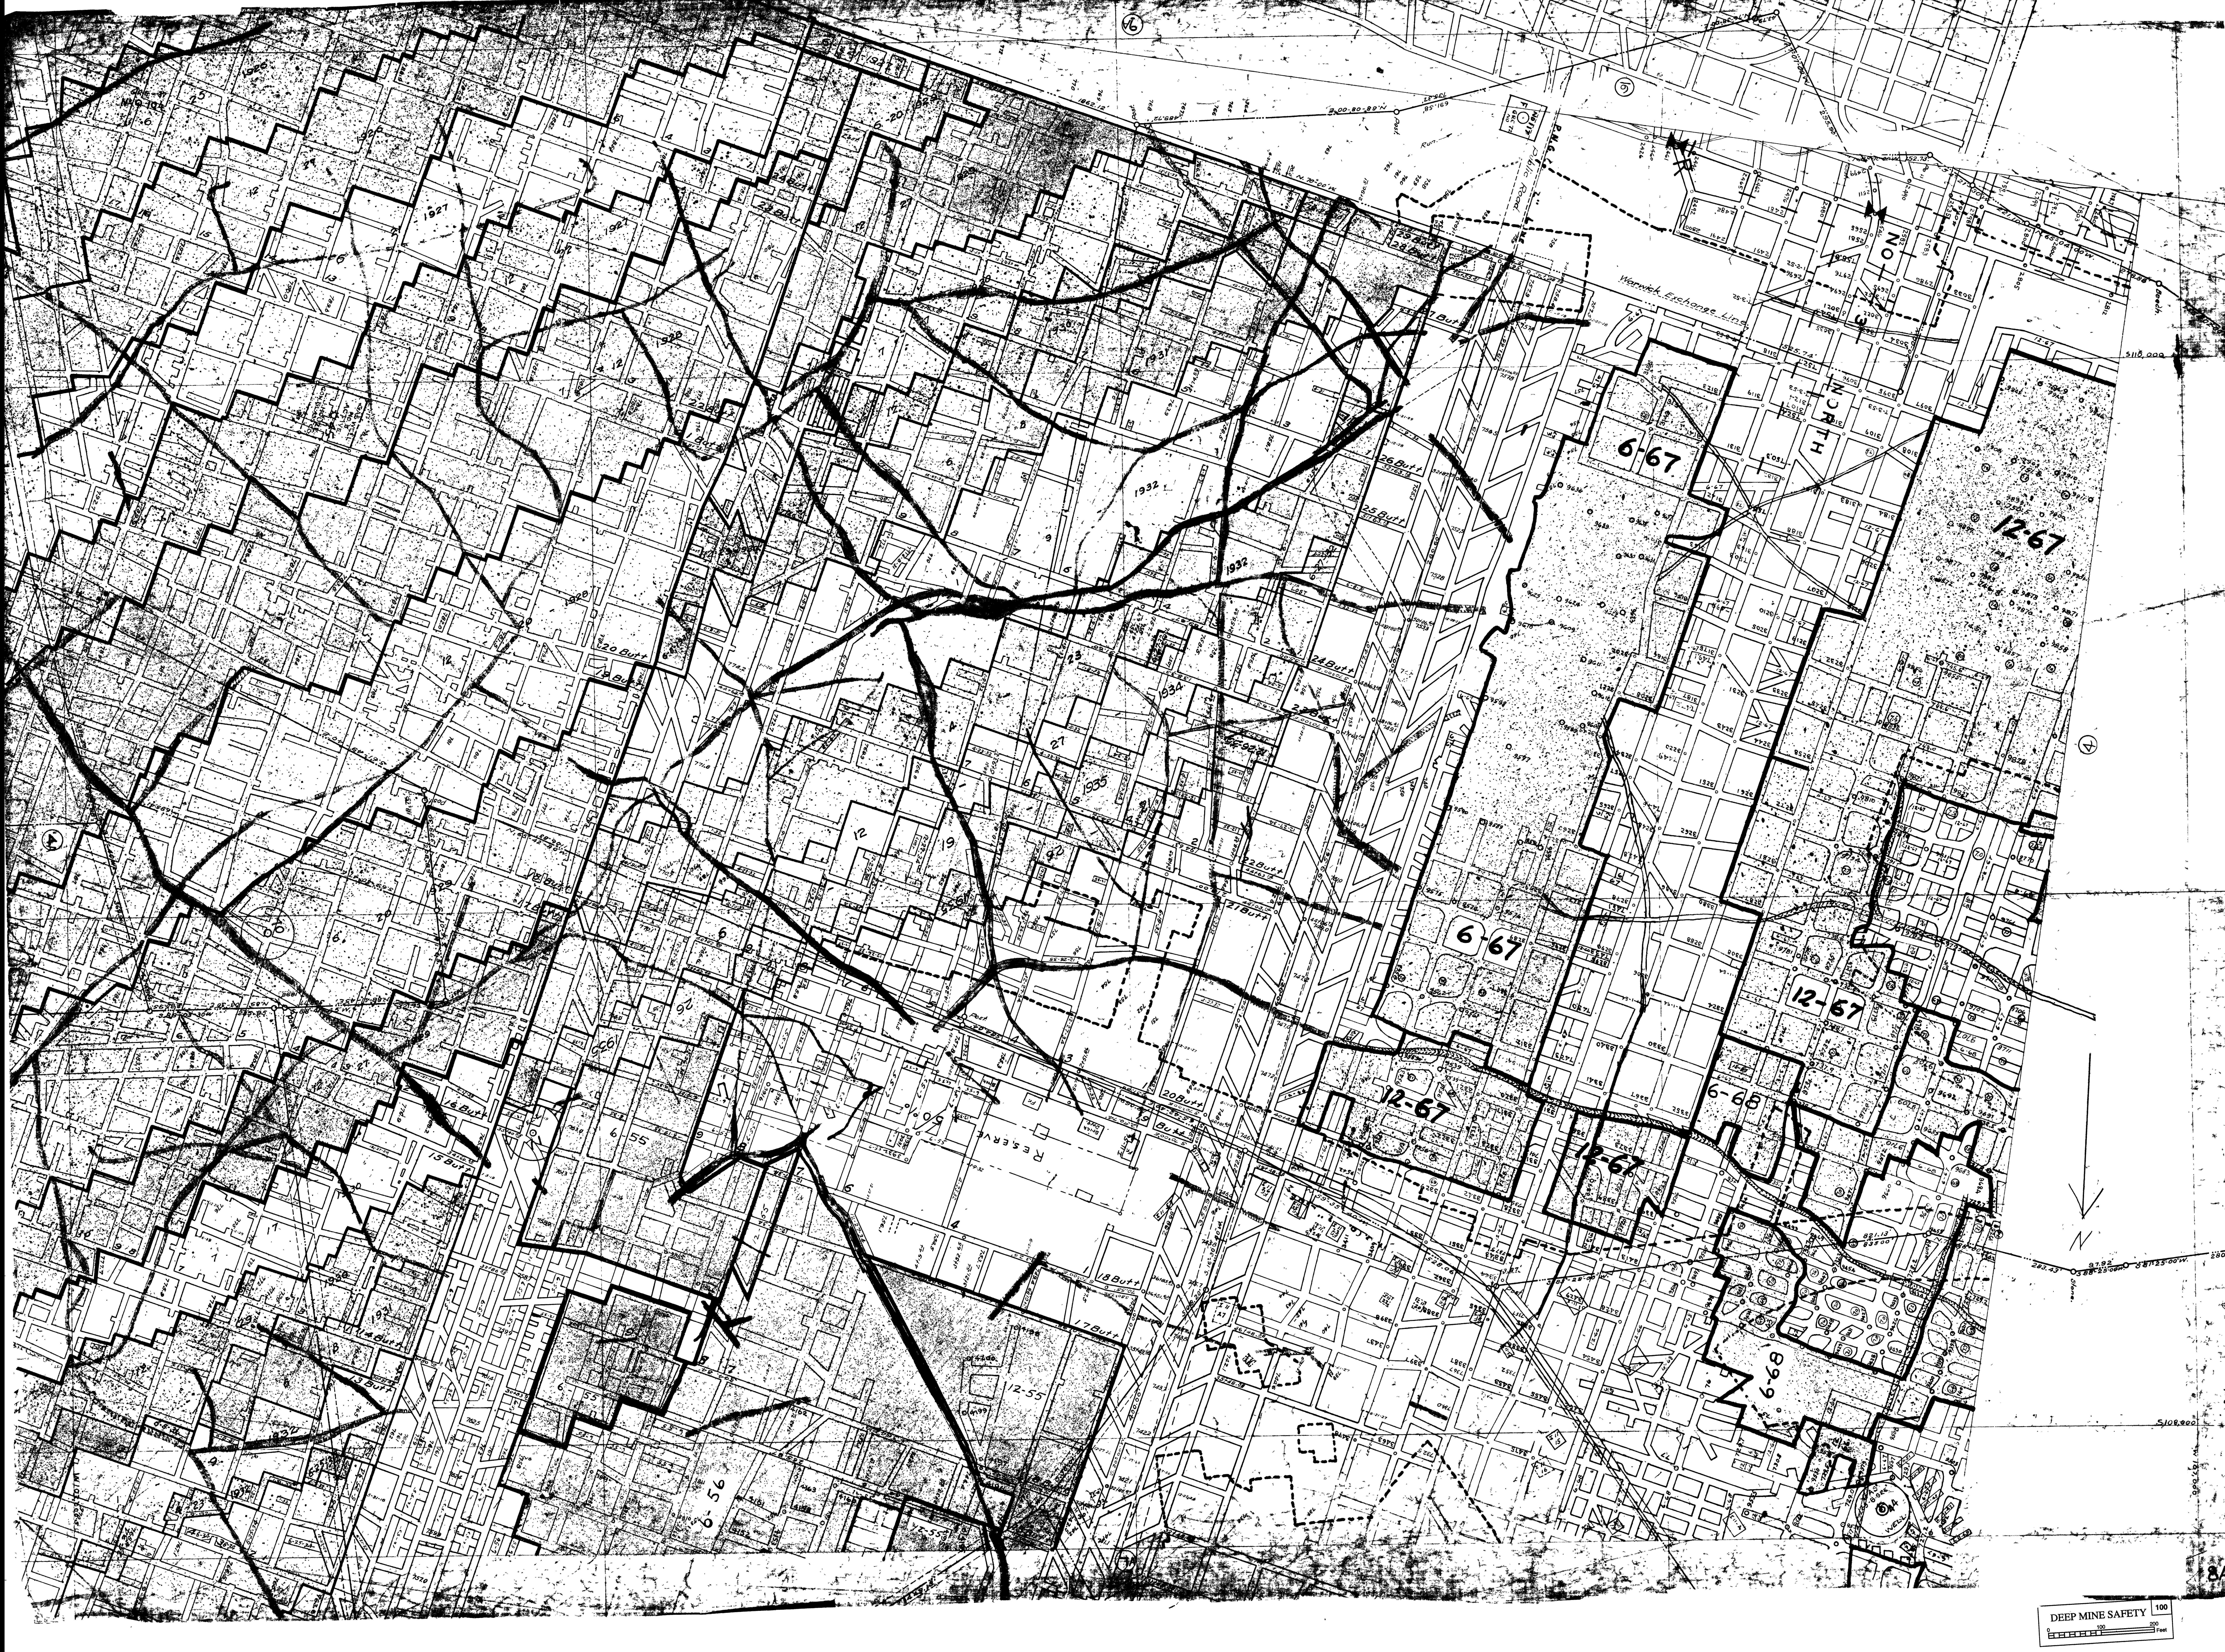
Warwick Exchange Line
Public Road
NORTH
N
Run
Beech
Stone
Post
S110,000
S108,000
N. 70°-00' W.
N. 88°-08'-00" E.
S. 88°-25'-00" W.
GAS WELL
RESERVE
6-67
12-67
6-68
12-55
6-55
6-56
1926
1927
1928
1929
1931
1932
1934
1935
1 Butt
13 Butt
14 Butt
15 Butt
16 Butt
17 Butt
18 Butt
19 Butt
20 Butt
21 Butt
22 Butt
23 Butt
24 Butt
25 Butt
26 Butt
28 Butt
29 Butt
8A

DEEP MINE SAFETY 100

0 100 200 Feet