


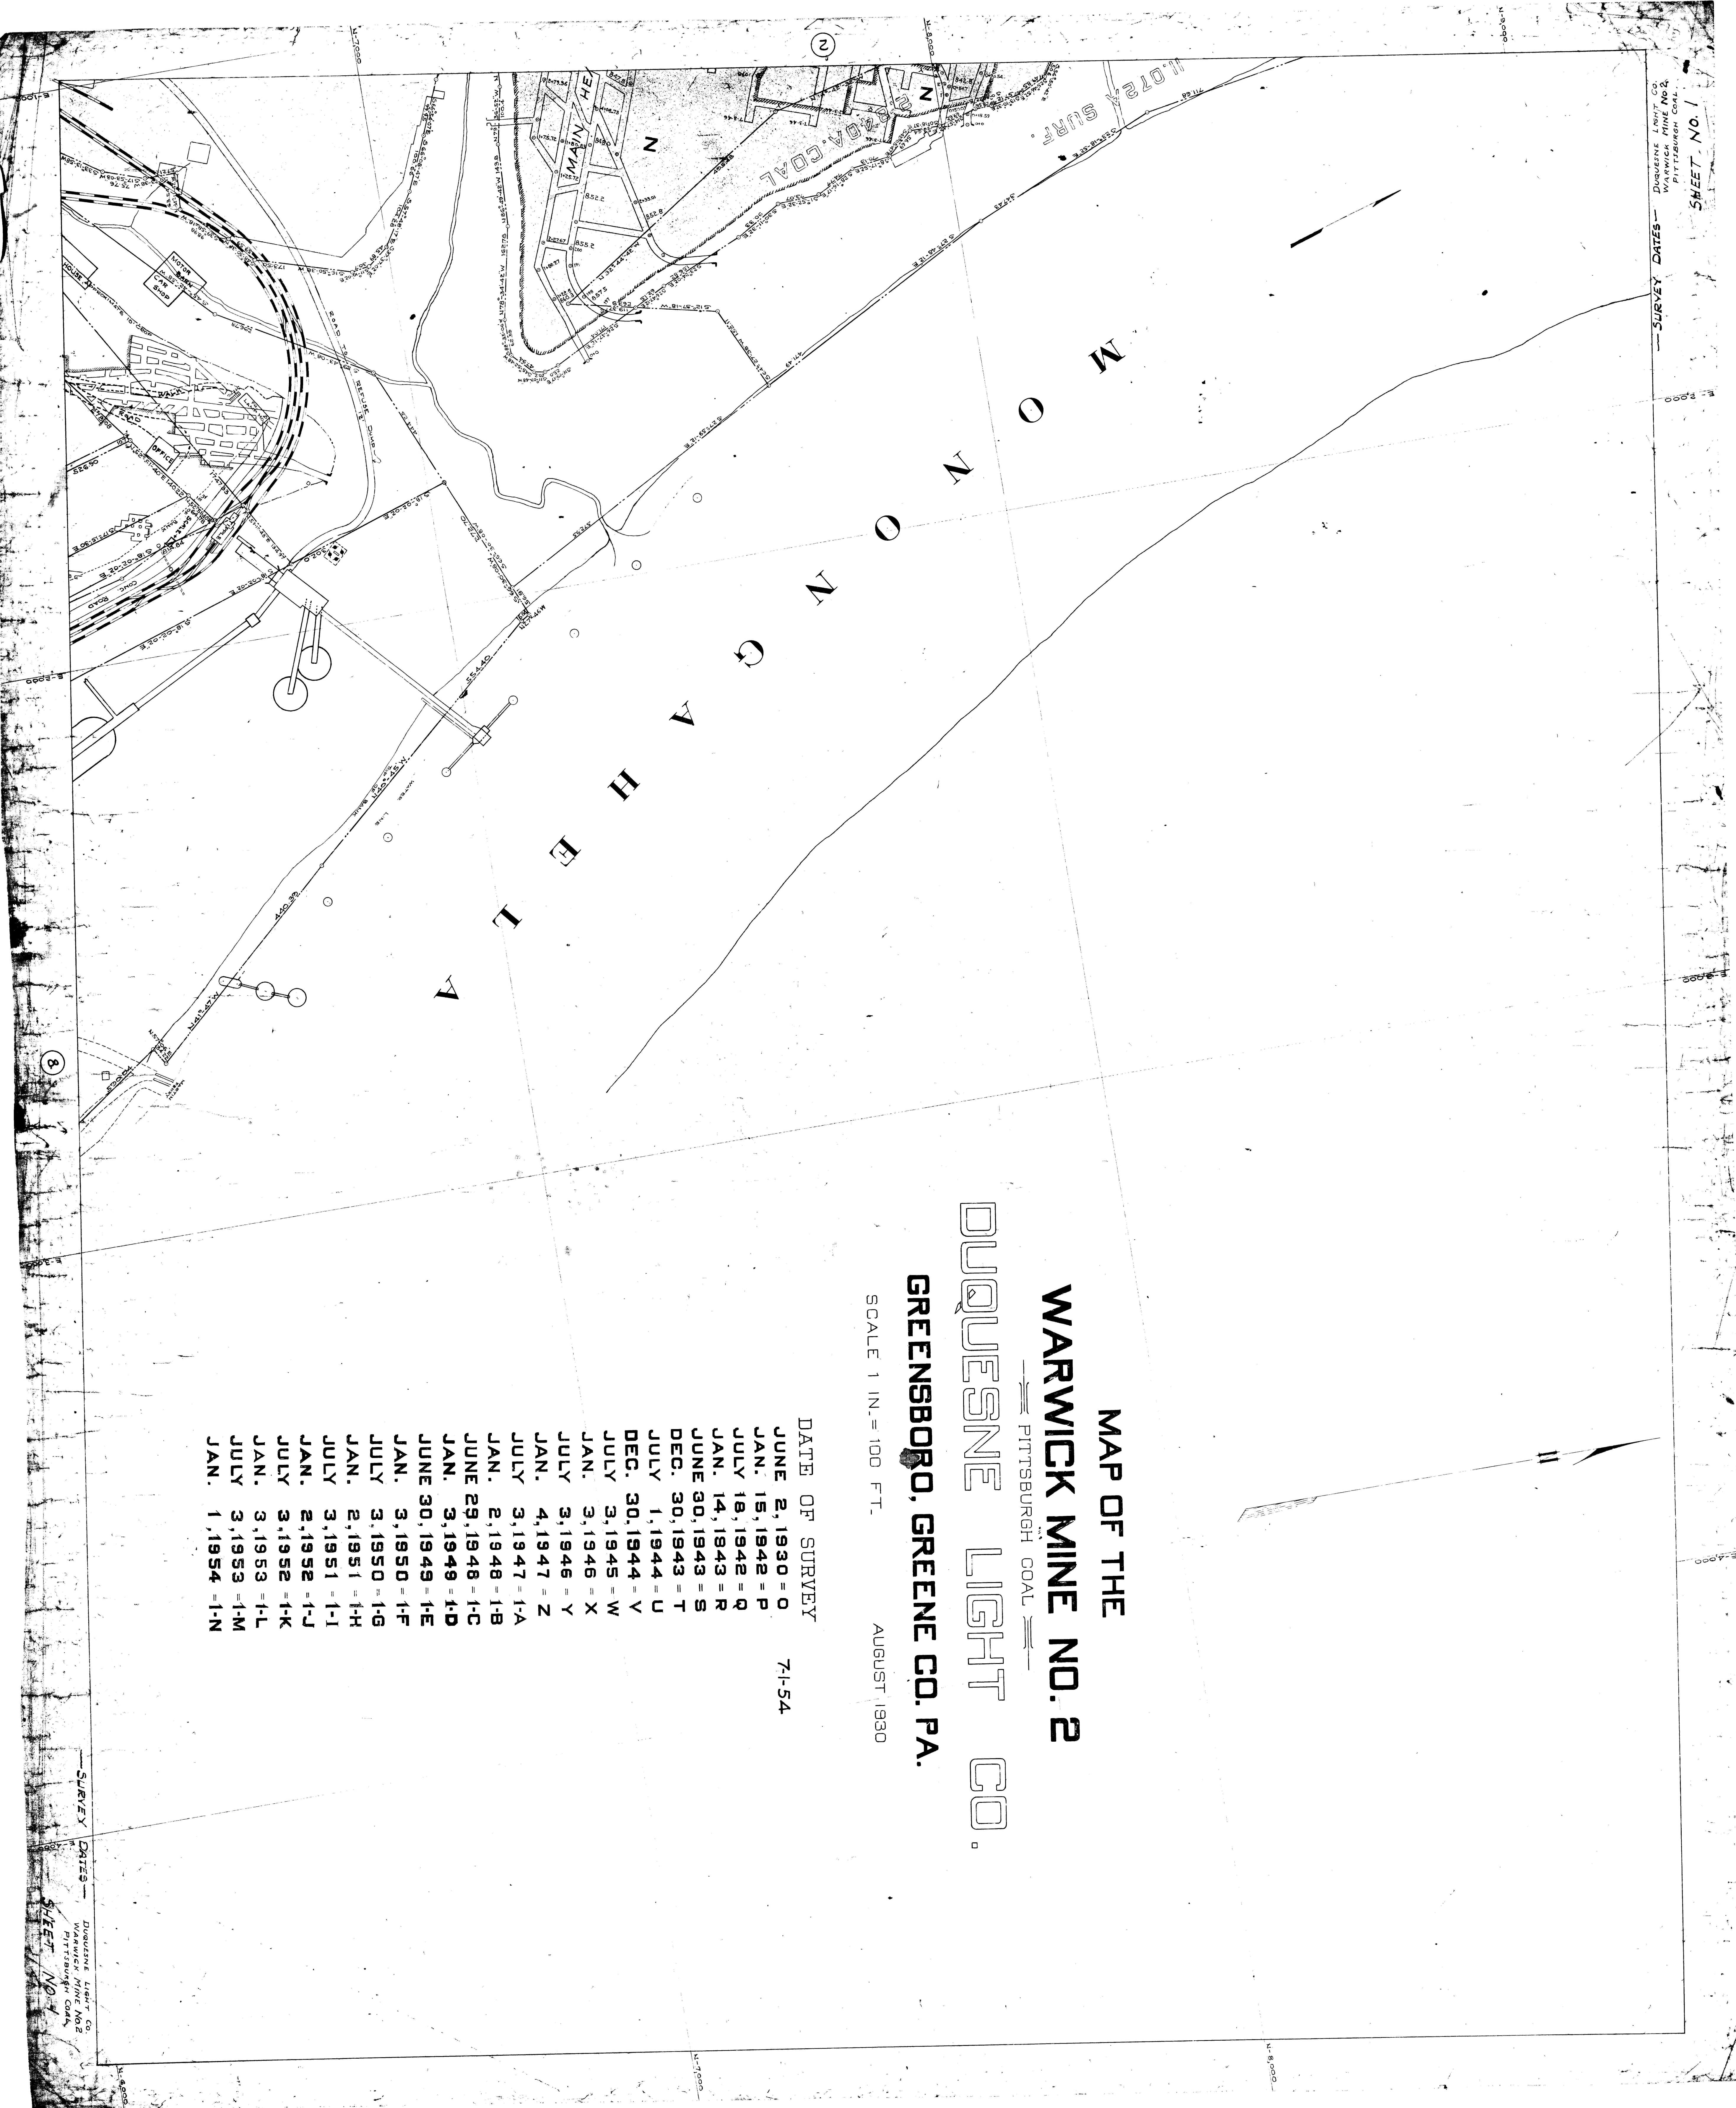

MAP OF THE
WARWICK MINE NO. 2
— PITTSBURGH COAL —
DUQUESNE LIGHT CO.
GREENSBORO, GREENE CO. PA.

SCALE 1 IN. = 100 FT. AUGUST, 1930

DATE OF SURVEY	
JUNE 2, 1930 = O	7-1-54
JAN. 15, 1942 = P	
JULY 18, 1942 = Q	
JAN. 14, 1943 = R	
JUNE 30, 1943 = S	
DEC. 30, 1943 = T	
JULY 1, 1944 = U	
DEC. 30, 1944 = V	
JULY 3, 1945 = W	
JAN. 3, 1946 = X	
JULY 3, 1946 = Y	
JAN. 4, 1947 = Z	
JULY 3, 1947 = 1-A	
JAN. 2, 1948 = 1-B	
JUNE 29, 1948 = 1-C	
JAN. 3, 1949 = 1-D	
JUNE 30, 1949 = 1-E	
JAN. 3, 1950 = 1-F	
JULY 3, 1950 = 1-G	
JAN. 2, 1951 = 1-H	
JULY 3, 1951 = 1-I	
JAN. 2, 1952 = 1-J	
JULY 3, 1952 = 1-K	
JAN. 3, 1953 = 1-L	
JULY 3, 1953 = 1-M	
JAN. 1, 1954 = 1-N	