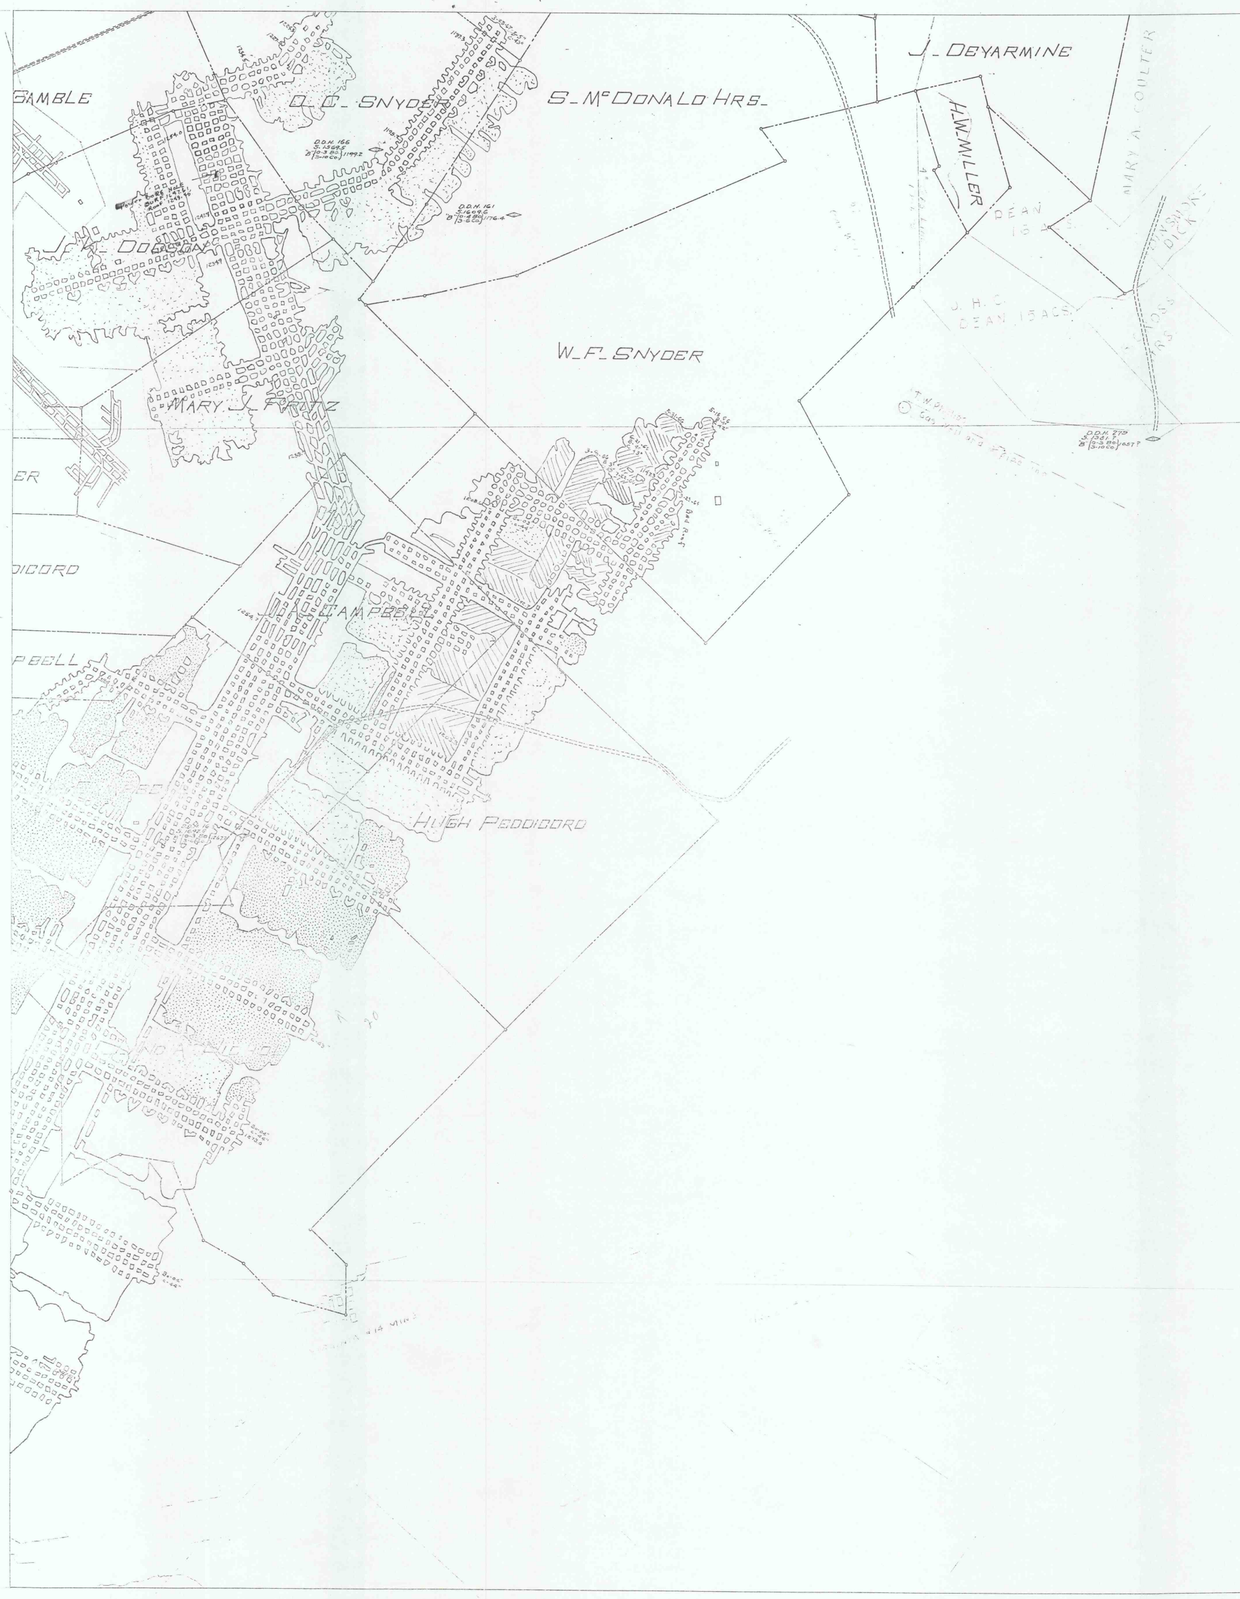
GAMBLE
O. C. SNYDER
S. McDONALD HRS.
J. DEYARMINE
H.W. MILLER
MARY A. COULTER
W. F. SNYDER
ER
DIDORD
PBELL
HUGH PEDDICORD