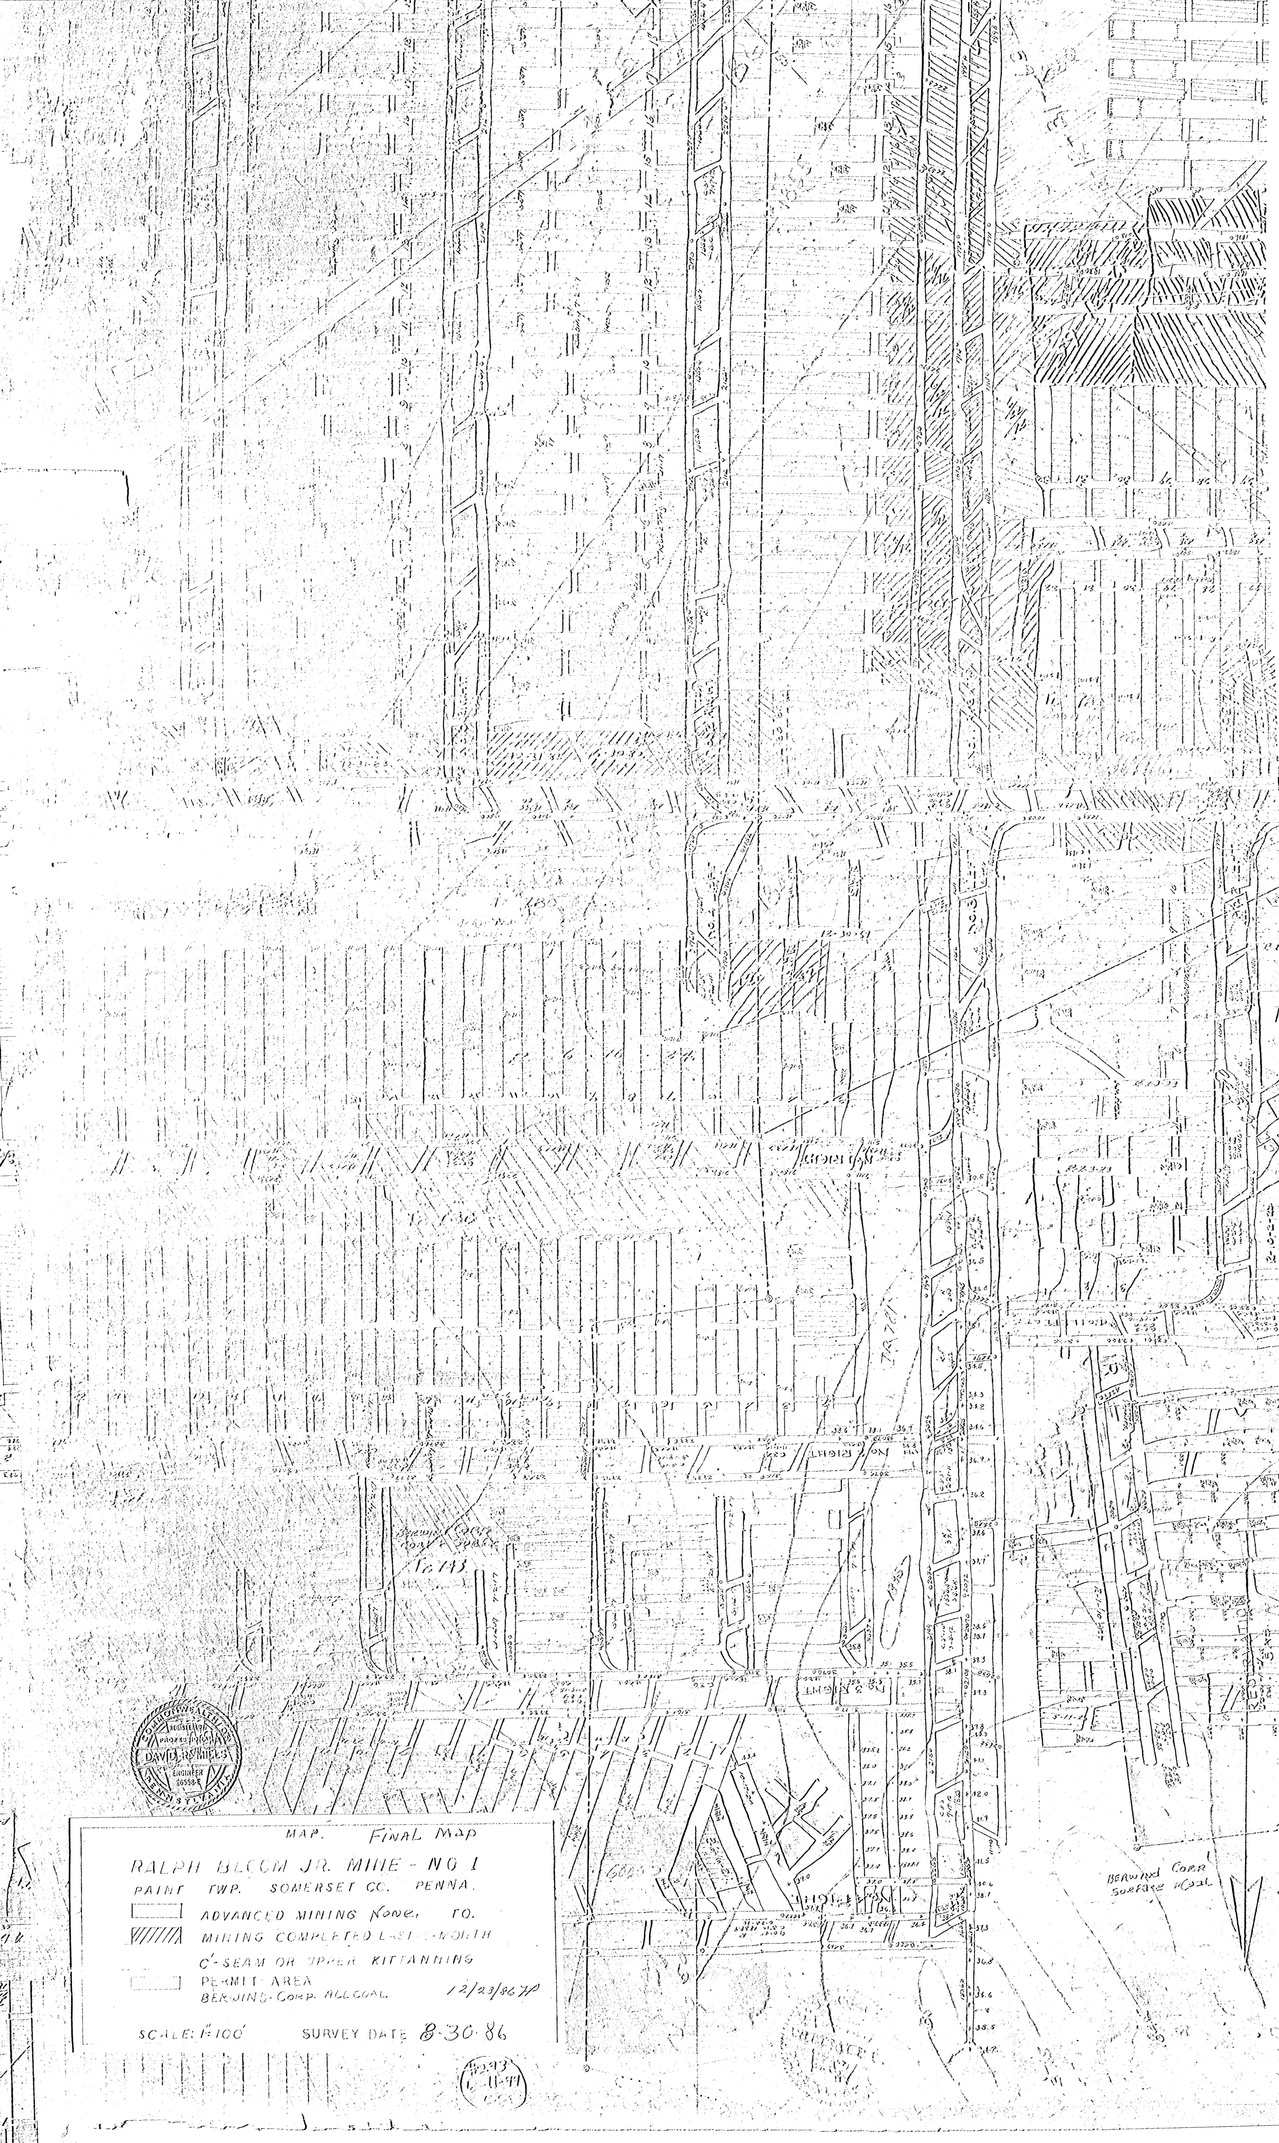
MAP. FINAL MAP
RALPH BLOOM JR. MINE - NO 1
PAINT TWP. SOMERSET CO. PENNA.
ADVANCED MINING None TO.
MINING COMPLETED LAST - NORTH
C'-SEAM OR UPPER KITTANNING
PERMIT AREA
BERWIND-Corp. NILCOAL
12/23/86 HP
SCALE: 1"=100'
SURVEY DATE 8-30-86
DAVID R. SHILLS
ENGINEER
20558-A
Berwind Corp
Surface Coal
Berwind Corp
Surface Coal
Tr. 143
Tr. 144
