


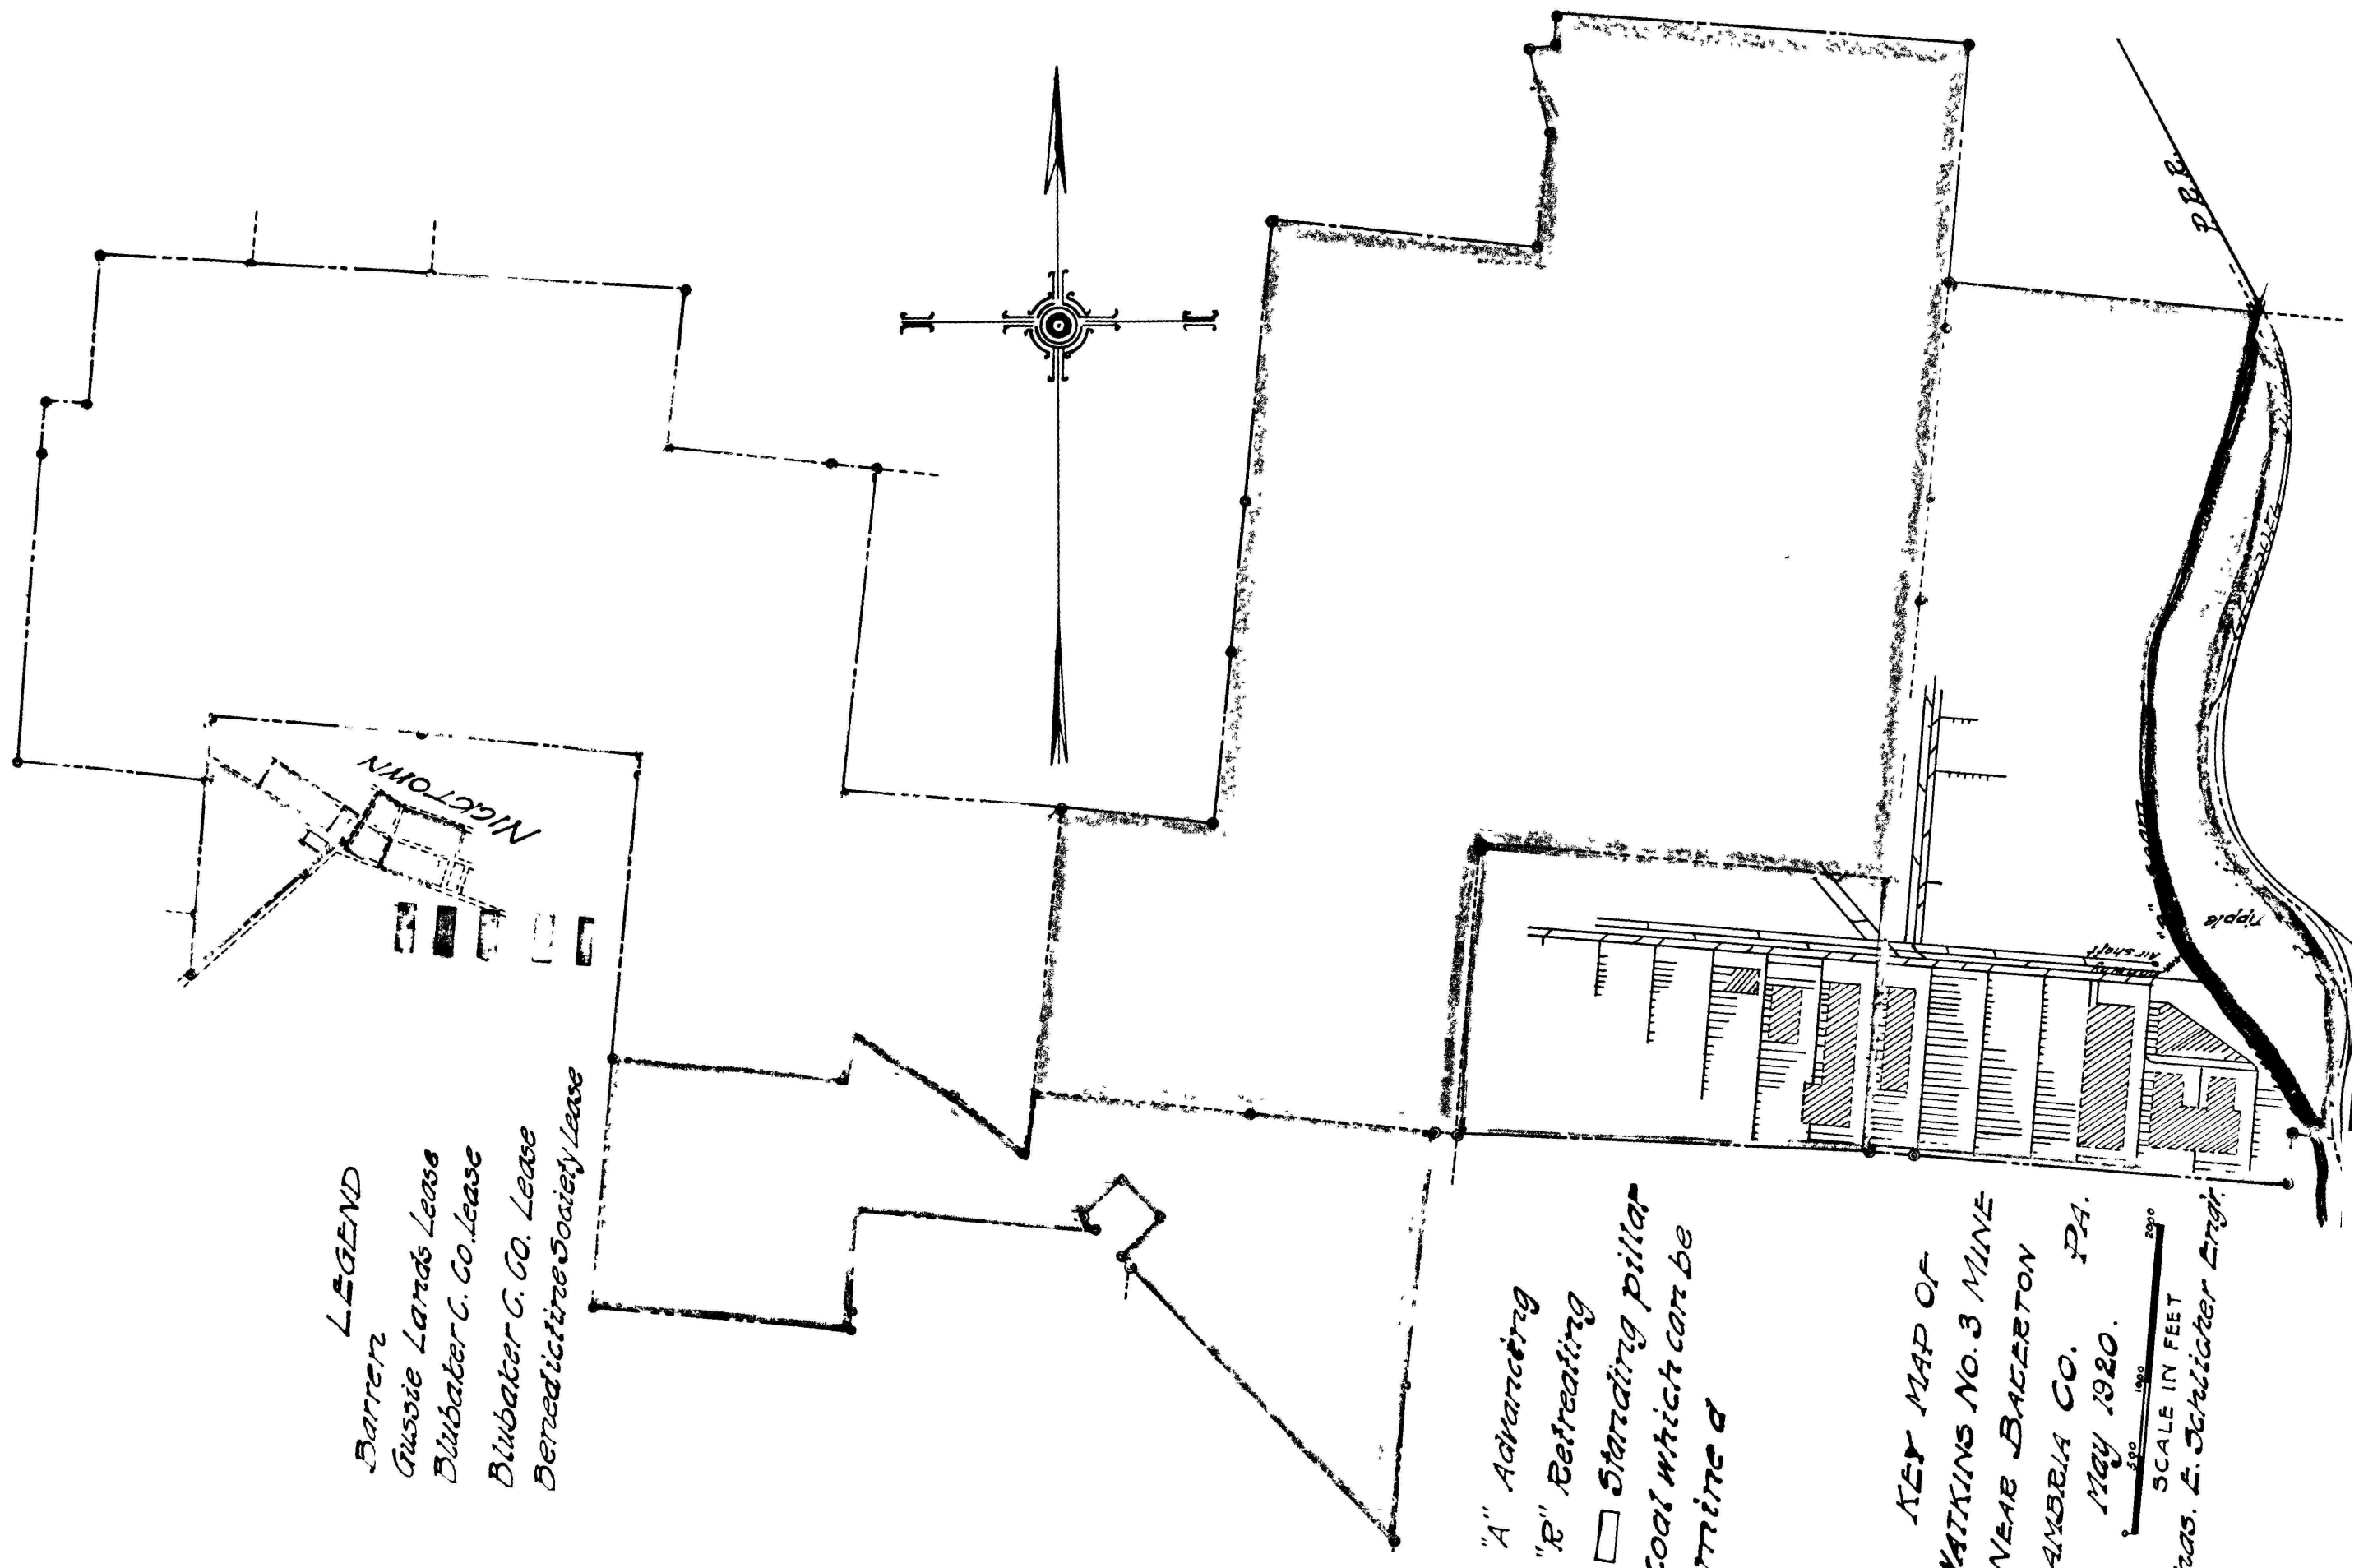

**LEGEND**

- Barren
- Guswie Lands Lease
- Blubater C. Co. Lease
- Blubater C. Co. Lease
- Benedictine Society Lease

"A" Advancing  
"B" Retreating  
□ Standing pillar  
coal which can be  
mine d

KEY MAP OF  
WATKINS NO. 3 MINE  
NEAR BAGERSTON  
CAMBRIA CO. PA.  
May 1920.

SCALE IN FEET  
0 100 200  
Chas. E. Schlicher Engr.