


#5 dtd

303072

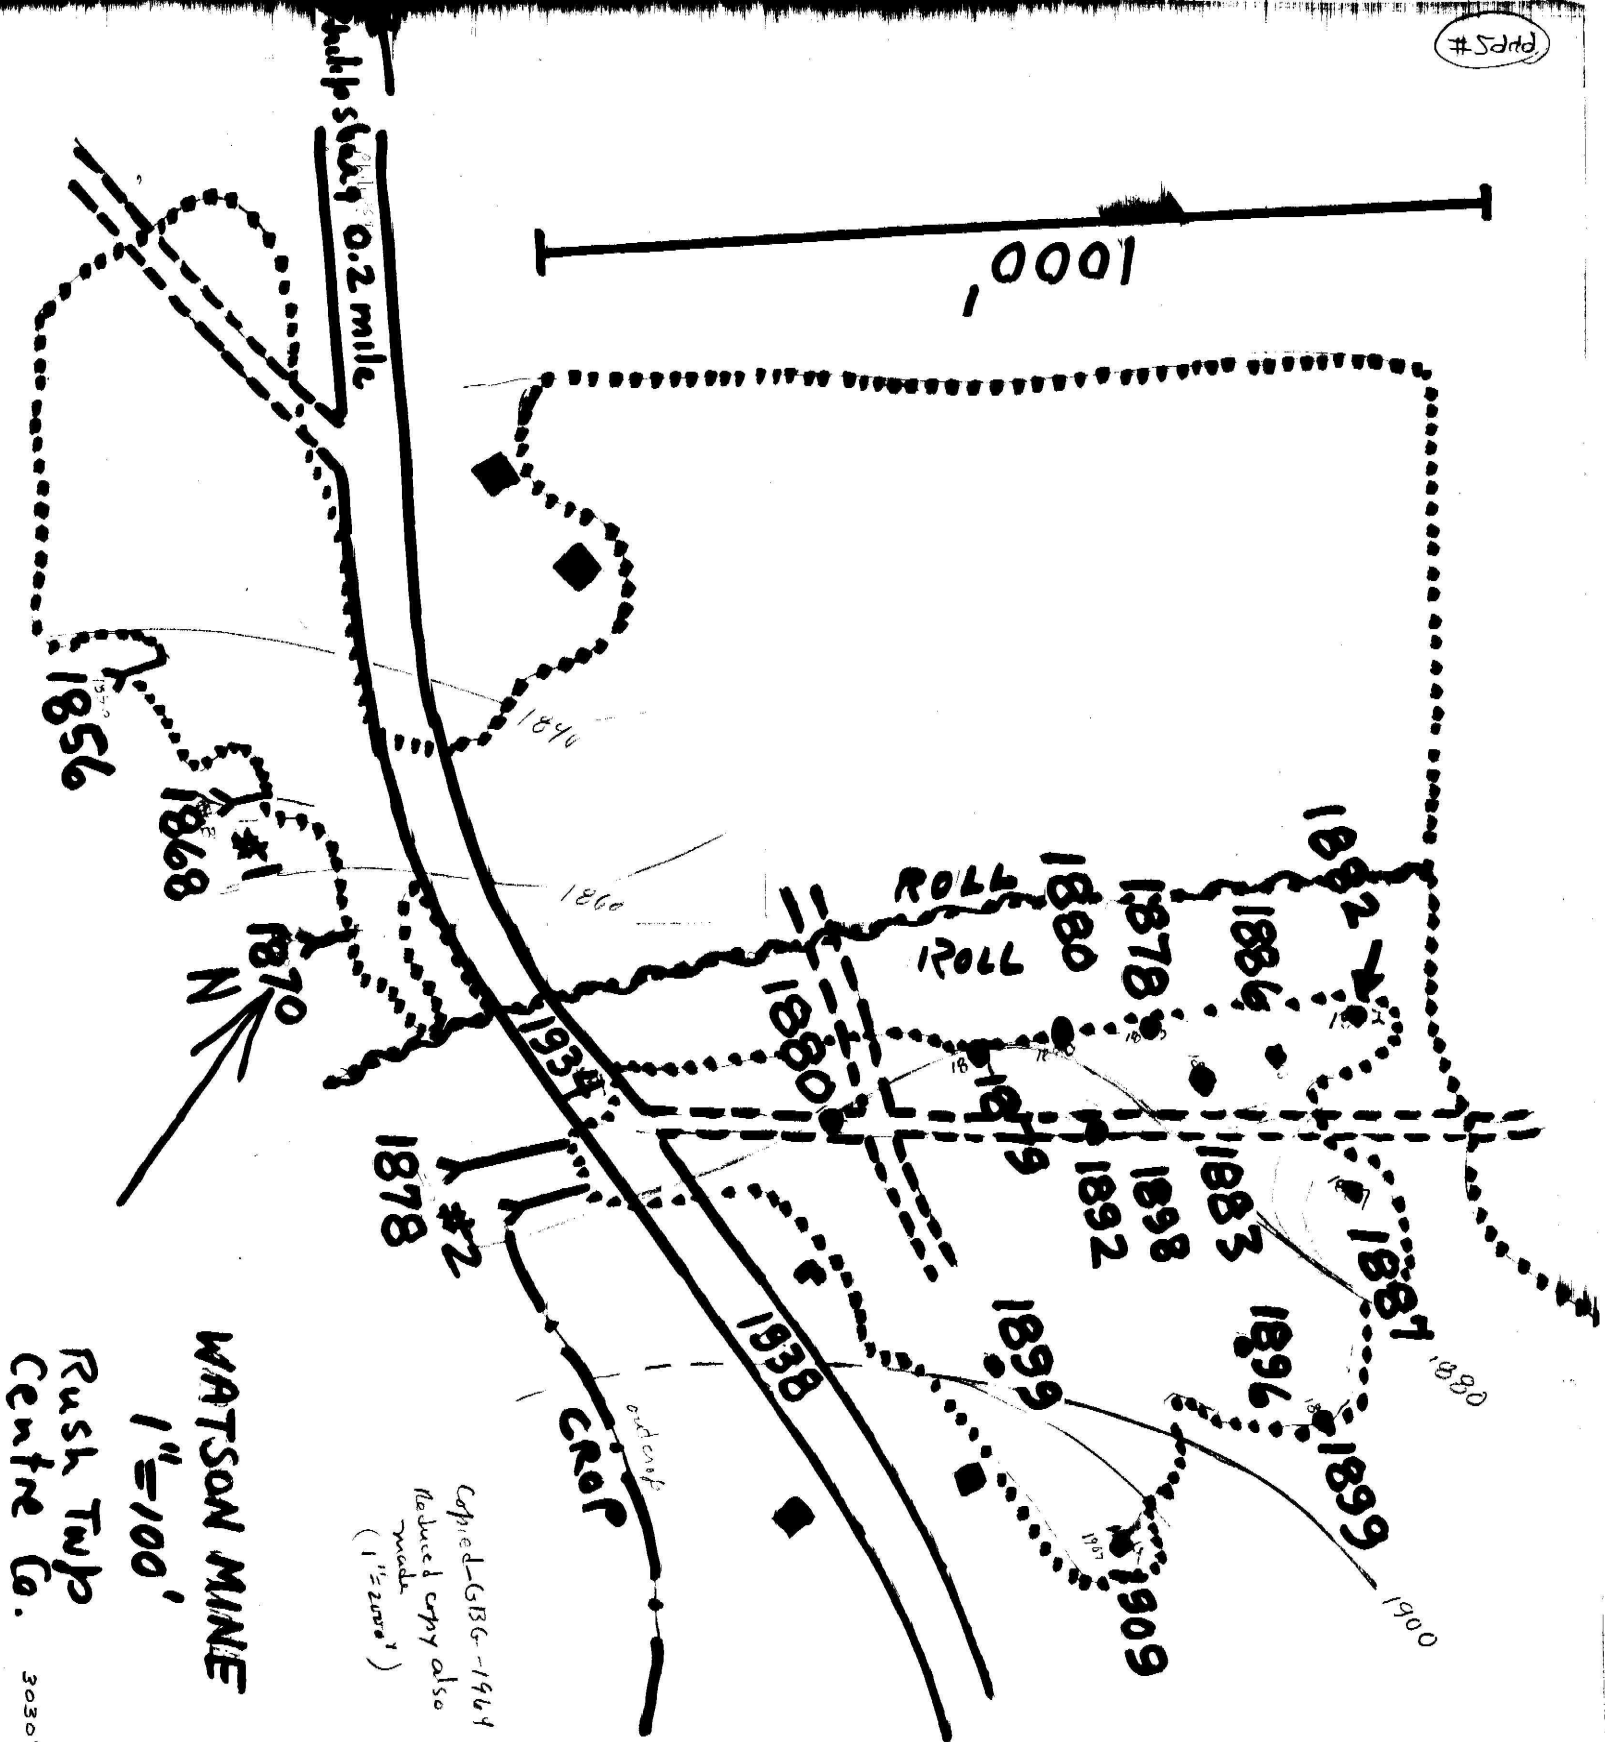

WATSON MINE
1"=100'
Rush Twp
Centre Co.

Copied-GBG-1969
Reduced copy also
made
(1"=2000')

303075