


Du Bois Collier.

James E. Clark et al.

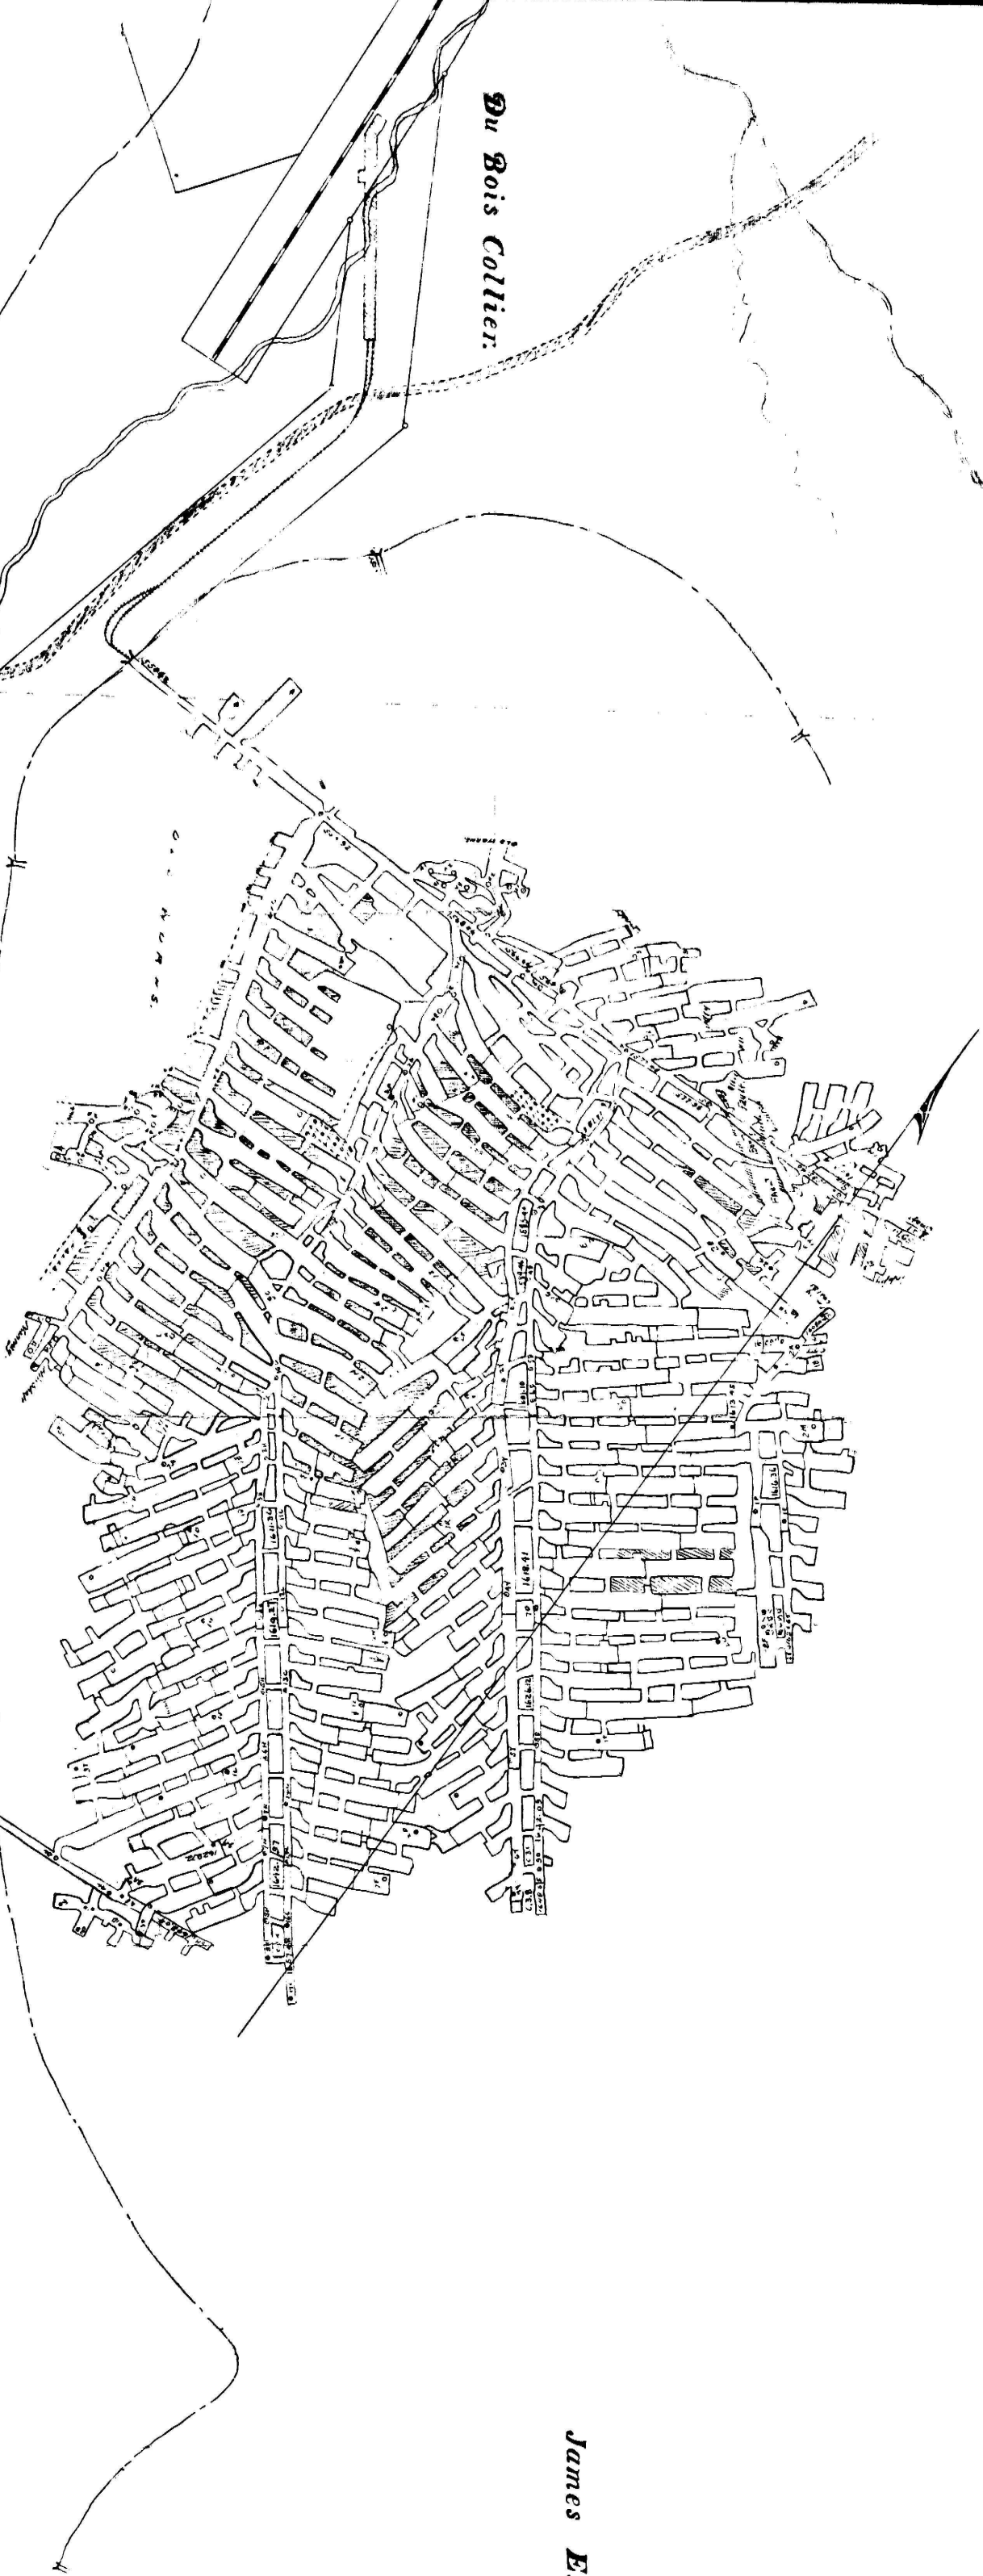

MAP OF  
**BLOOMINGTON NO 7**

OPERATED BY THE  
**Red Bank Coal Co.**  
BUTLER COUNTY, PENNA.  
Scale: 1 inch = 100 feet.  
Revised To 1910

P. C. & L. CO.

