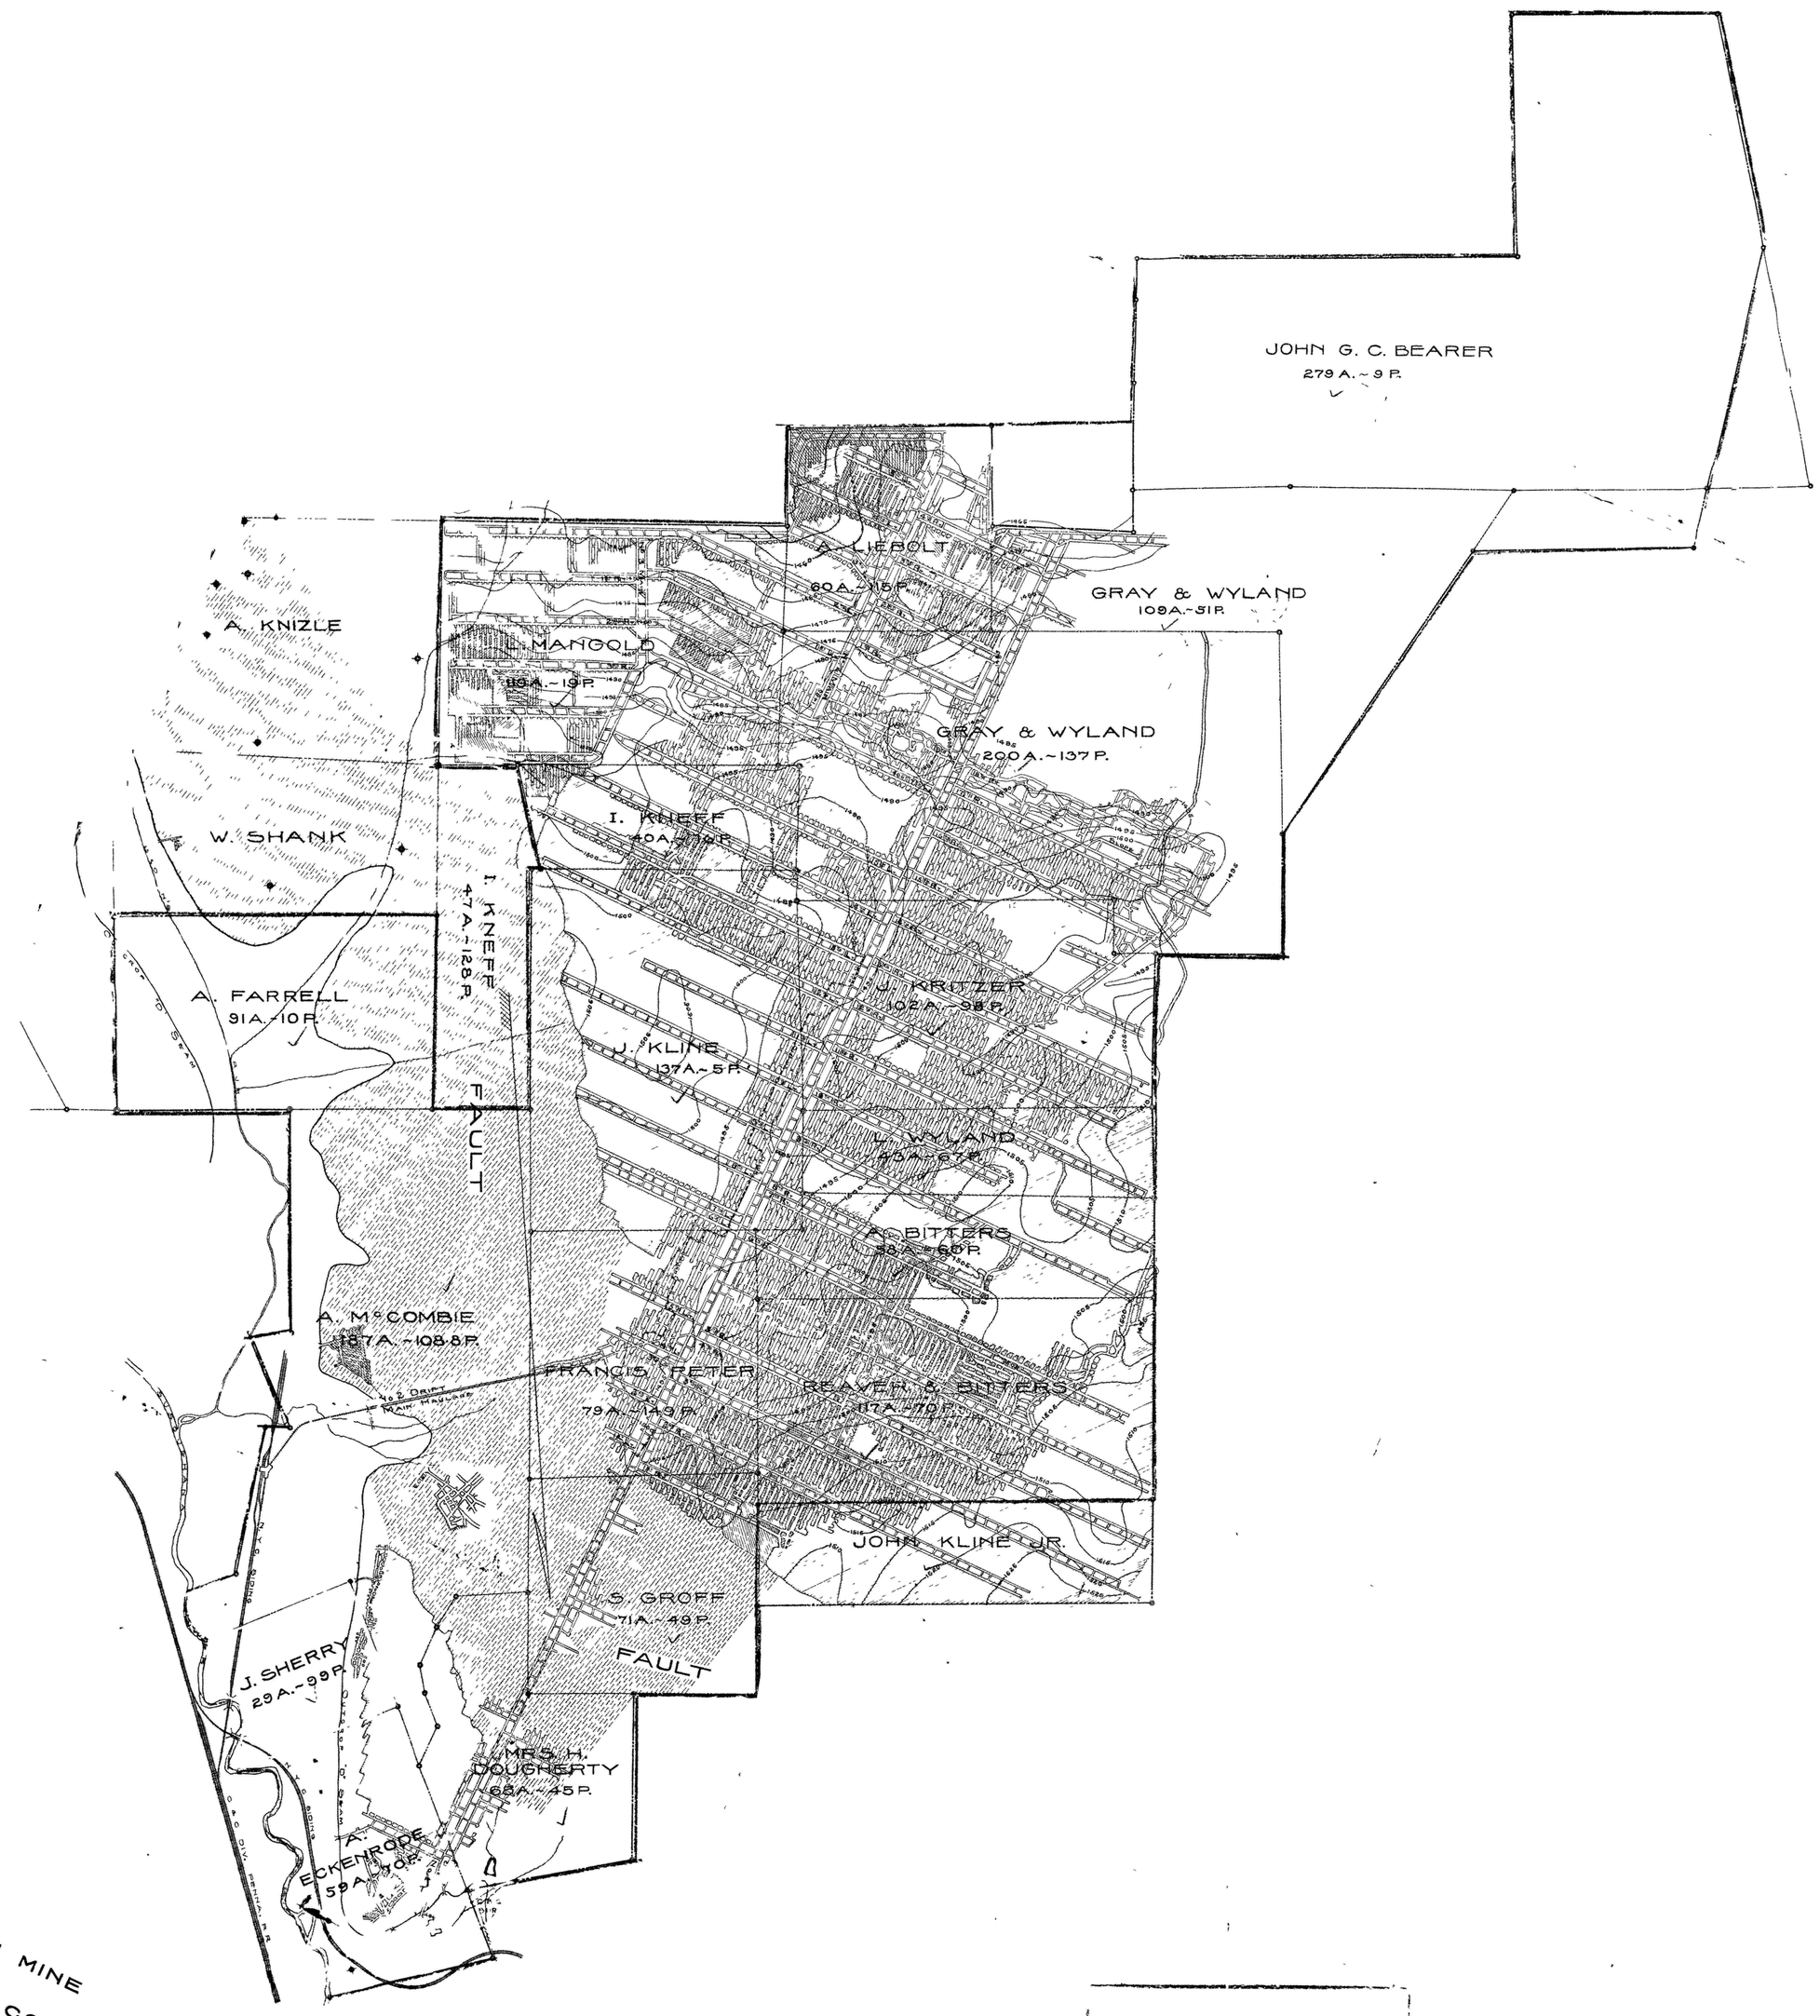

WEST BRANCH MINE
OF THE
CLEARFIELD BITUMINOUS COAL CORP'N
BARR TWP., CAMBRIA CO., PENNA.
SCALE 1" = 400'
MAY, 1916

ENGINEERING DEPARTMENT
CLEARFIELD BITUMINOUS COAL CORP'N
REVISED
REVISED
REVISED
DRAWN BY
TRACED BY
COMPUTED BY
APPRO'D