


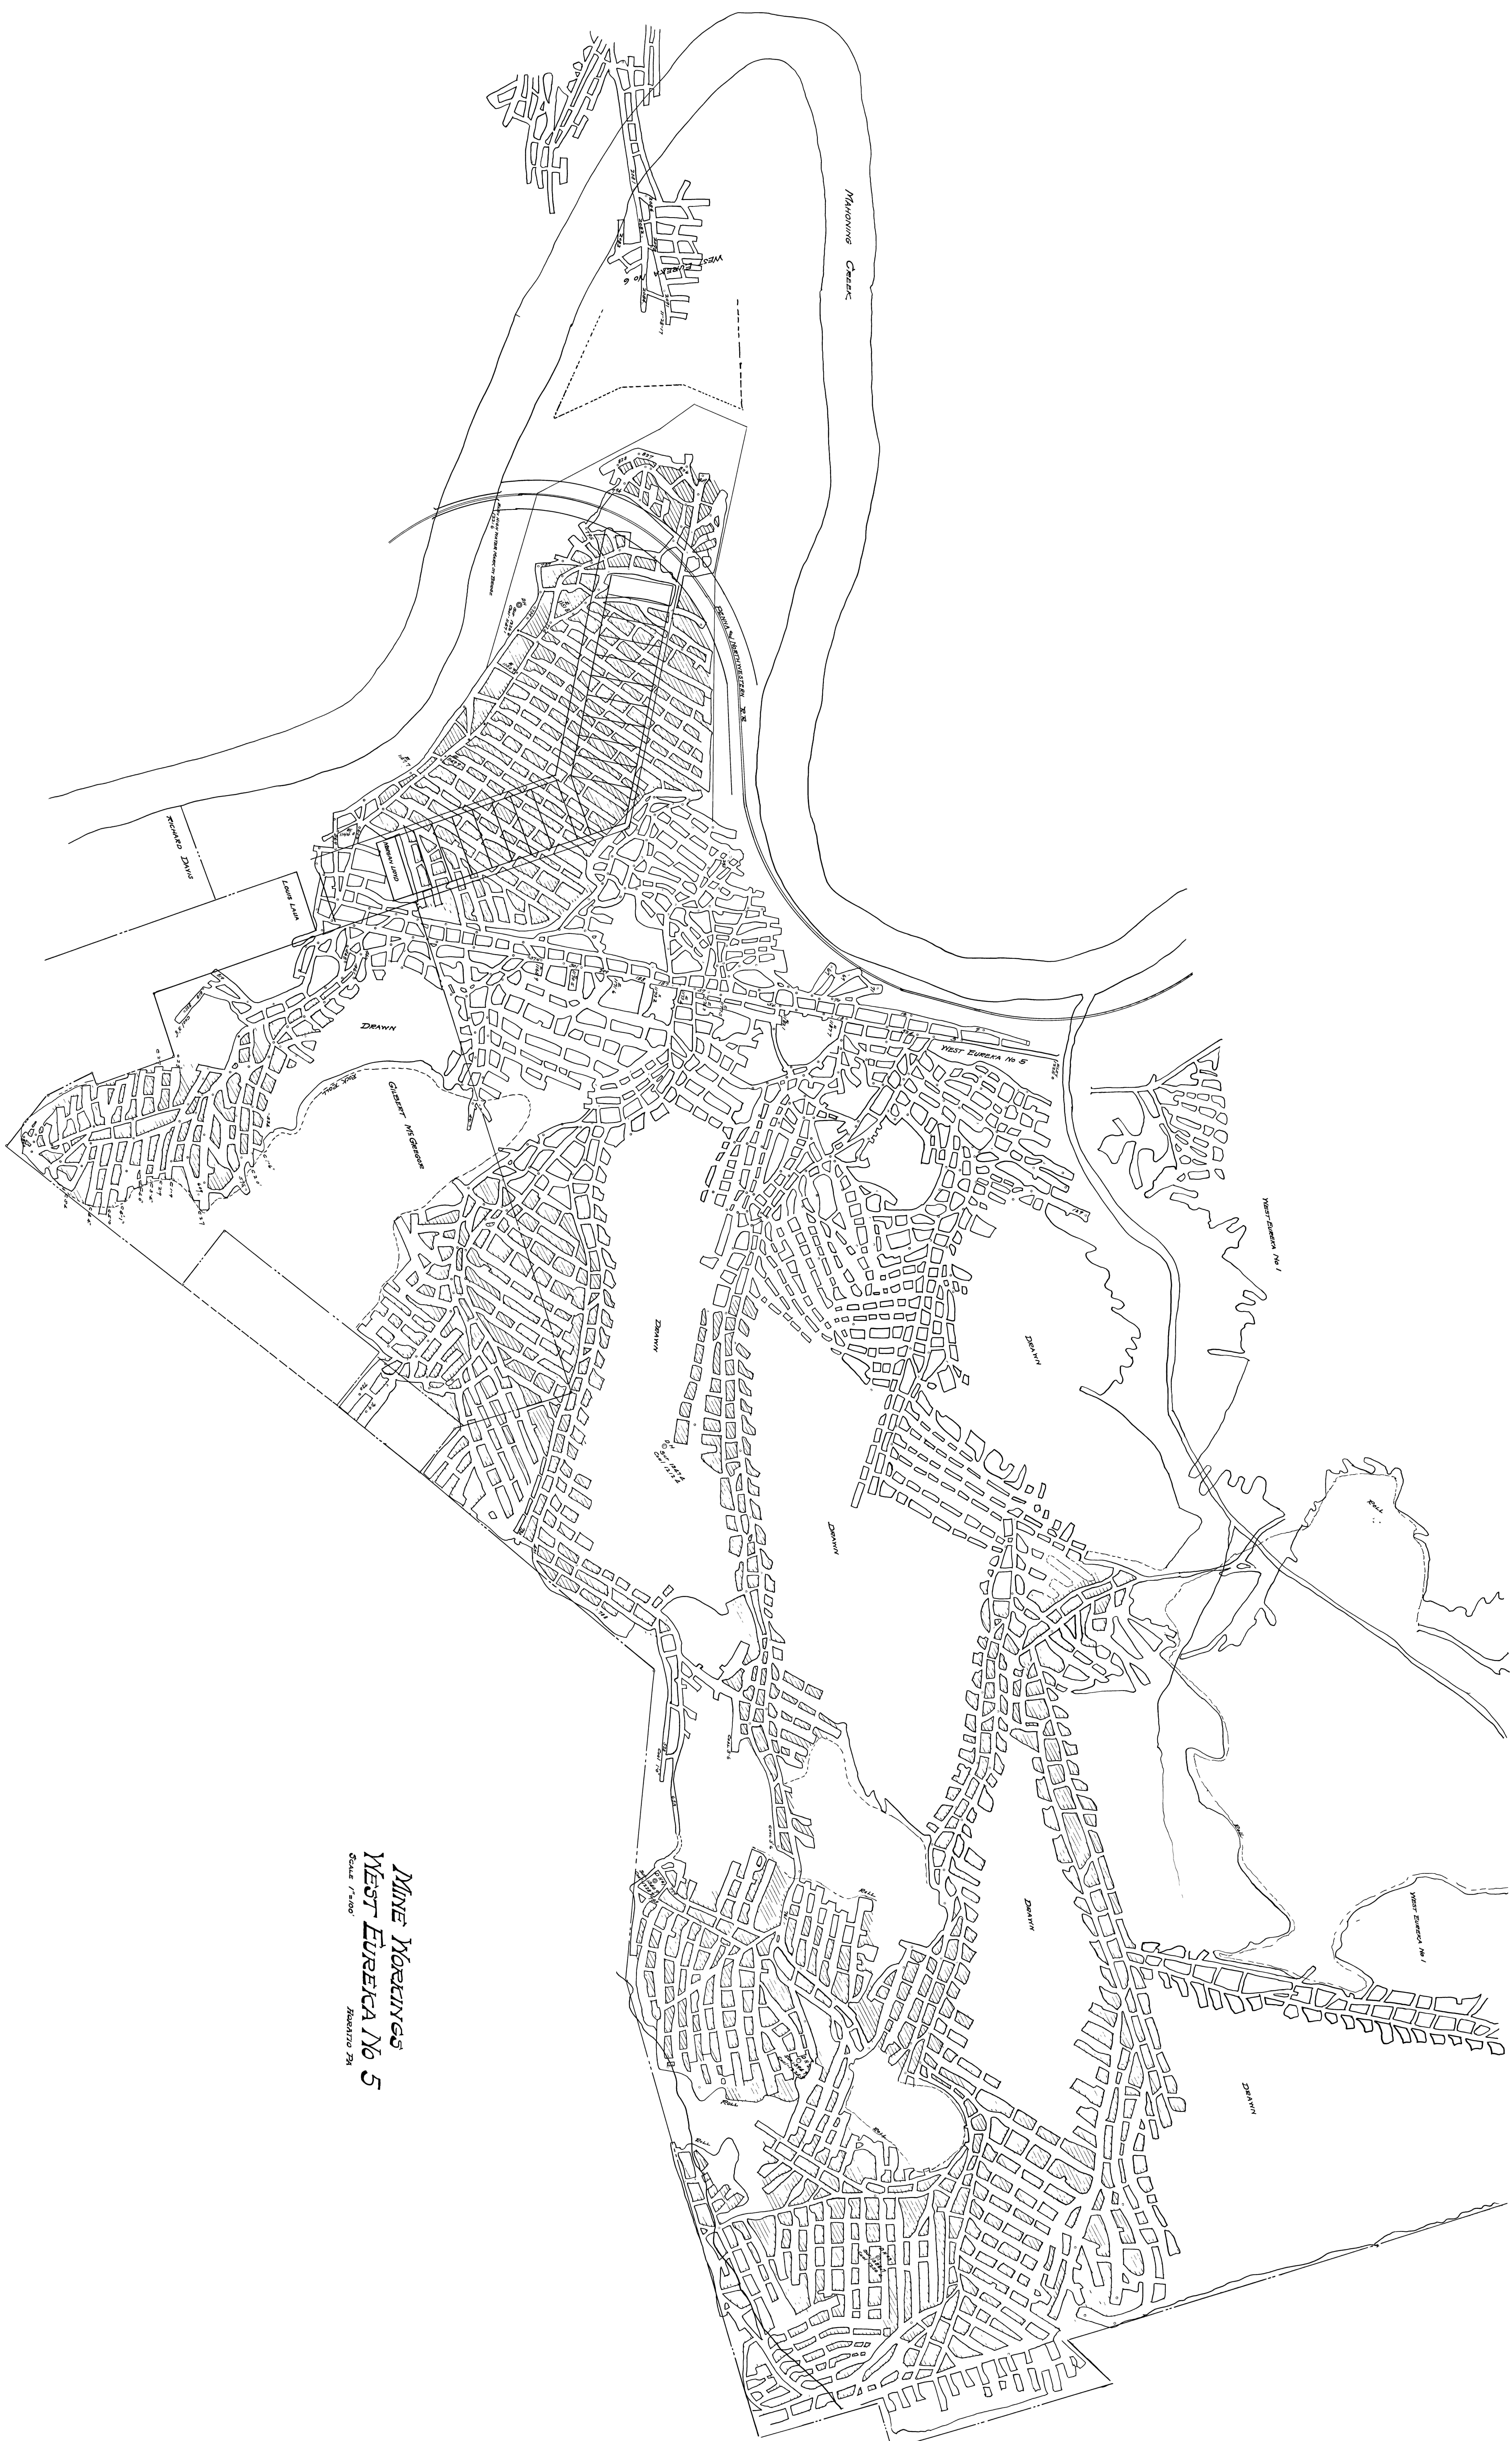

WEST EUREKA No 5
Scale 1"=100'
