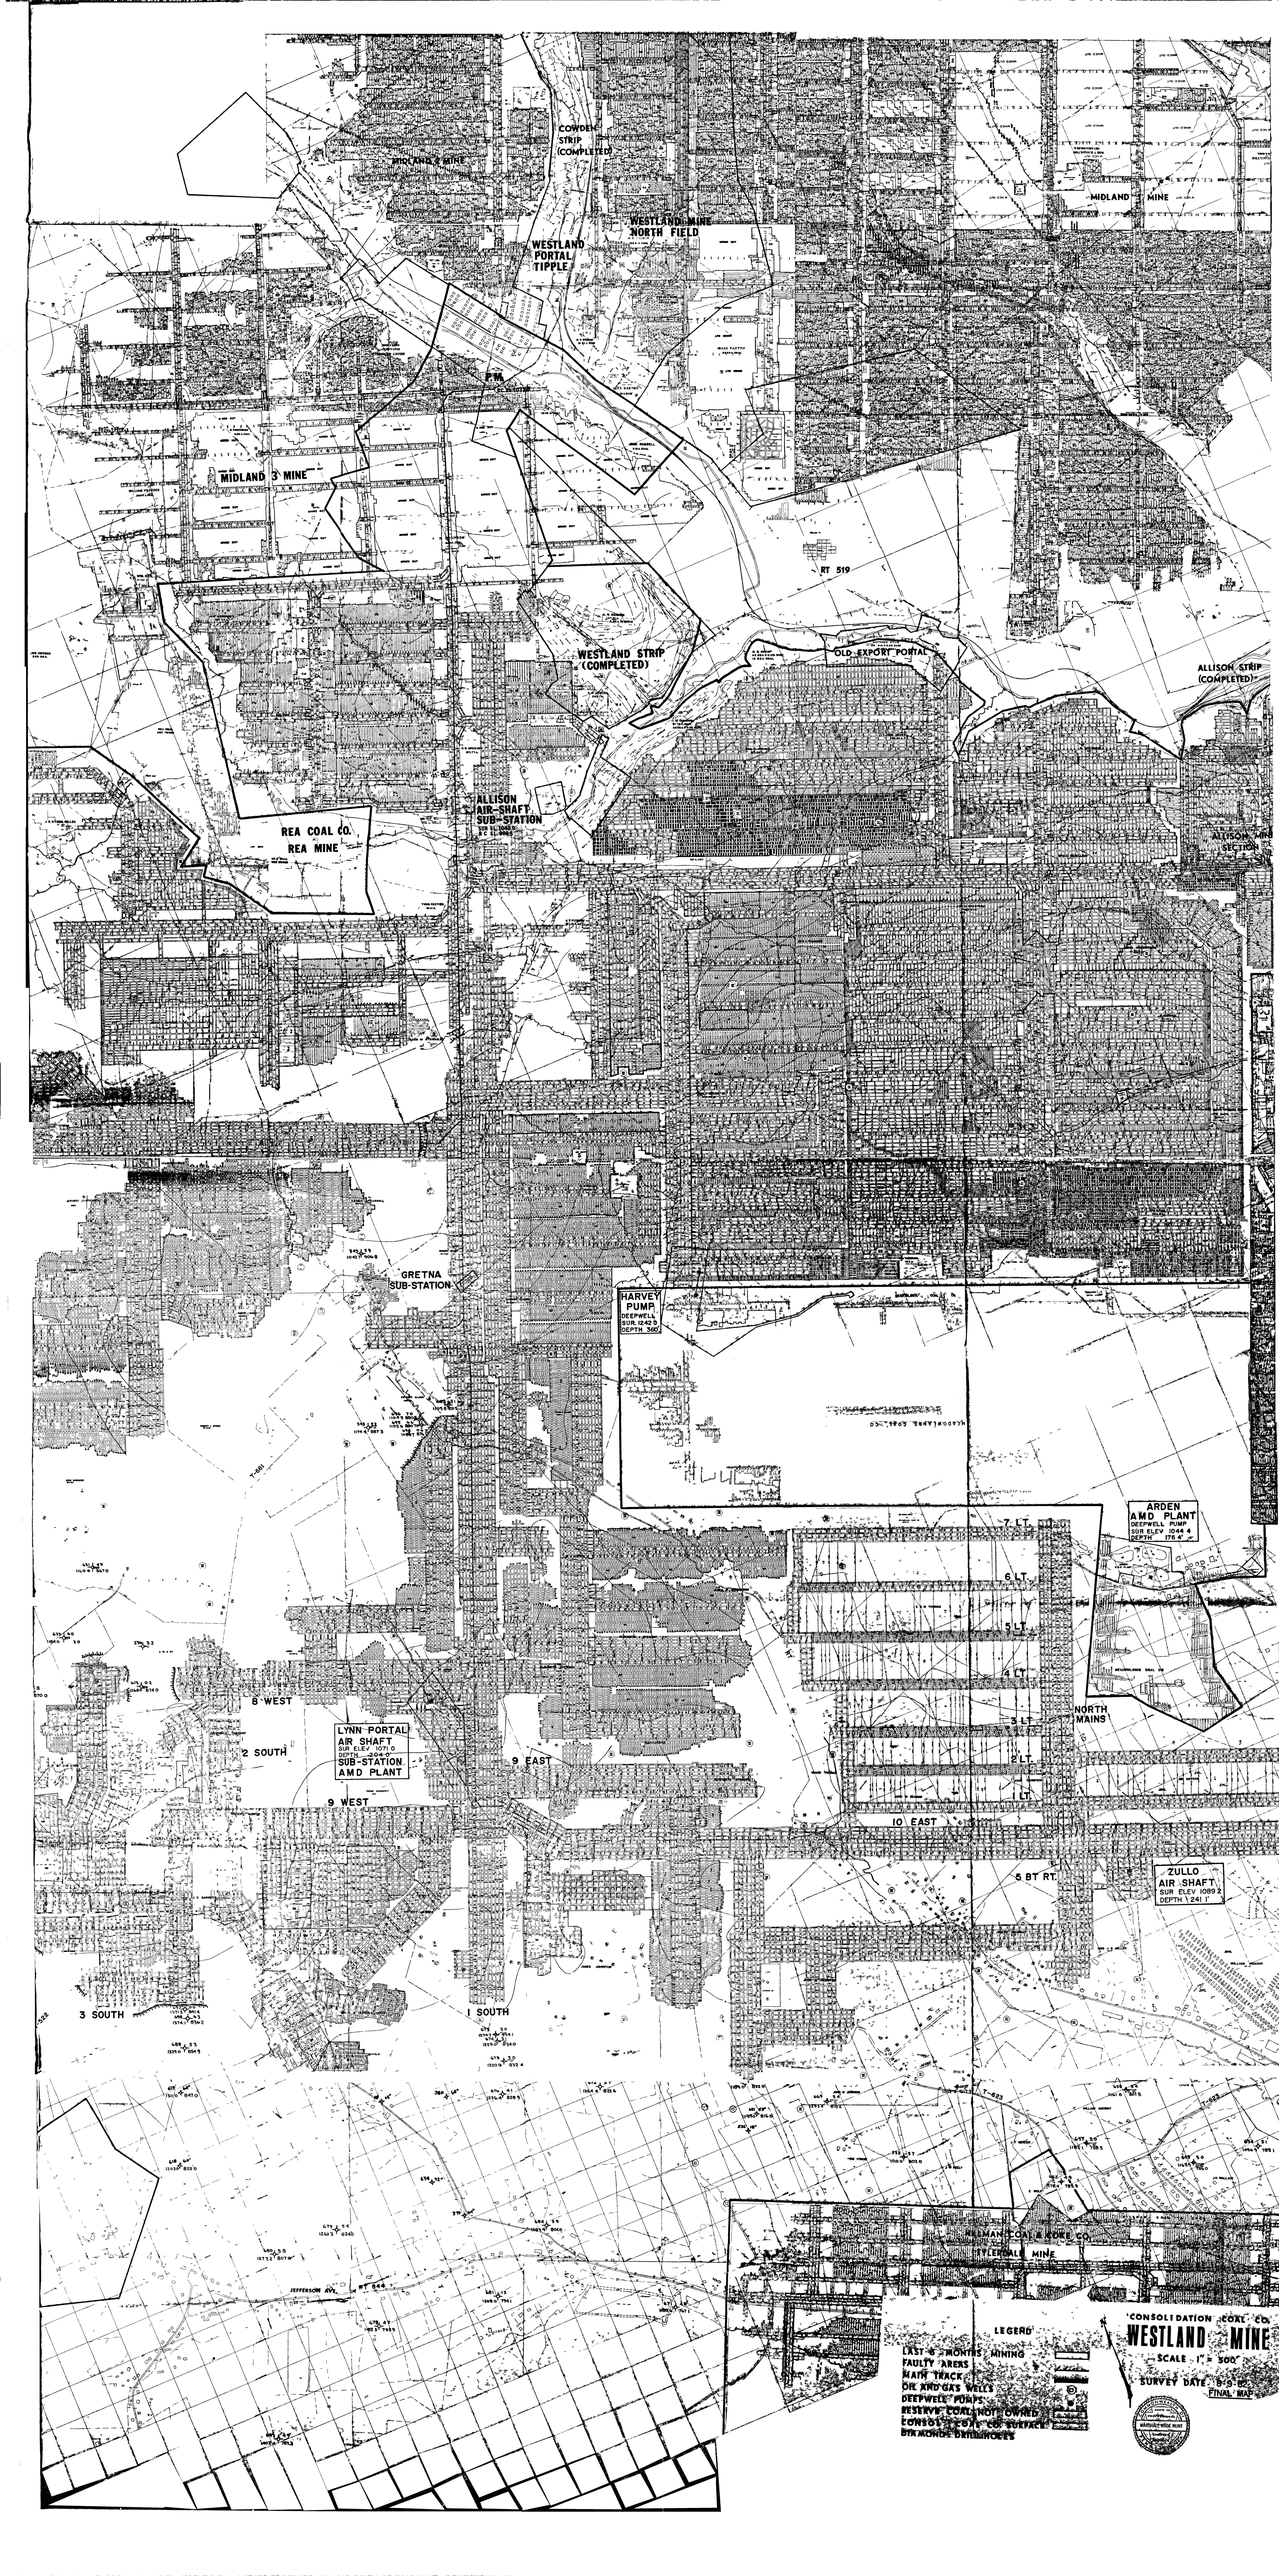

COWDEN STRIP (COMPLETED)
MIDLAND 2 MINE
WESTLAND PORTAL TIPPLE
WESTLAND MINE NORTH FIELD
MIDLAND MINE
MIDLAND 3 MINE
RT 519
WESTLAND STRIP (COMPLETED)
OLD EXPORT PORTAL
ALLISON STRIP (COMPLETED)
ALLISON AIR SHAFT SUB-STATION
REA COAL CO. REA MINE
ALLISON MINE SECTION
GRETNA SUB-STATION
HARVEY PUMP DEEPWELL SUR. 1242.9 DEPTH 360'
ARDEN AMD PLANT DEEPWELL PUMP SUR ELEV 1044.4 DEPTH 176.4'
7 LT
6 LT
5 LT
4 LT
3 LT
2 LT
LT
NORTH MAINS
8 WEST
2 SOUTH
LYNN PORTAL AIR SHAFT SUR ELEV 1071.0 DEPTH 224.0' SUB-STATION AMD PLANT
9 EAST
9 WEST
10 EAST
5 BT RT
ZULLO AIR SHAFT SUR ELEV 1089.2 DEPTH 124.1'
3 SOUTH
1 SOUTH
RT 844
JEFFERSON AVE
RELIANCE COAL & COKE CO. HYLEBOS MINE
LEGEND
EST. # TONNES MINING
FAULTY AREAS
MAIN TRACK
OIL AND GAS WELLS
DEEPWELL PUMPS
RESERVE COAL NOT OWNED
CONSOL COAL CO. SURFACE
BTH MONDE DRILLHOLES
CONSOLIDATION COAL CO.
WESTLAND MINE
SCALE 1" = 500'
SURVEY DATE 9-9-82
FINAL MAP