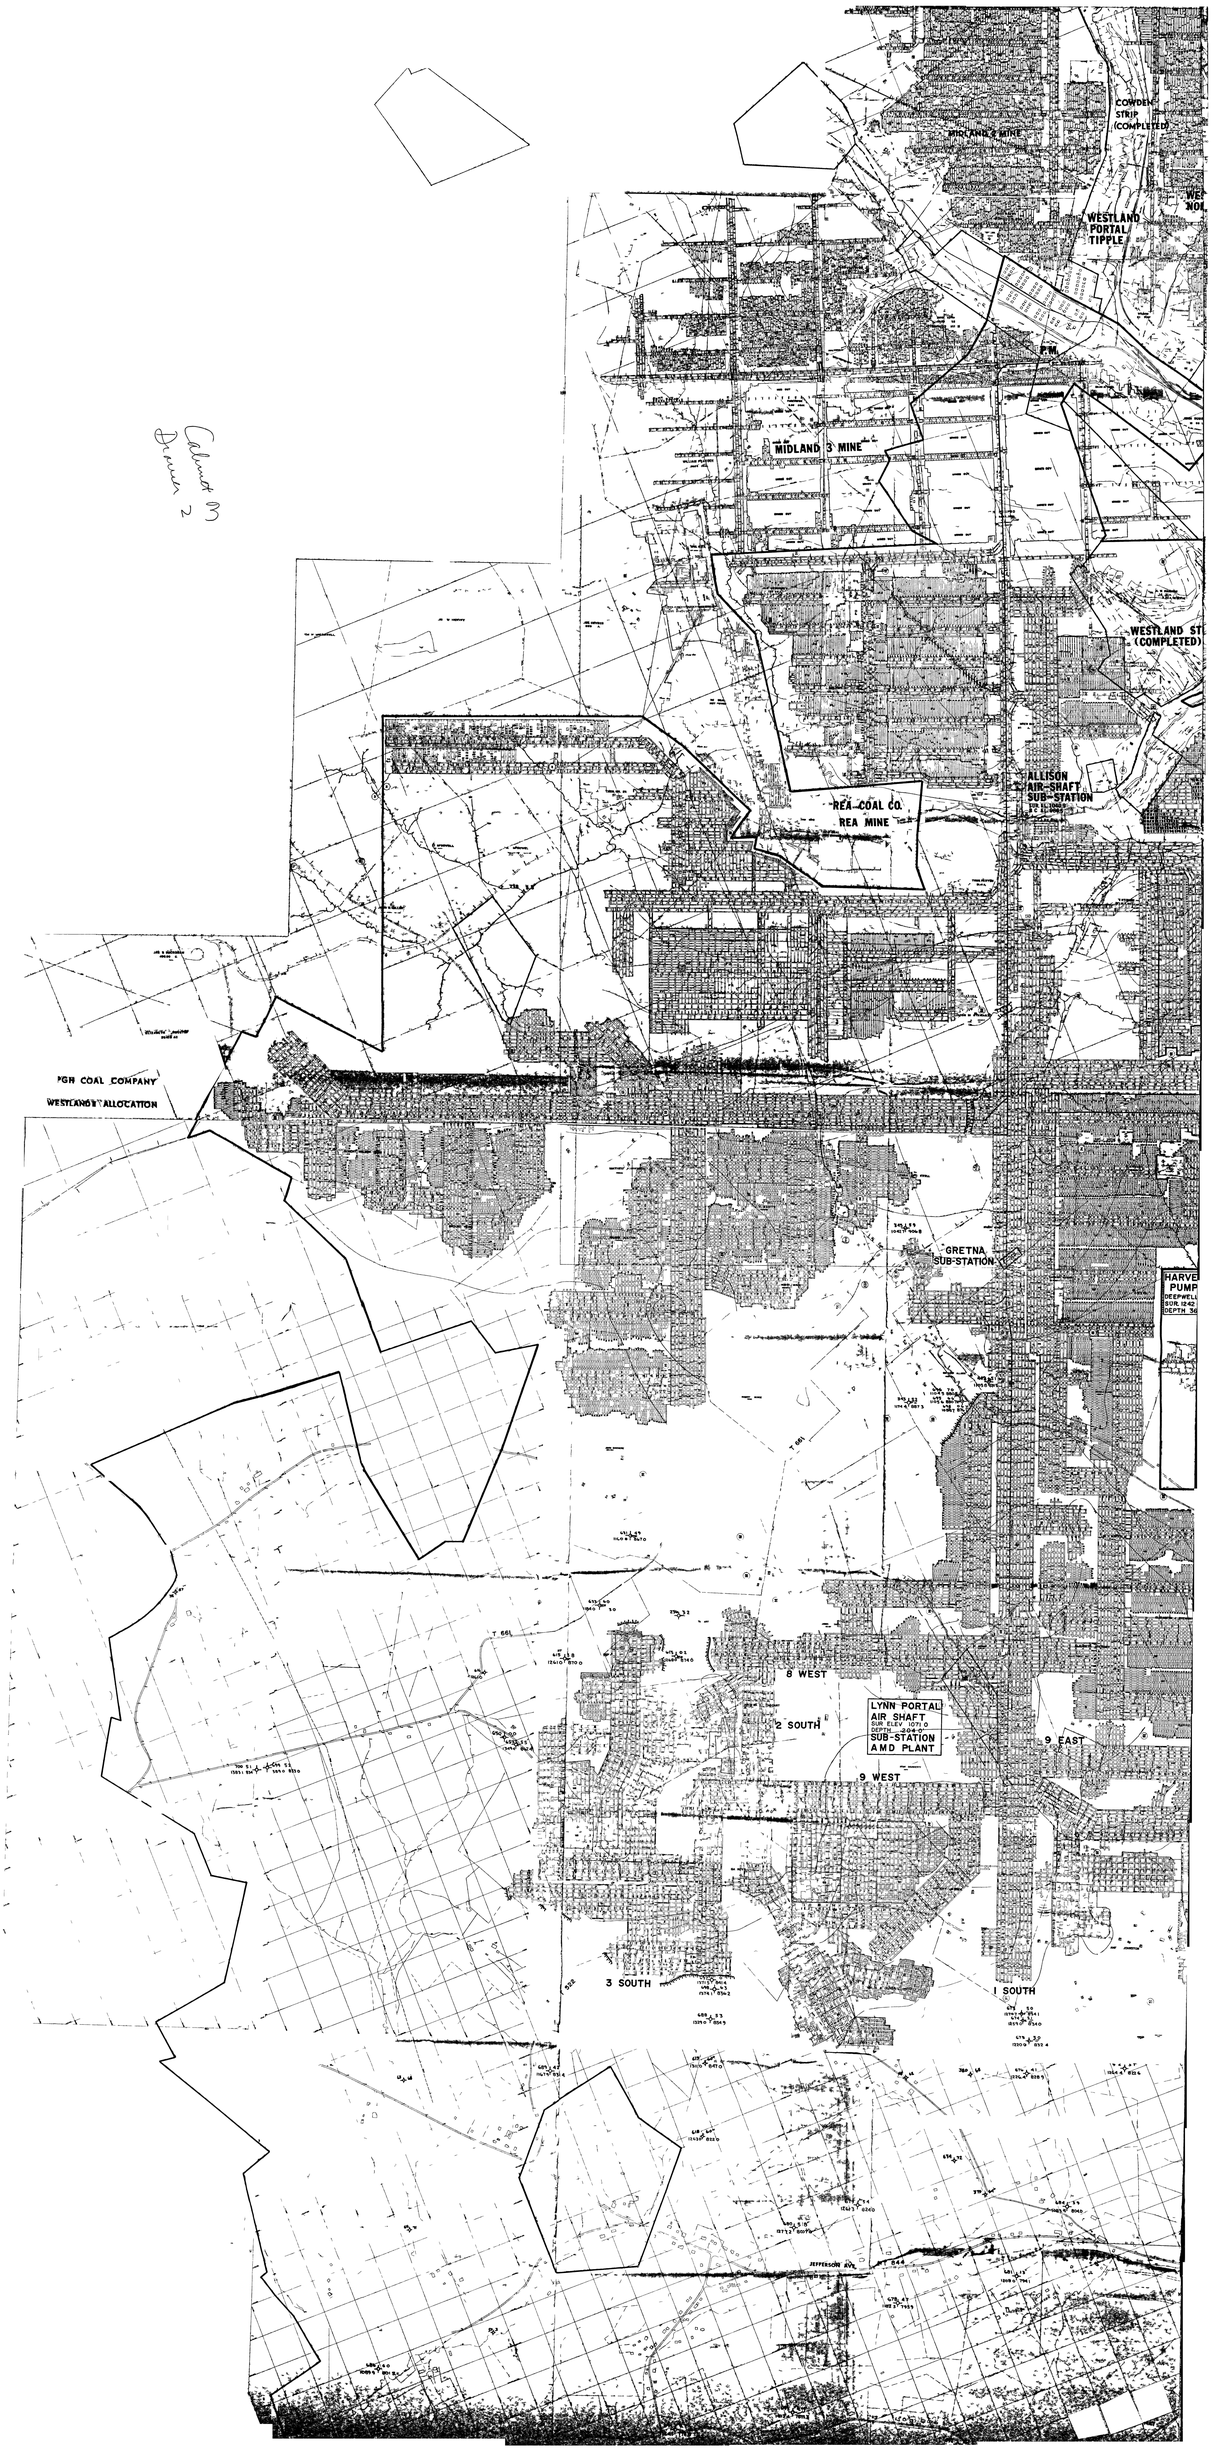
COWDEN STRIP (COMPLETED)
MIDLAND 2 MINE
WESTLAND PORTAL TIPPLE
MIDLAND 3 MINE
WESTLAND ST (COMPLETED)
ALLISON AIR-SHAFT SUB-STATION
REA COAL CO.
REA MINE
PGH COAL COMPANY
WESTLAND "I" ALLOCATION
GRETNA SUB-STATION
HARVE PUMP
DEEPWEL BOR. 12-62 DEPTH 36
8 WEST
2 SOUTH
LYNN PORTAL AIR SHAFT
SUB-STATION
AMD PLANT
9 EAST
9 WEST
3 SOUTH
1 SOUTH
JEFFERSON AVE.