



70 acres
Red Stone Vein Coal
Average thickness of vein
3 feet 10 inches

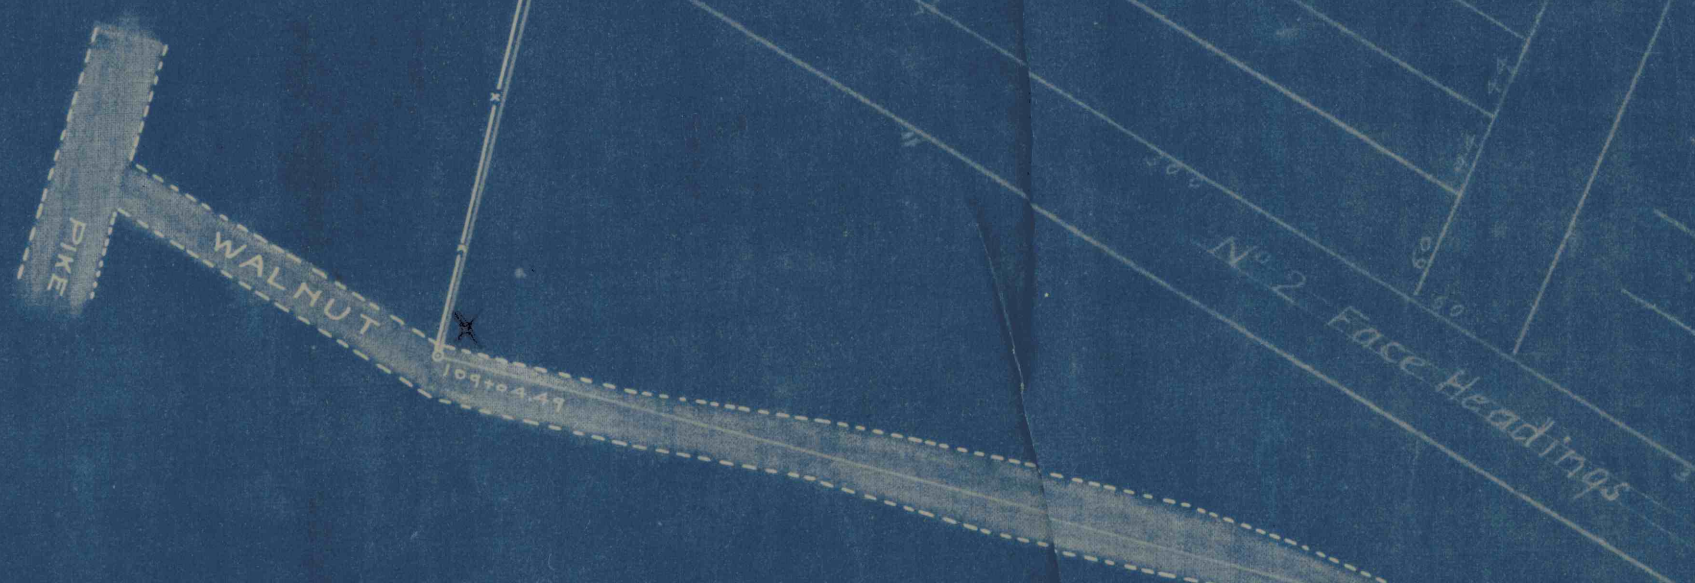

Hart-Markle Coal Mining Company
Mines located at West Newton
Rathbun Township, Westmoreland Co.,
Penna.

Office
137 North 6th Street
Connellsville, Pa.

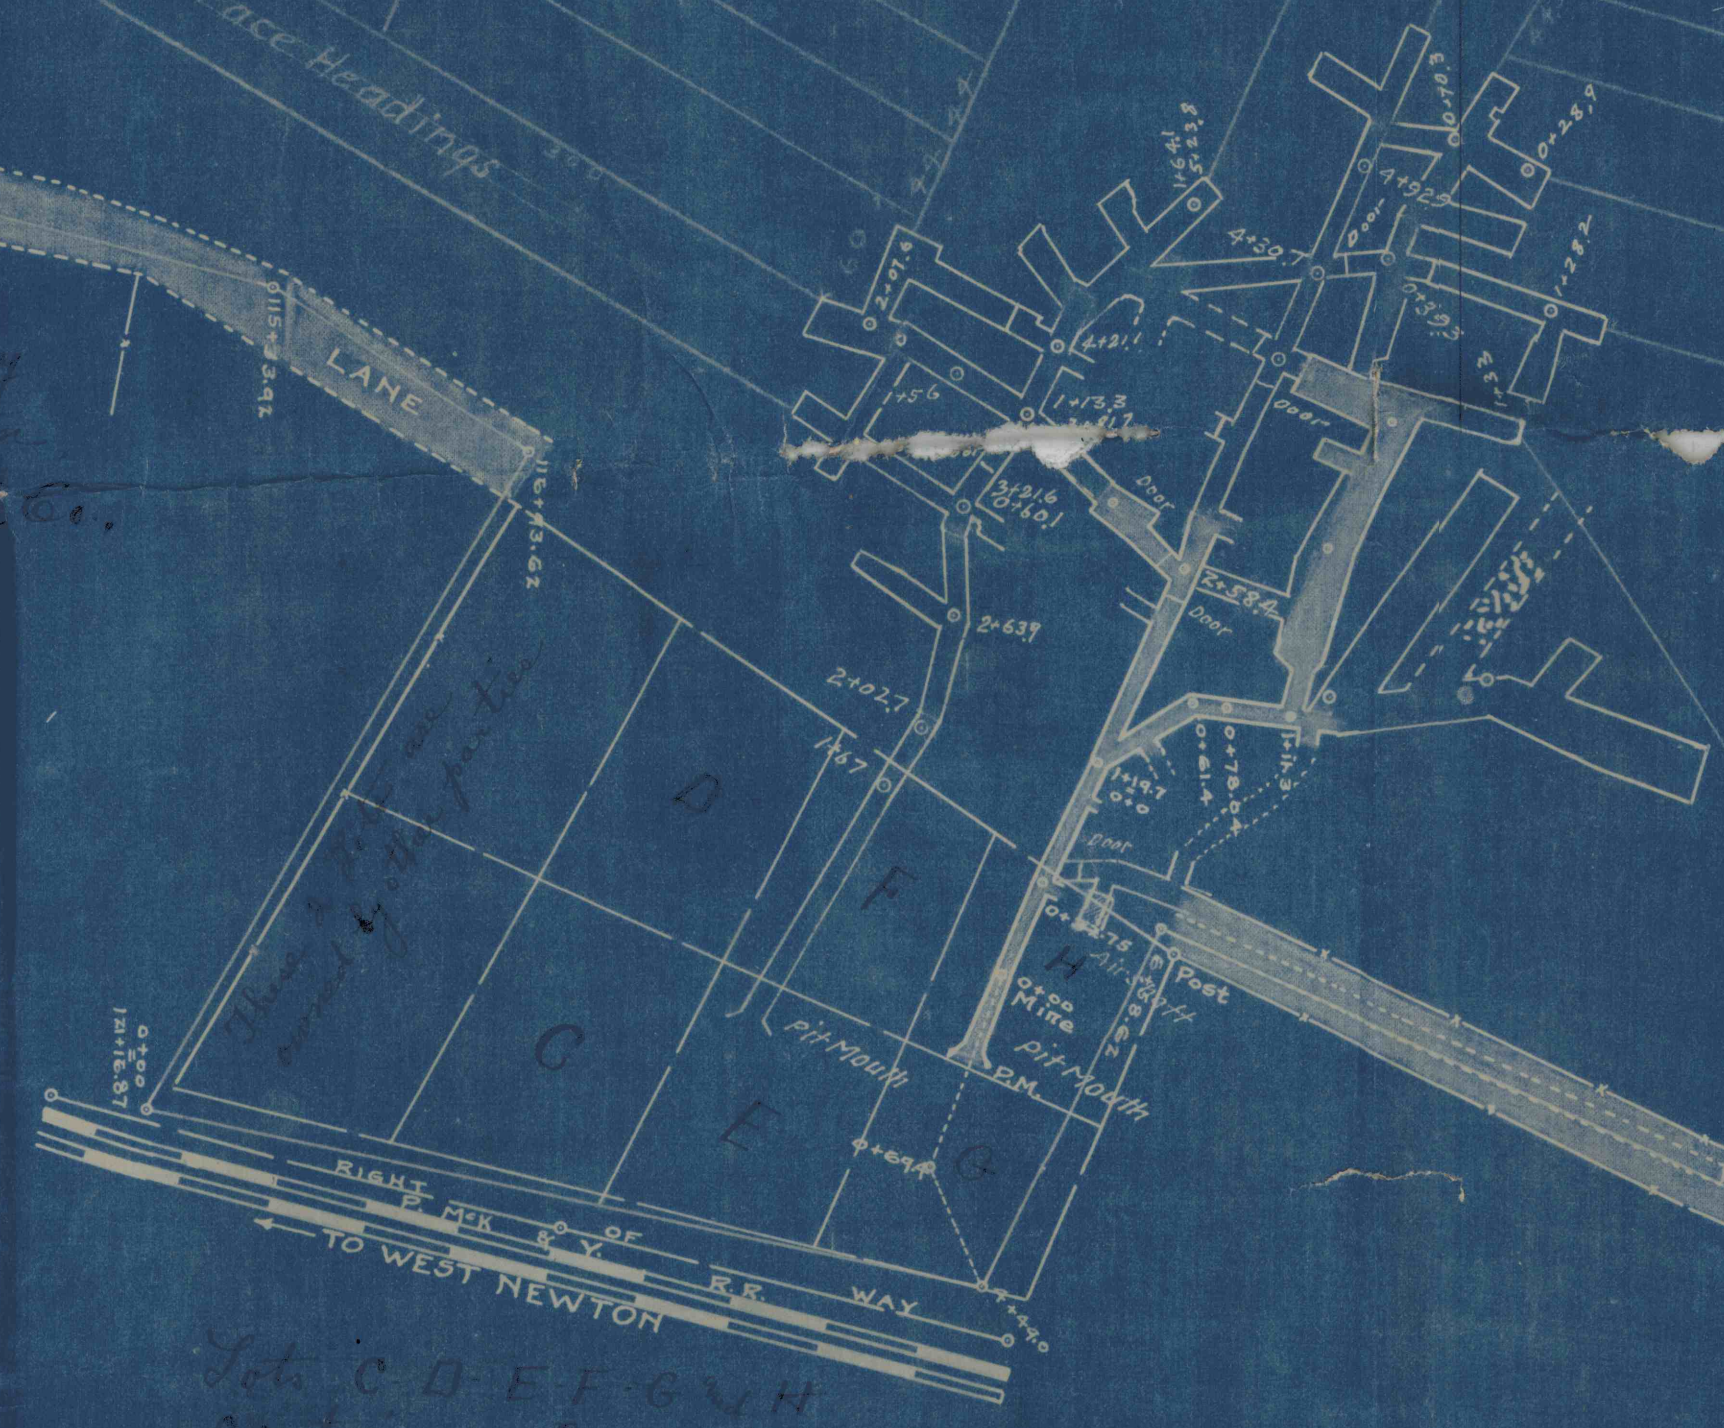

Lot C D E F G H
Containing 2 acres more
see plan

100 feet to 1 inch