


MARGARET NO. 11 MINE
NO. 2 PORTAL/NO. 3 PORTAL
FINAL MAP

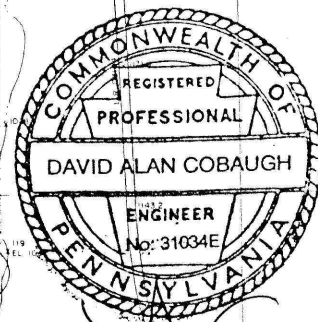

David Coblough

4" WATER MONITORING HOLE

DRIFT ENTRIES
SEALED/BACKFILLED

DRIFT ENTRIES
SEALED/BACKFILLED
NO. 2 PORTAL
NO. 3 PORTAL

PERMIT BOUNDARY

MARGARET No. 11 #2 MINE
SCALE 1"=400'
FINAL POSTING
JANUARY 3, 1996



MARGARET NO. 11 #2