

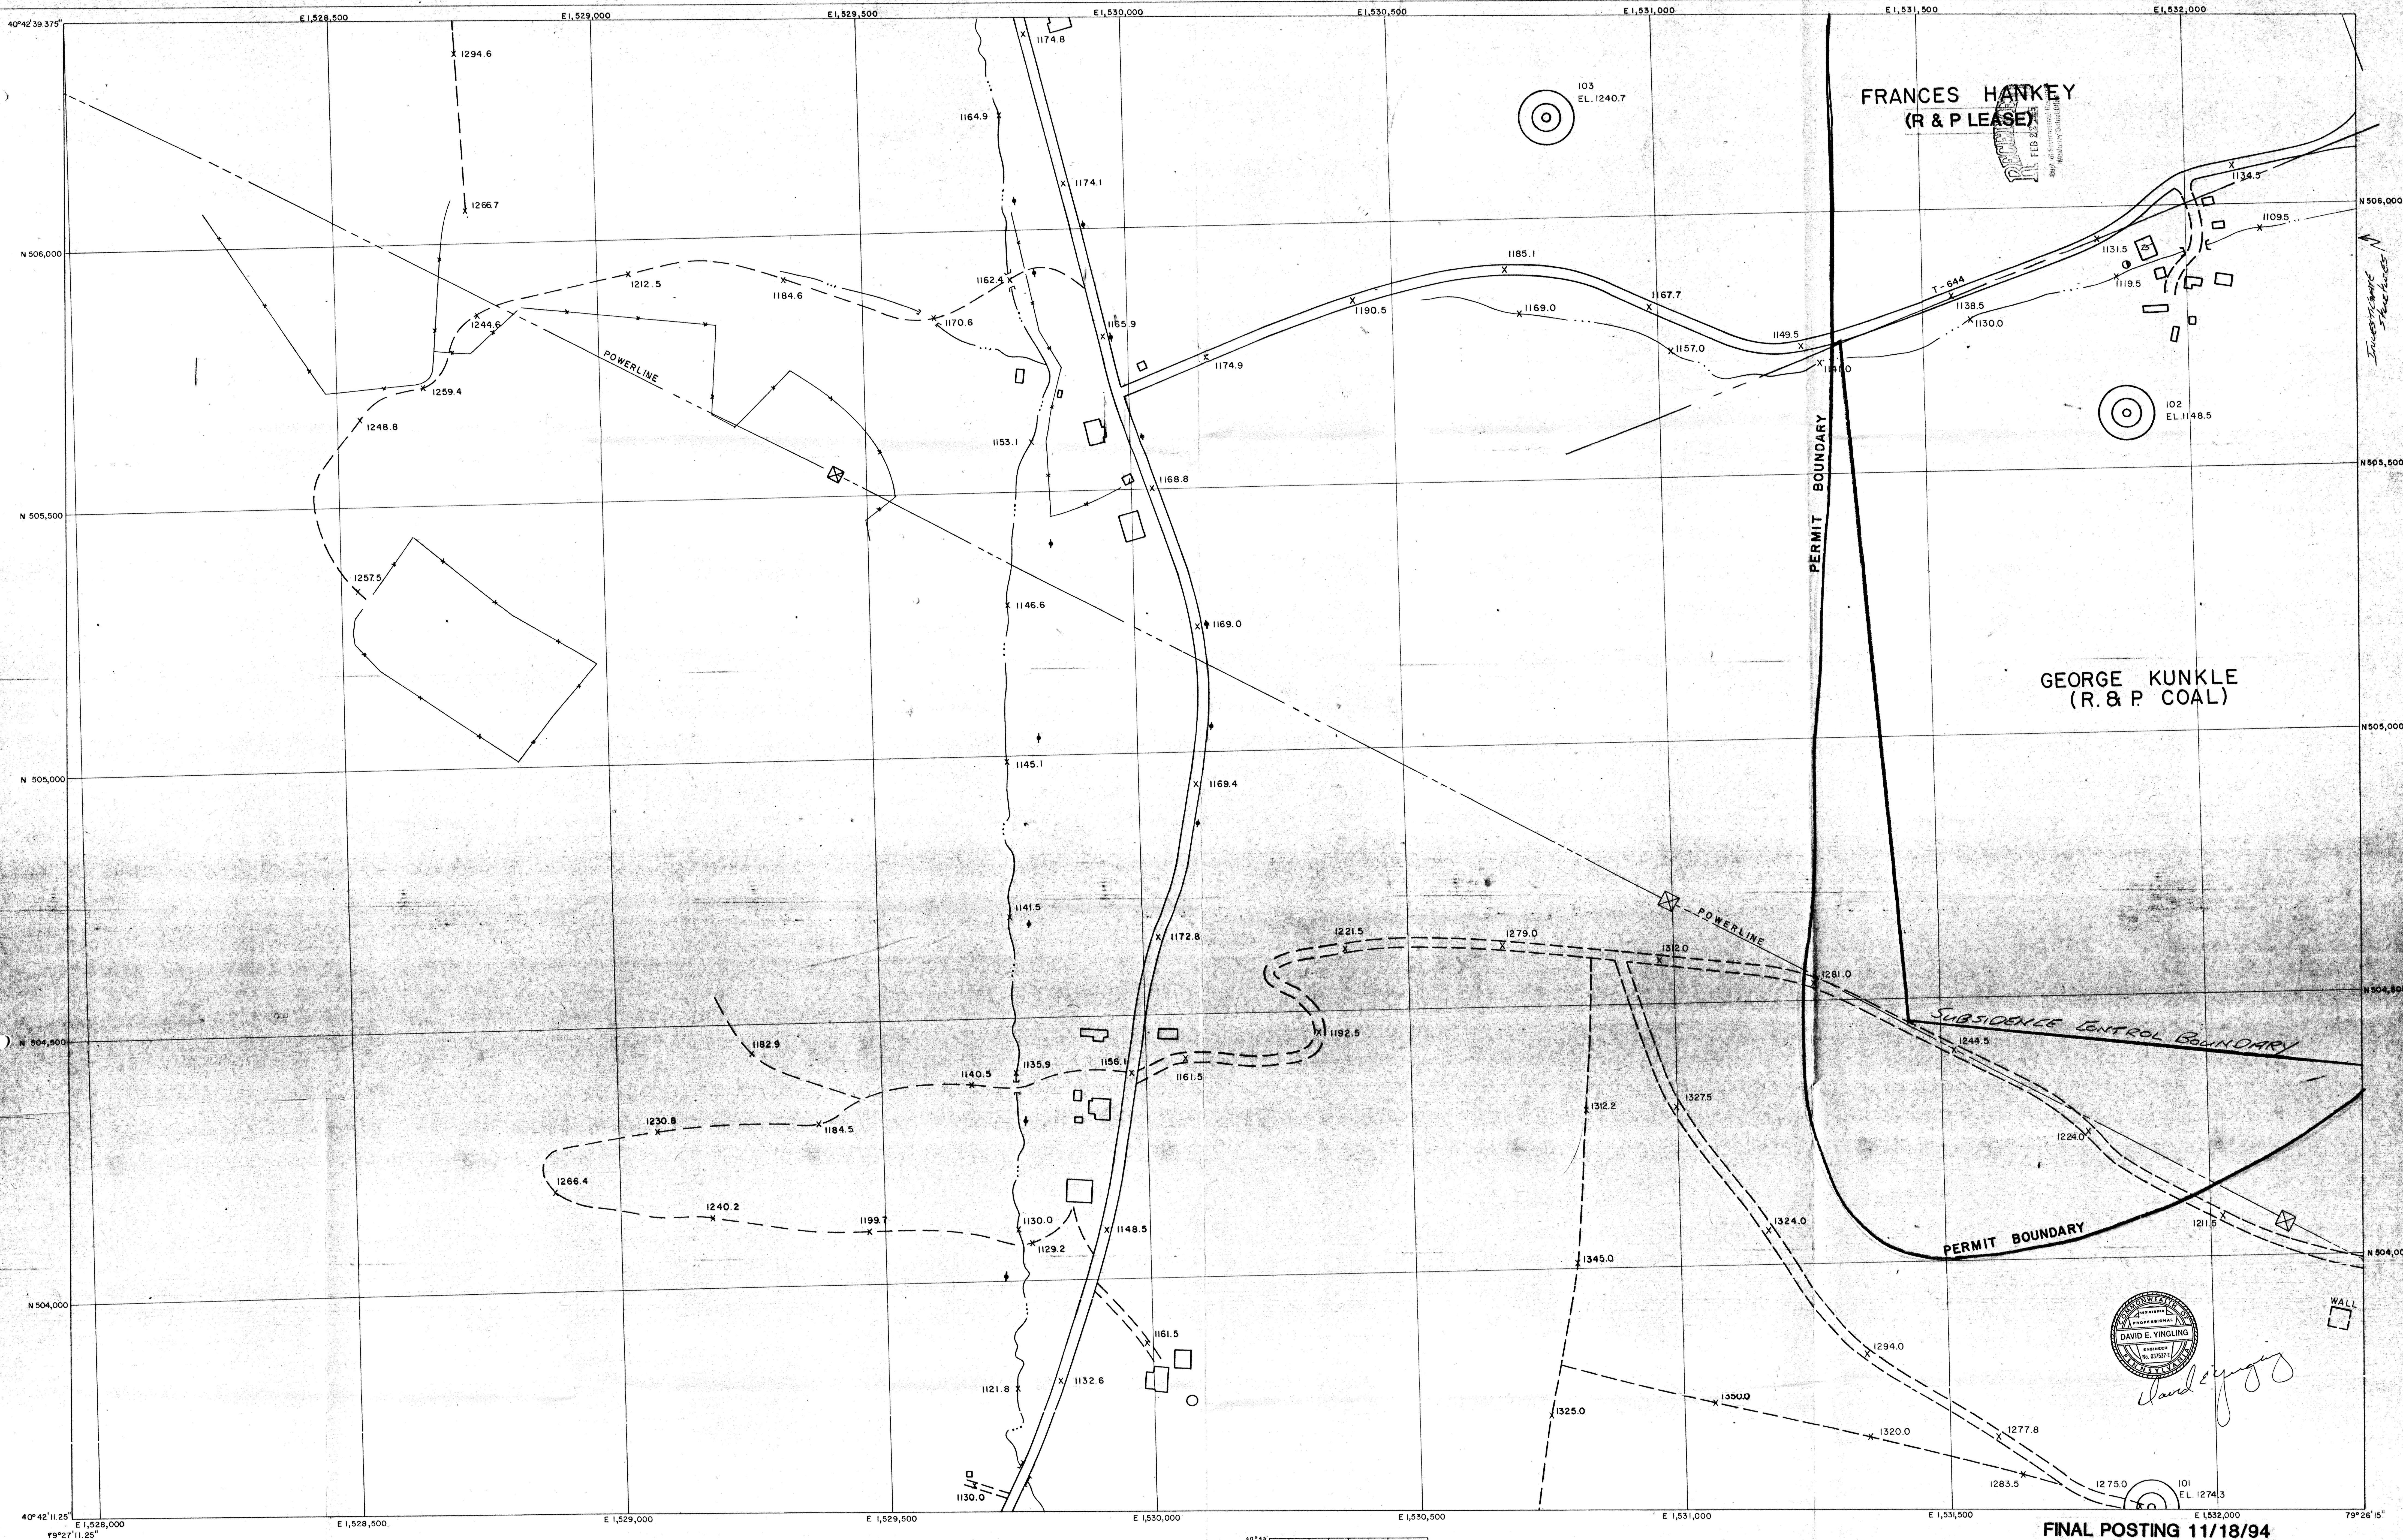


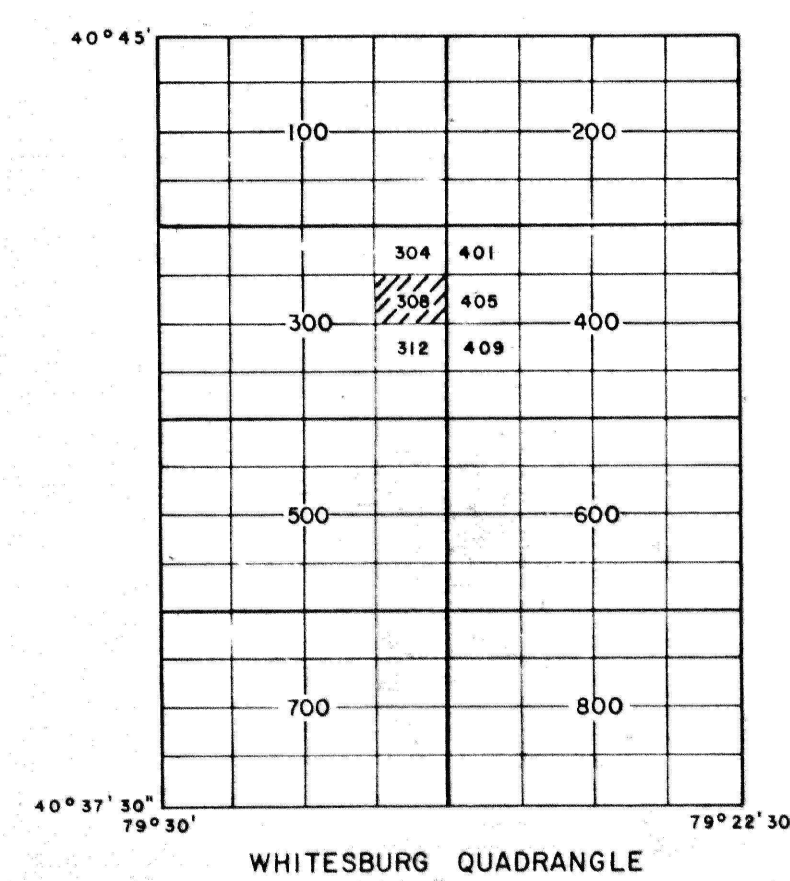

UPPER FREEPORT SEAM
(MSHA) NO.
MARGARET No. II No. 3 PORTAL
PERMIT (DER) NO. 03851304

Prepared By
MICHAEL BAKER, JR., INC.
Consulting Engineers
Beaver, Pennsylvania

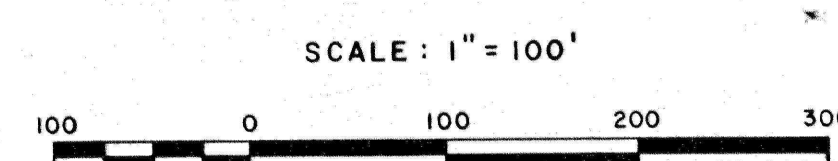

FINAL POSTING 11/18/94

KEYSTONE COAL MINING CORP.

MARGARET No.11- No.3 PORTAL

KITTANNING TOWNSHIP

WHITESBURG AREA

ARMSTRONG COUNTY

WHITESBURG QUADRANGLE

SHEET NO. 403730 - 792230/308

MARG-11-N03-300