

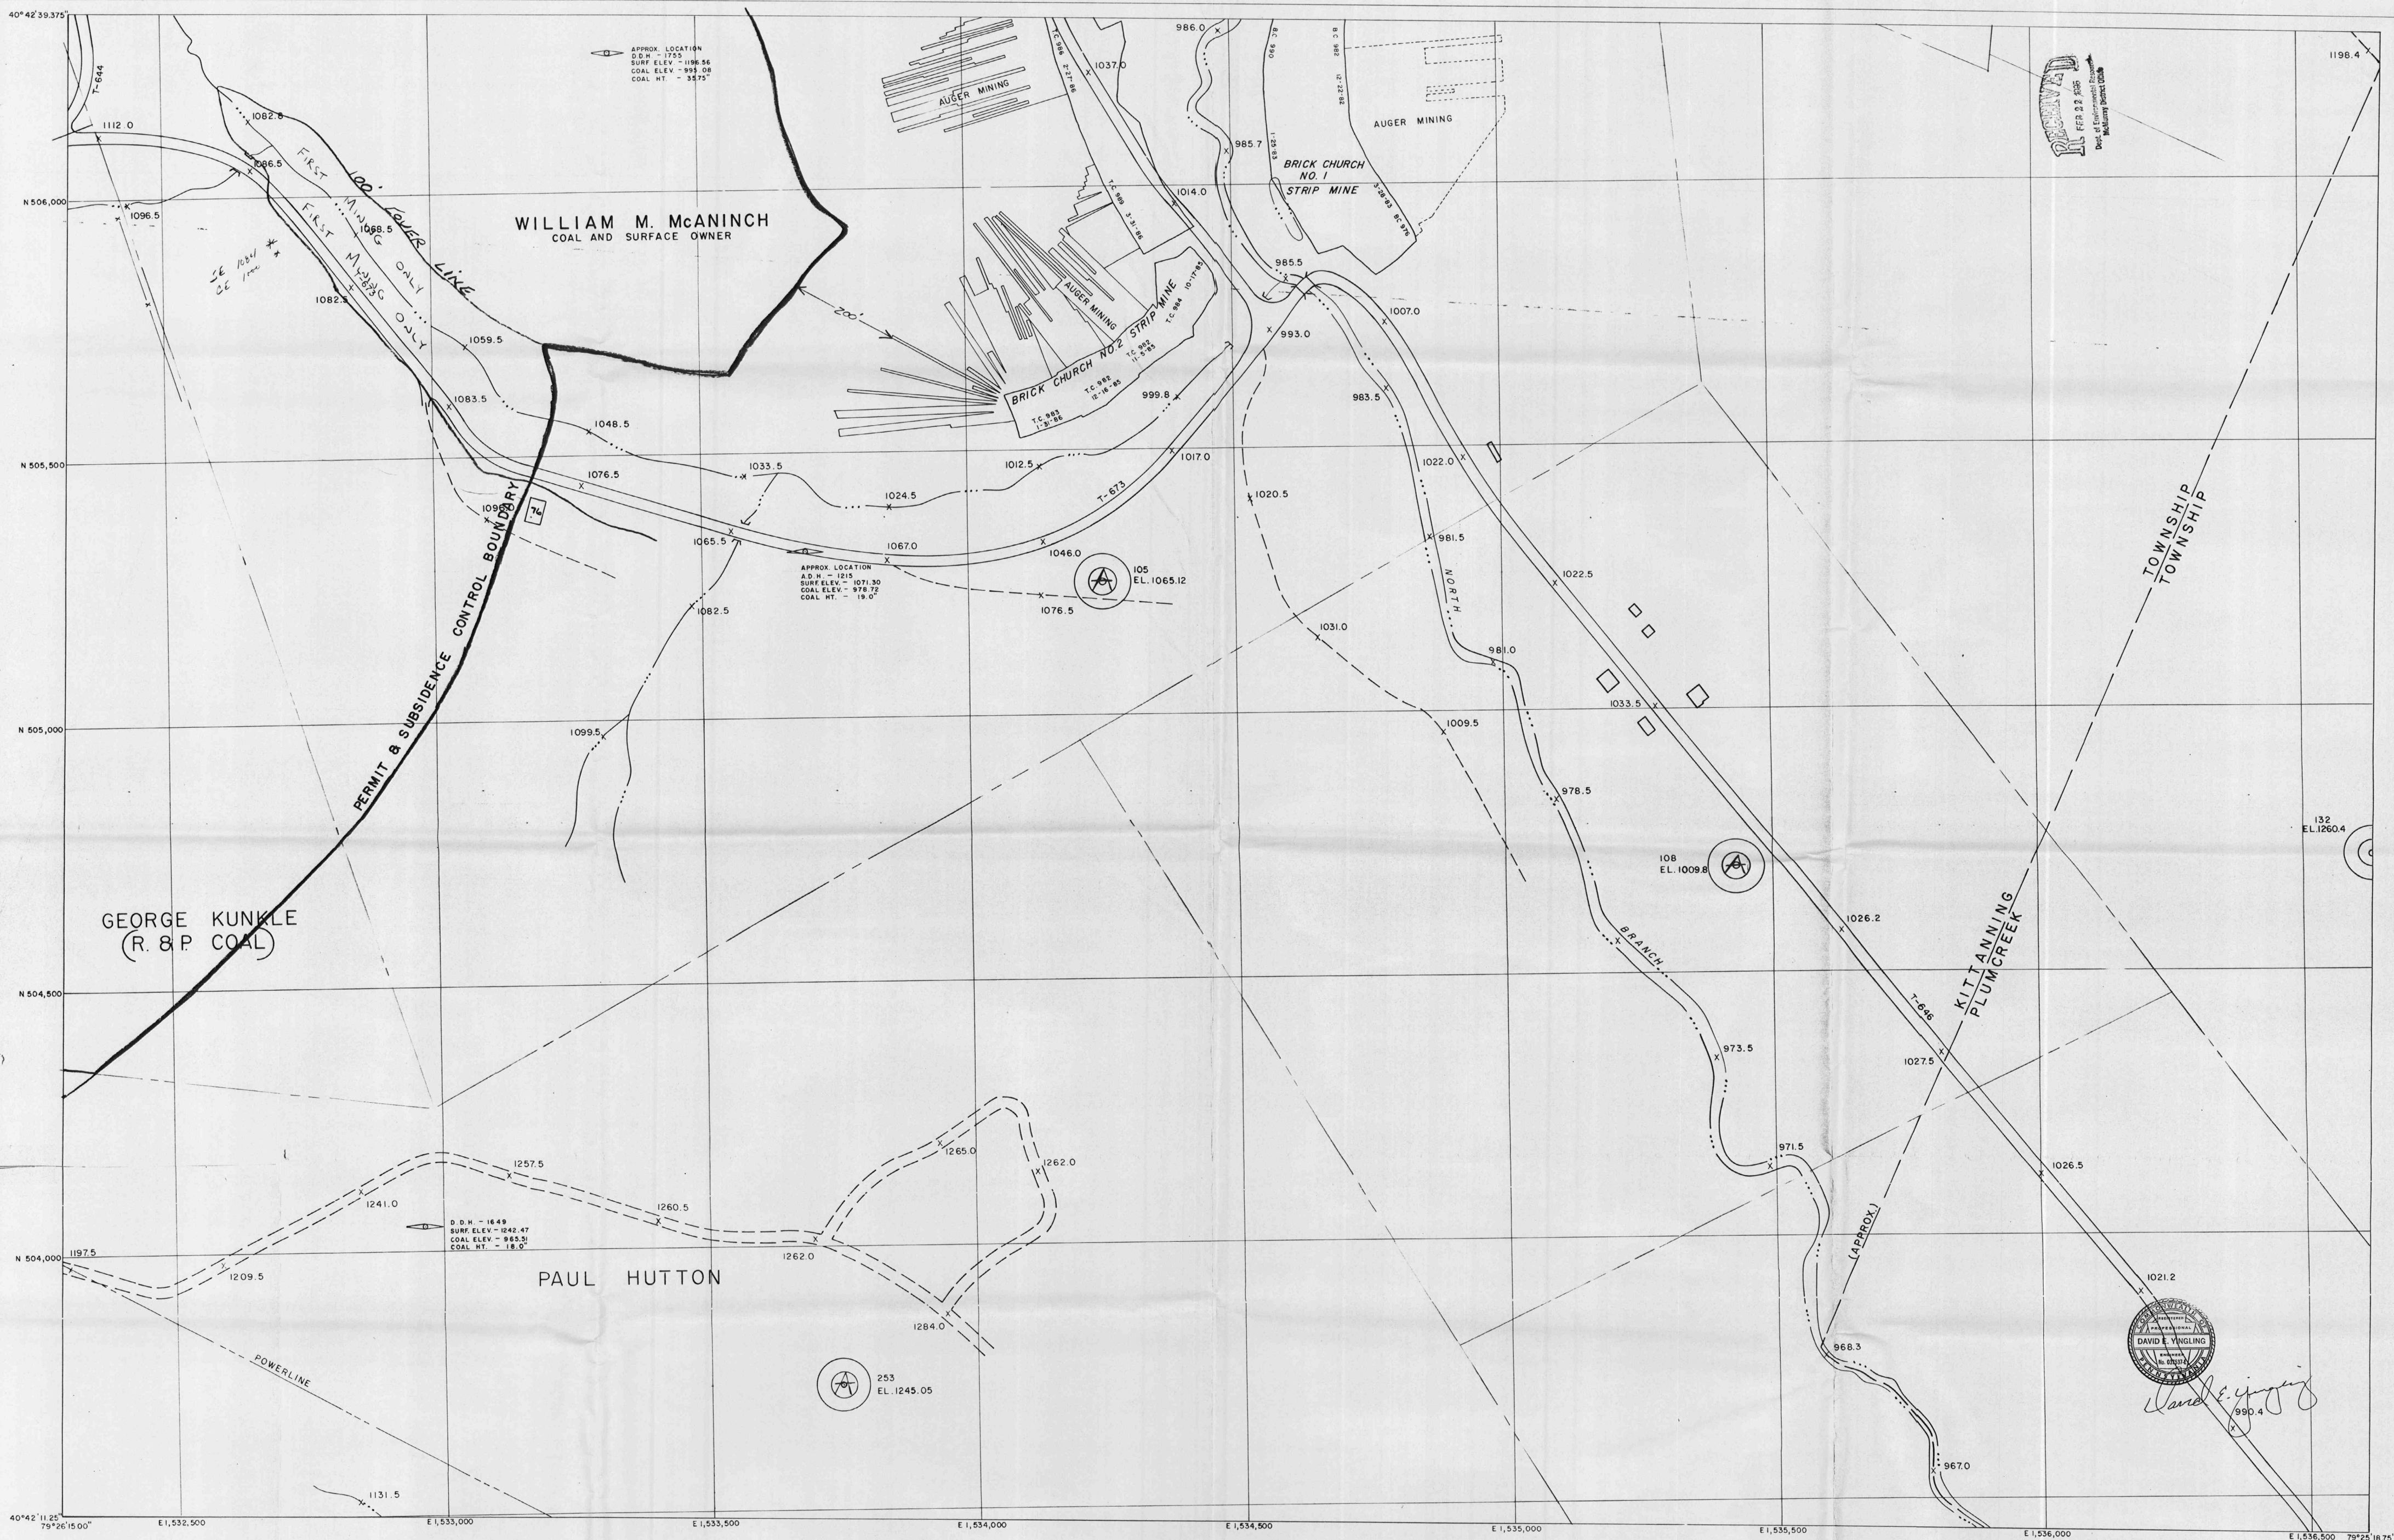


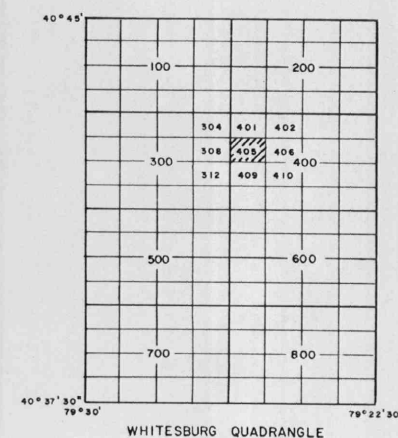

UPPER FREEPORT SEAM
MARGARET NO. 11 NO. 3 PORTAL (MSHA) NO. 03851304
PERMIT (DER) NO. 03851304

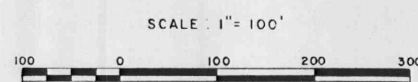

FINAL POSTING 11/18/94
KEYSTONE COAL MINING CORP.
MARGARET NO. 11 NO. 3 PORTAL
KIT TANNING TOWNSHIP
WHITESBURG AREA
ARMSTRONG COUNTY
WHITESBURG QUADRANGLE
SHEET NO. 403730 - 792230/405

Prepared By
MICHAEL BAKER, JR., INC.
Consulting Engineers
Beaver, Pennsylvania