


Assessed Value \$2200, approx. 10 acres.
average coal height 64 inches Pbg. Seam.

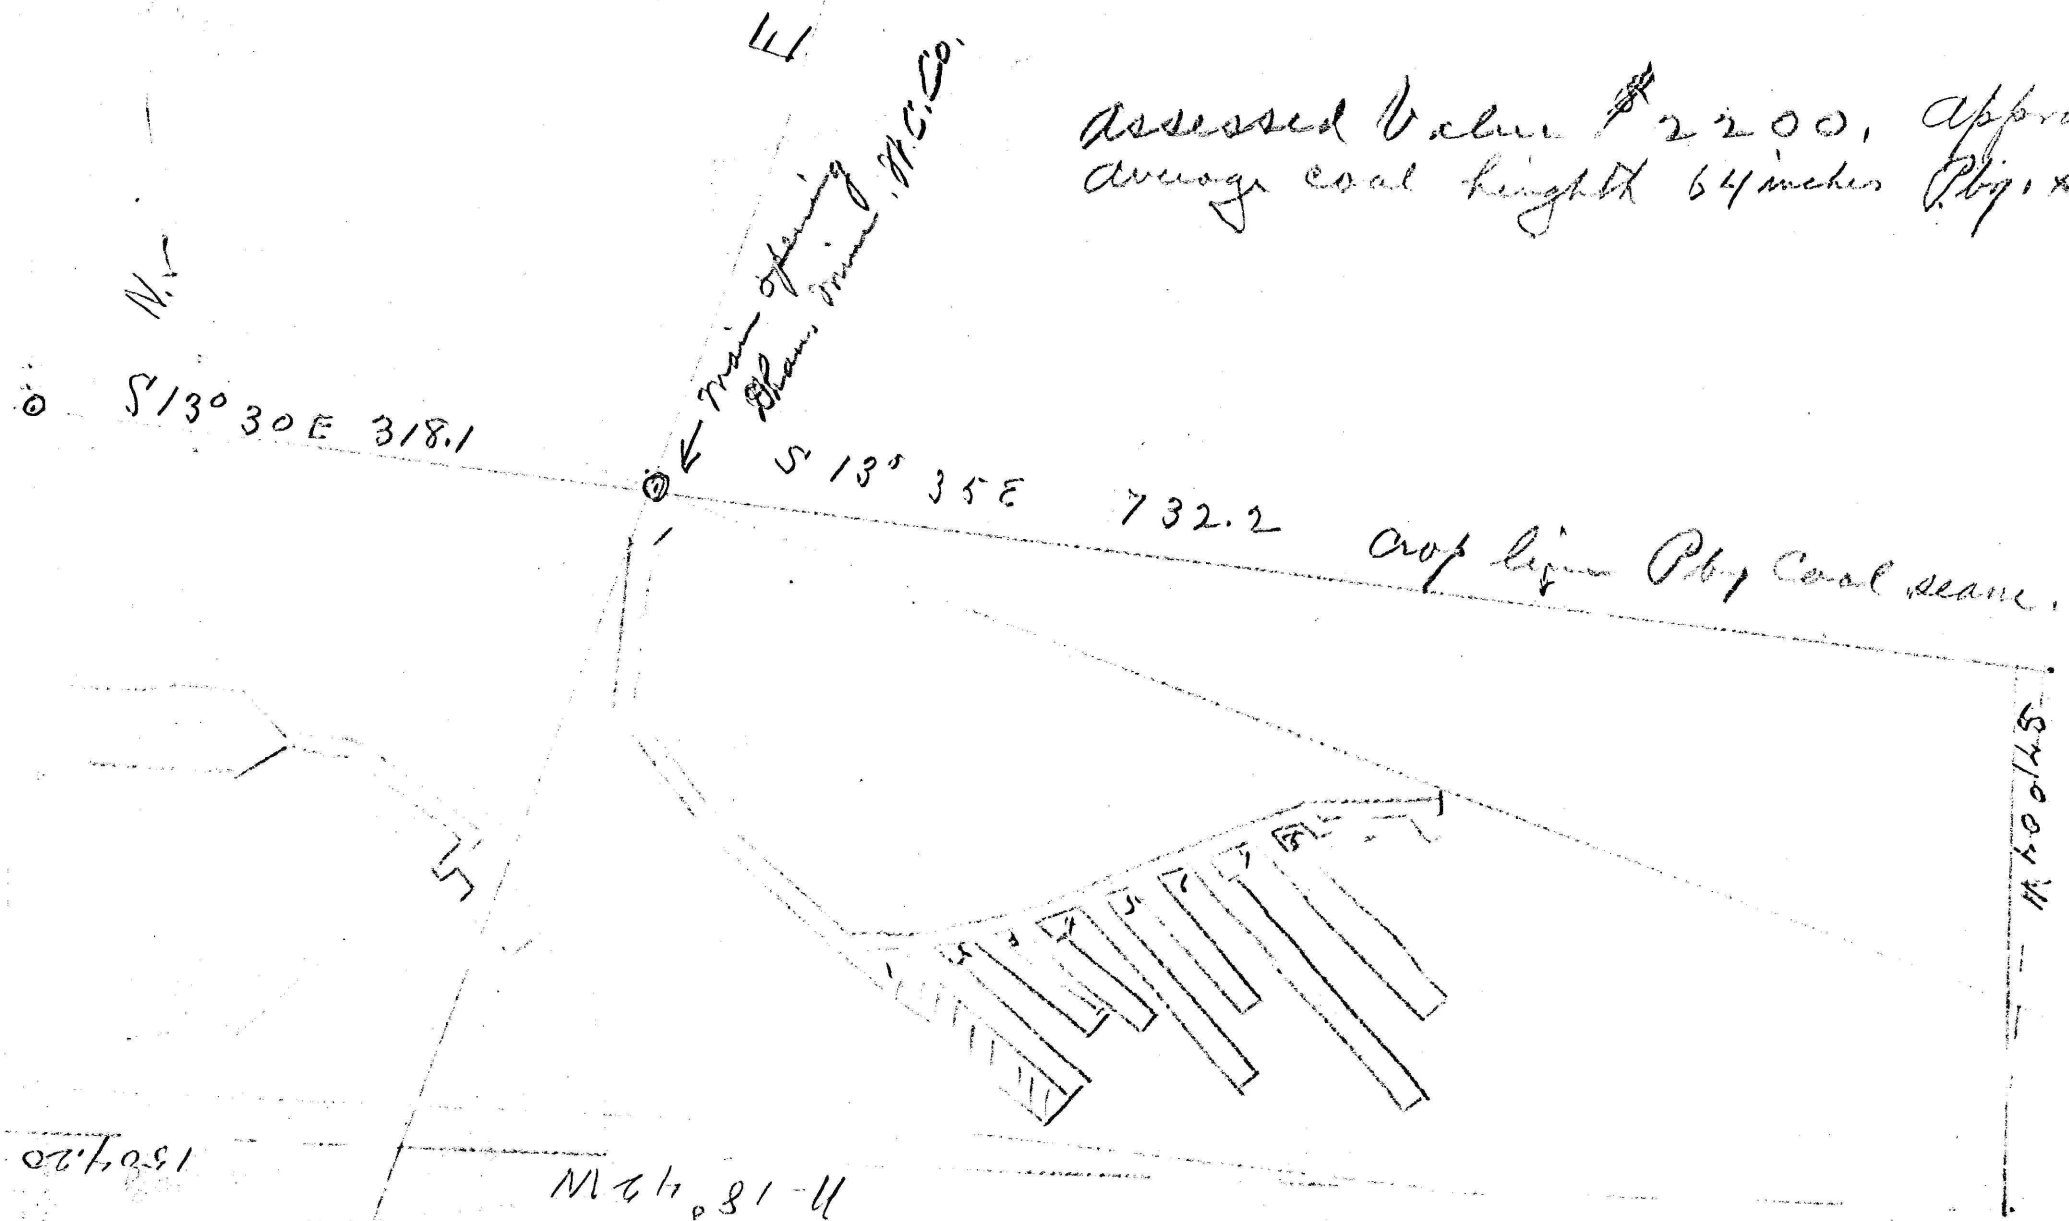

Westland Coal Co.
Mount Pleasant Twp.
Washington Co. Pa.

Pittsburg Coal Seam.

Scale 1" = 100 ft.