WIGTON COAL CO.

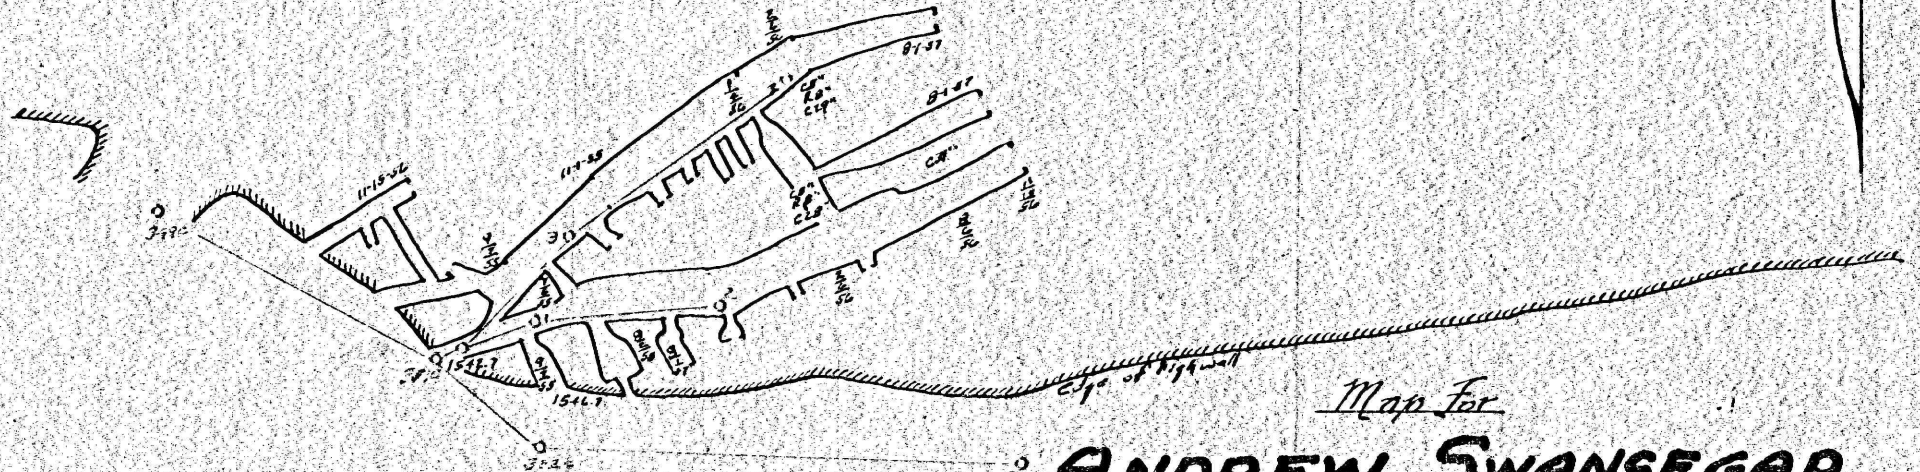

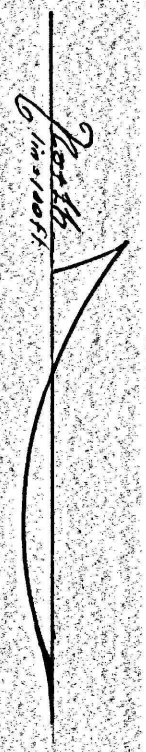

Map For

ANDREW SWANSEGAR

Showing

"C" prime Deep Mine Operation

Morris Township Clearfield Co. Pa.

Scale 1 in = 100 ft.

August 14 1931

E. L. Hoey

D. & S.

82 D.4.