


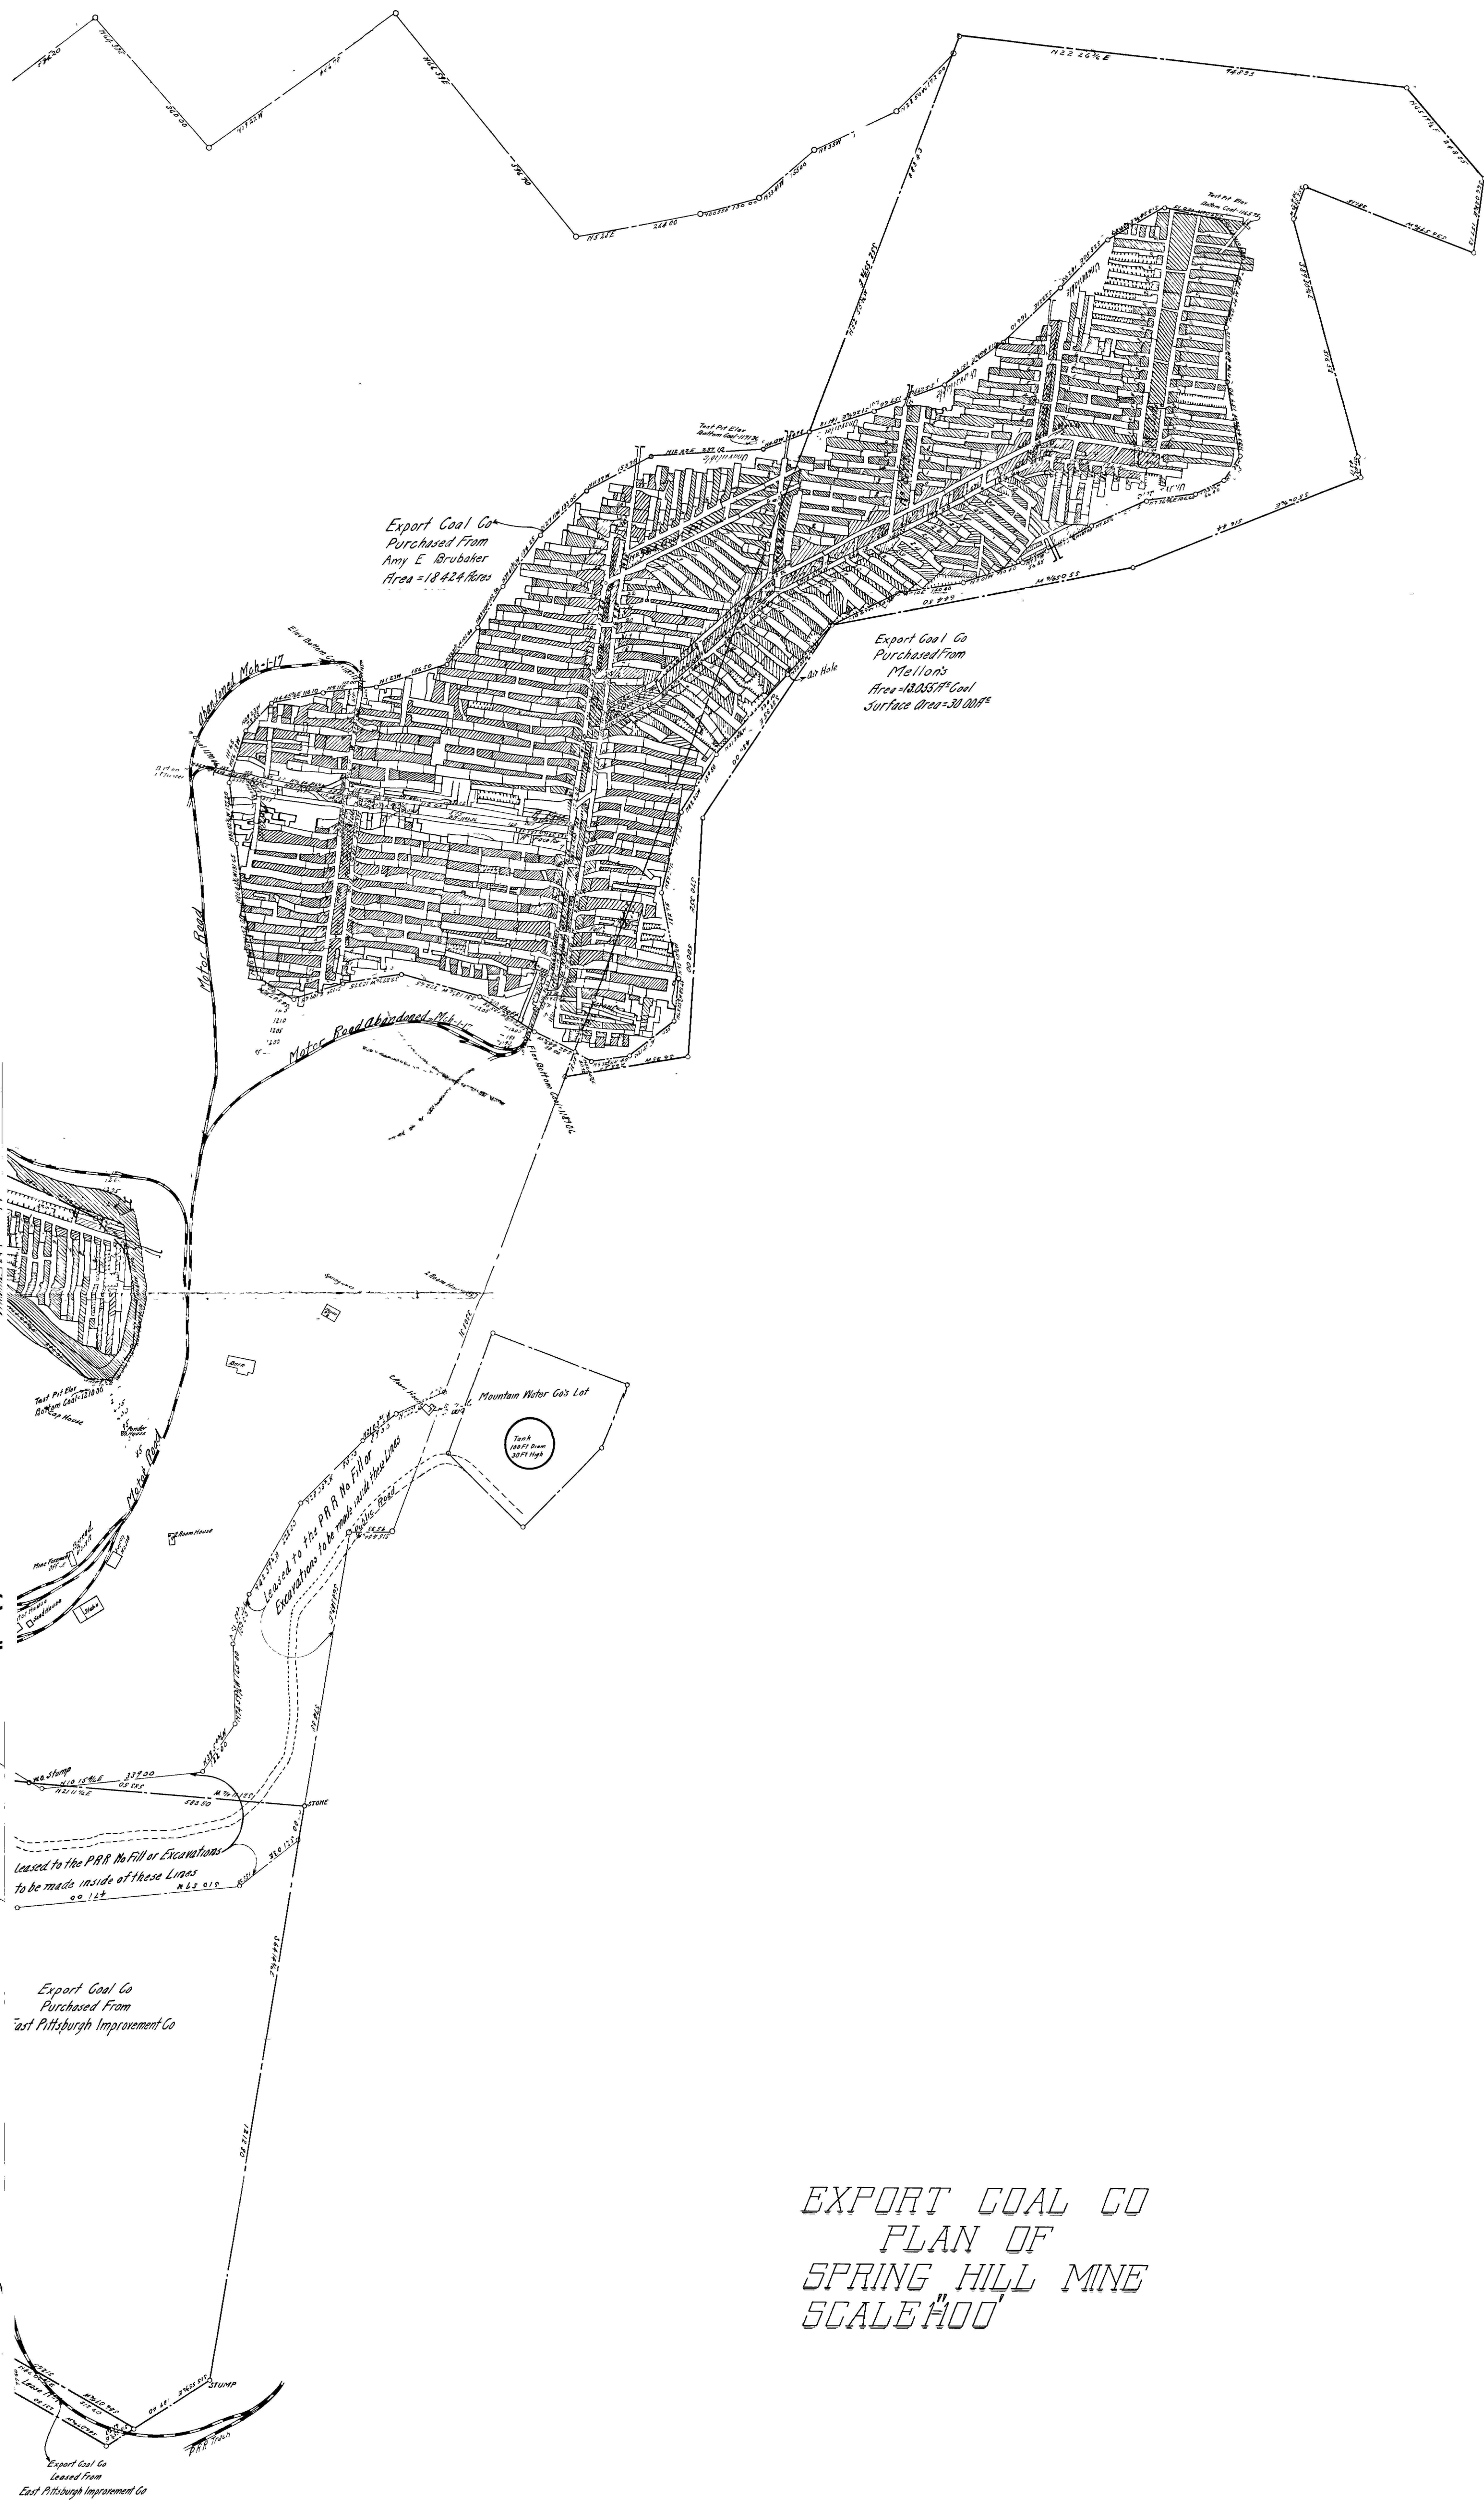

EXPORT COAL CO
PLAN OF
SPRING HILL MINE
SCALE 1"=100'