


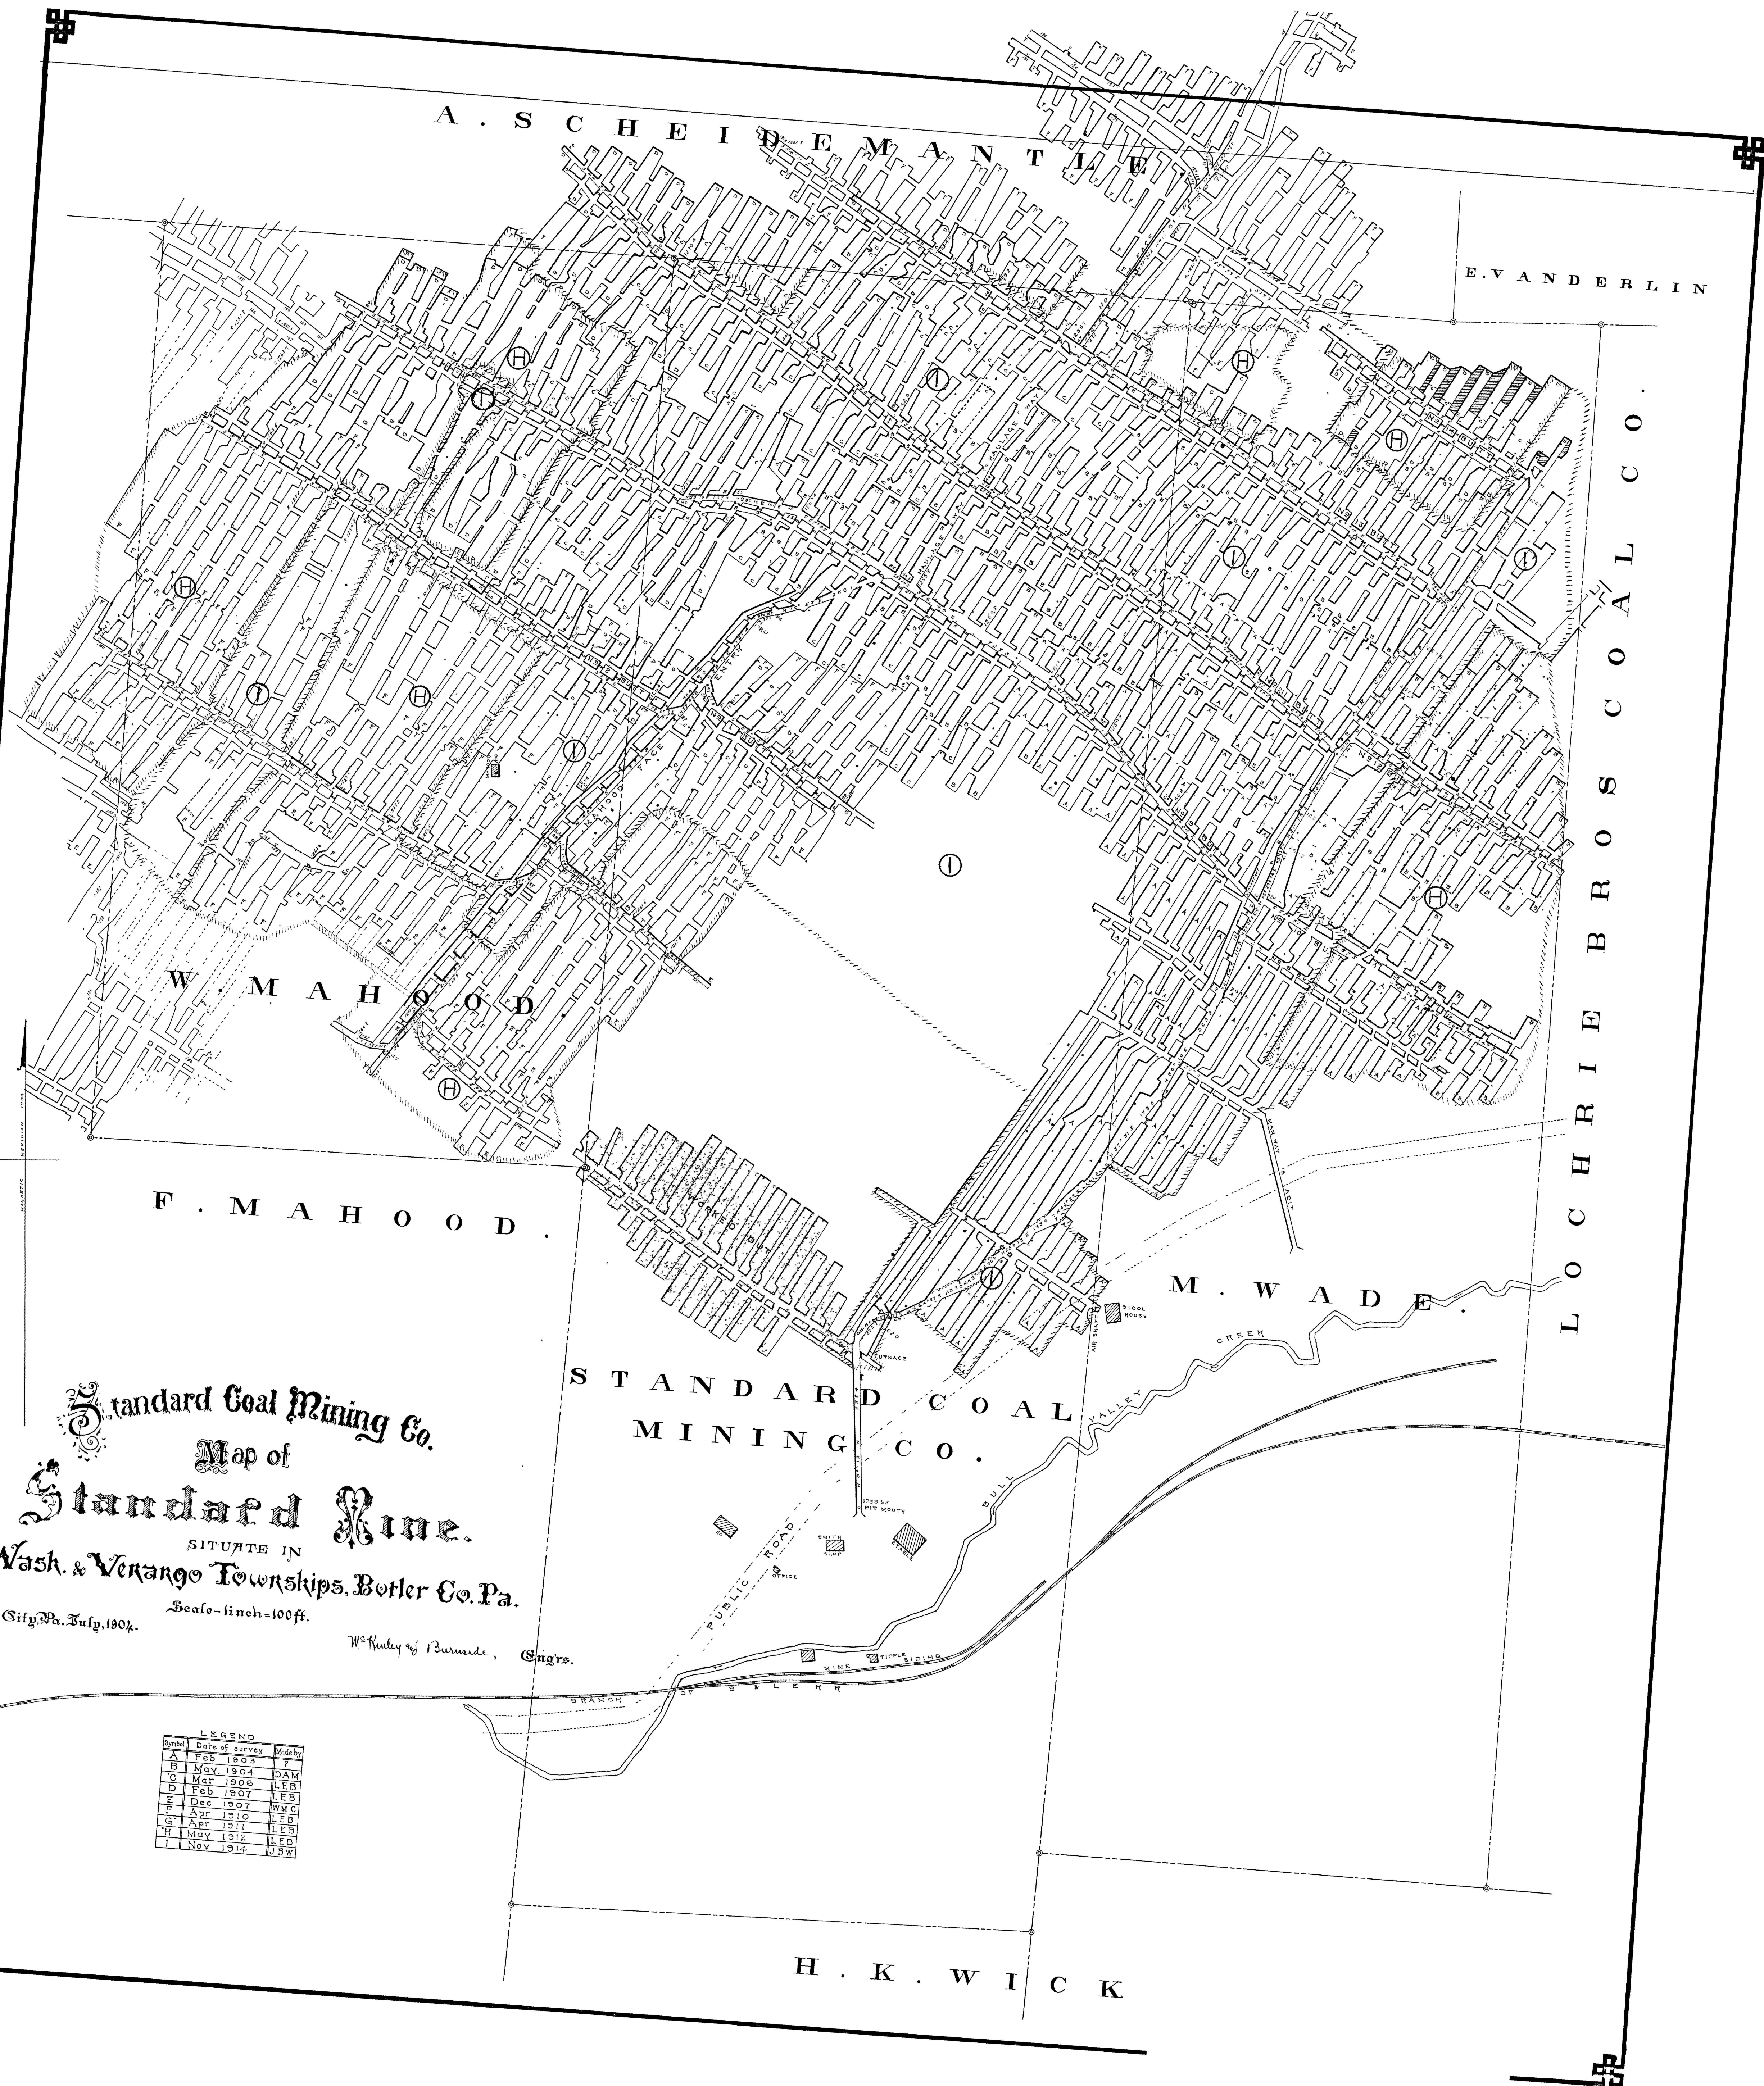

Standard Coal Mining Co.  
Map of  
Standard Mine.  
SITUATE IN  
Wash. & Venango Townships, Butler Co. Pa.

Grove City, Pa. July, 1904.

Scale - 1 inch = 100 ft.

W. R. R. of Butts, Eng'rs.

| Symbol | Date of survey | Machinery |
|--------|----------------|-----------|
| A      | Feb. 1903      | ?         |
| B      | May. 1904      | DAM       |
| C      | Mar. 1906      | LEB       |
| D      | Feb. 1907      | LEB       |
| E      | Dec. 1907      | WMC       |
| F      | Apr. 1910      | LEB       |
| G      | Apr. 1911      | LEB       |
| H      | May. 1912      | LEB       |
| I      | Nov. 1914      | JBW       |