


R O Y L E H E I R S

T . S L O A N
LOCHRIE BROS COAL CO.
COAL LEASE.

E . V A N D E R L I N .
LOCHRIE BROS COAL CO.
COAL LEASE.

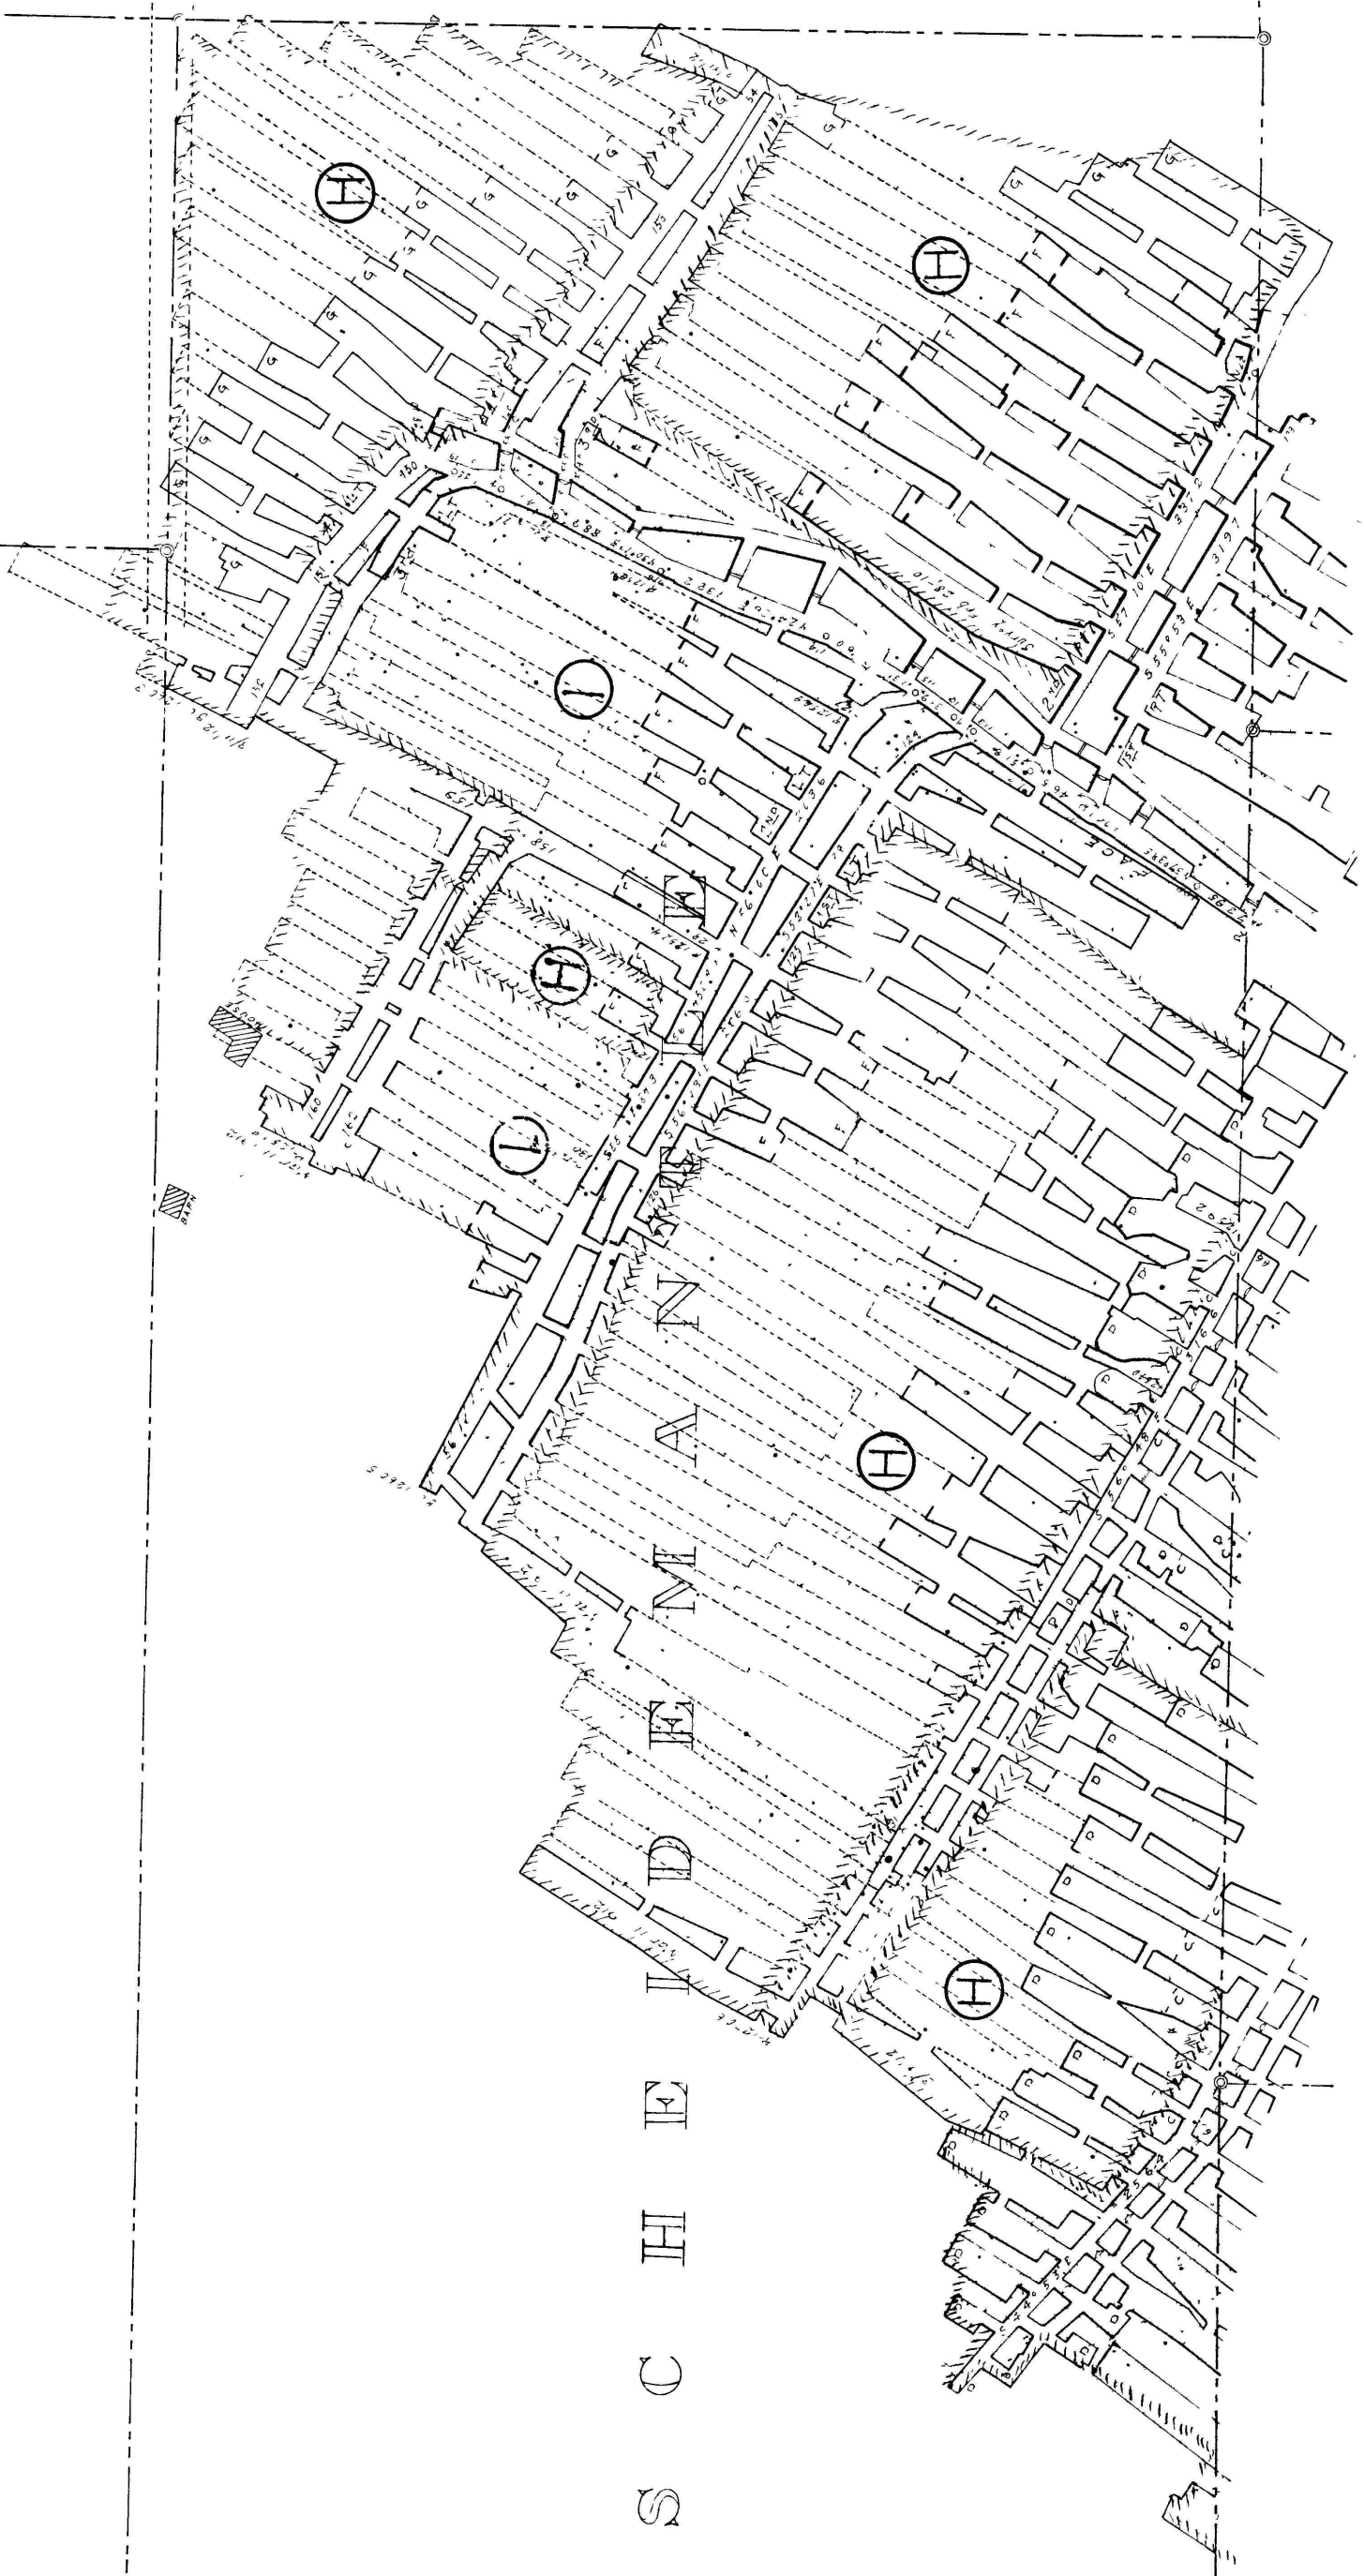

A . S C H E I D E M A N