


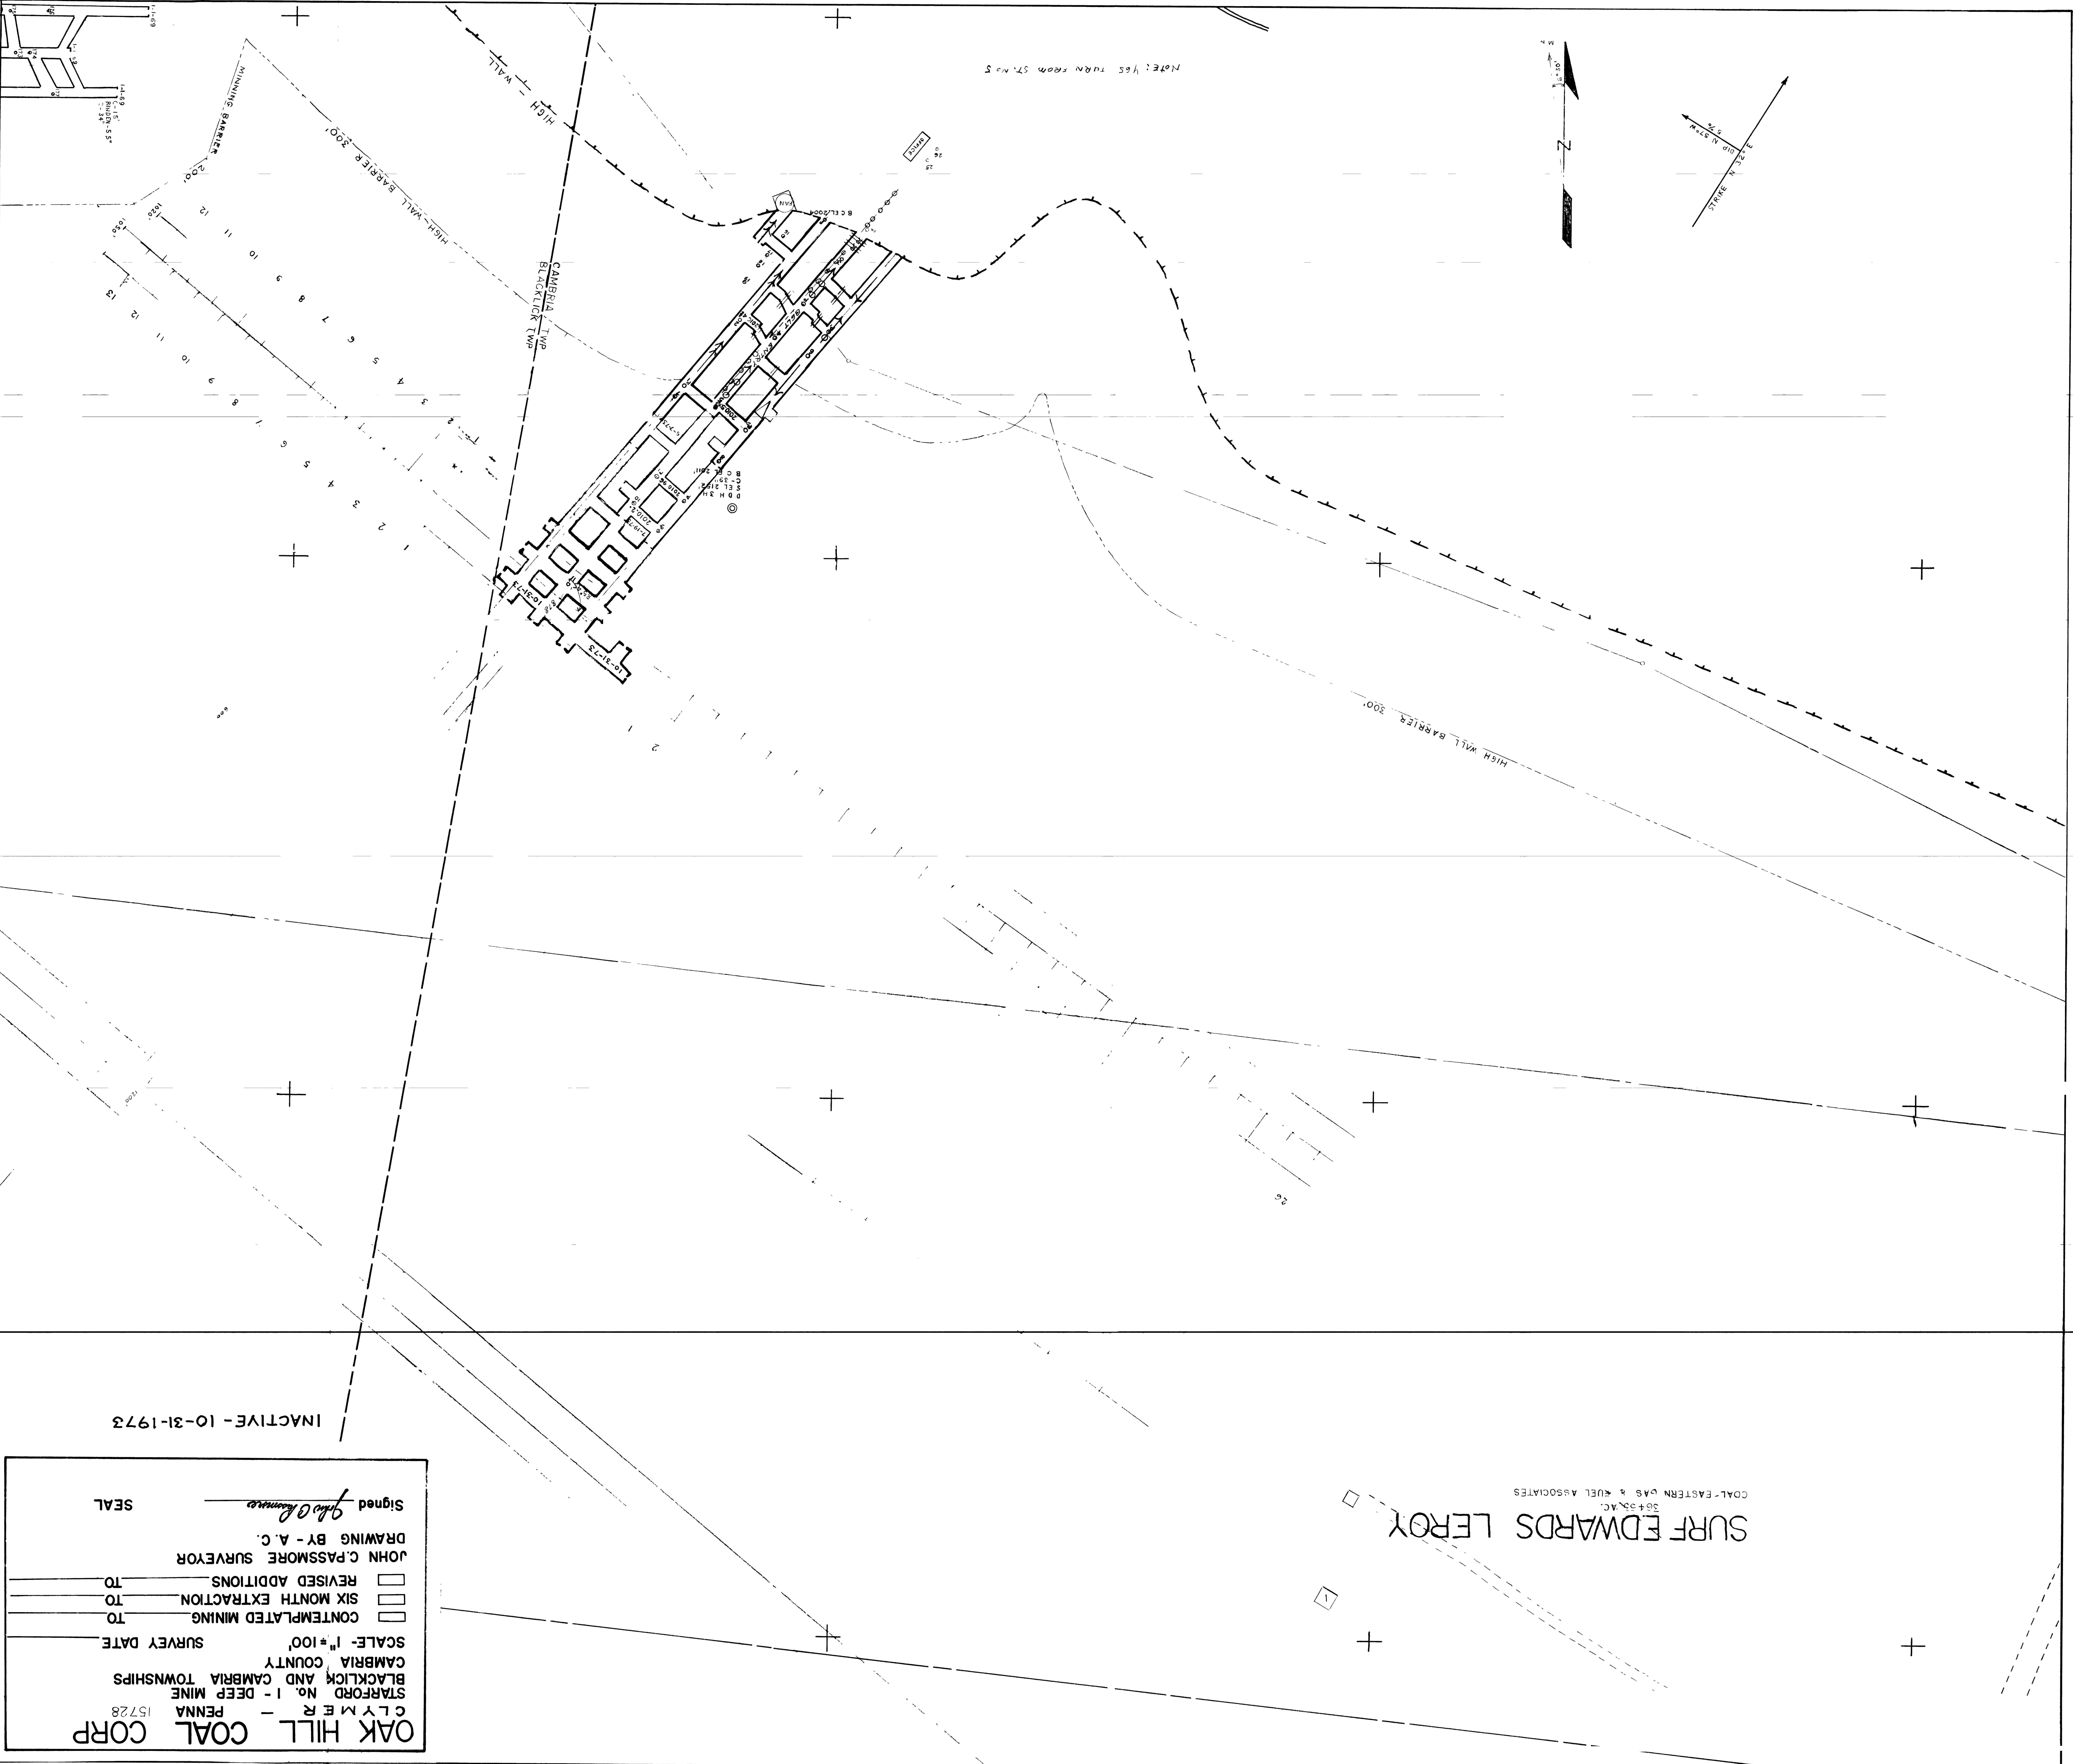

OAK HILL COAL CORP
CLYMER - PENNA 15728
STARFORD No. 1-DEEP MINE
BLACKICK AND CAMBRIA TOWNSHIPS
CAMBRIA COUNTY
SCALE- 1"=100'
SURVEY DATE _____
☐ CONTEMPLATED MINING
TO _____
☐ SIX MONTH EXTRACTION
TO _____
☐ REVISED ADDITIONS
TO _____
DRAWING BY - A.C.
JOHN C. PASSMORE SURVEYOR
Signed *John C. Passmore*
SEAL

SURF EDWARDS LEROY
36+35.4 AC.
COAL-EASTERN COAS & KUEL ASSOCIATES

INACTIVE - 10-31-1973